



BURLINGTON, WIS. 53105

LOT 3 BLOCK 2 ARNOLD'S ADDITION TO THE CITY OF MILWAUKEE, WISCONSIN

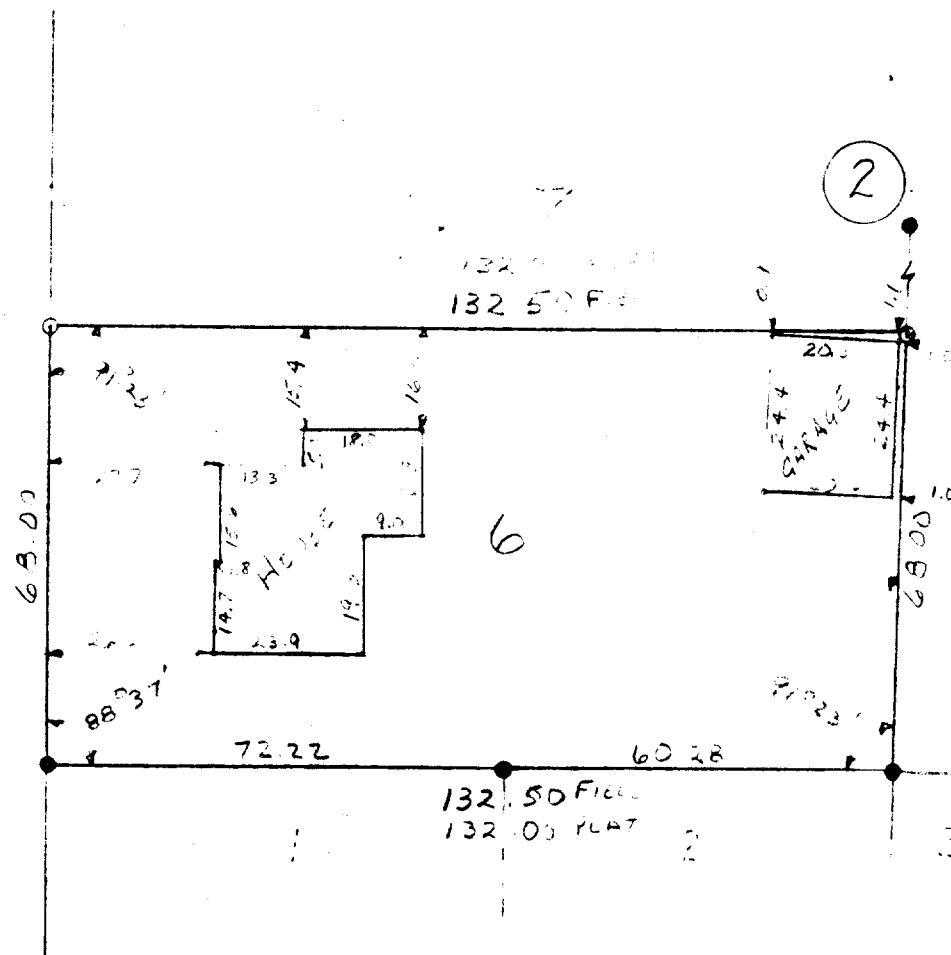

SCALE 1" = 20'

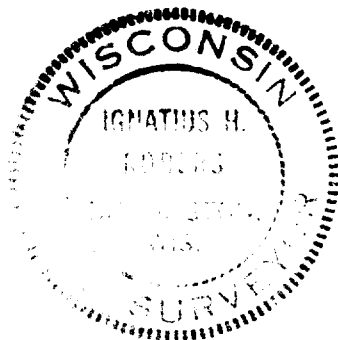

WIS. REG. LAND SURVEYOR

DATE 3-26-73

JOB NO. 73044-1

VAB-13

4-86