
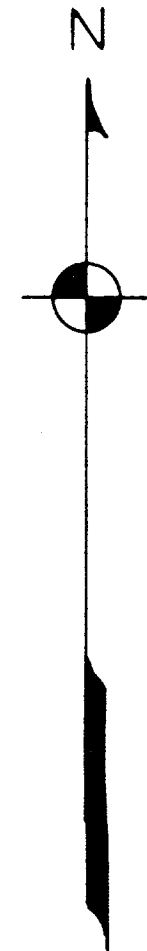


BROAD STREET

WALWORTH STREET

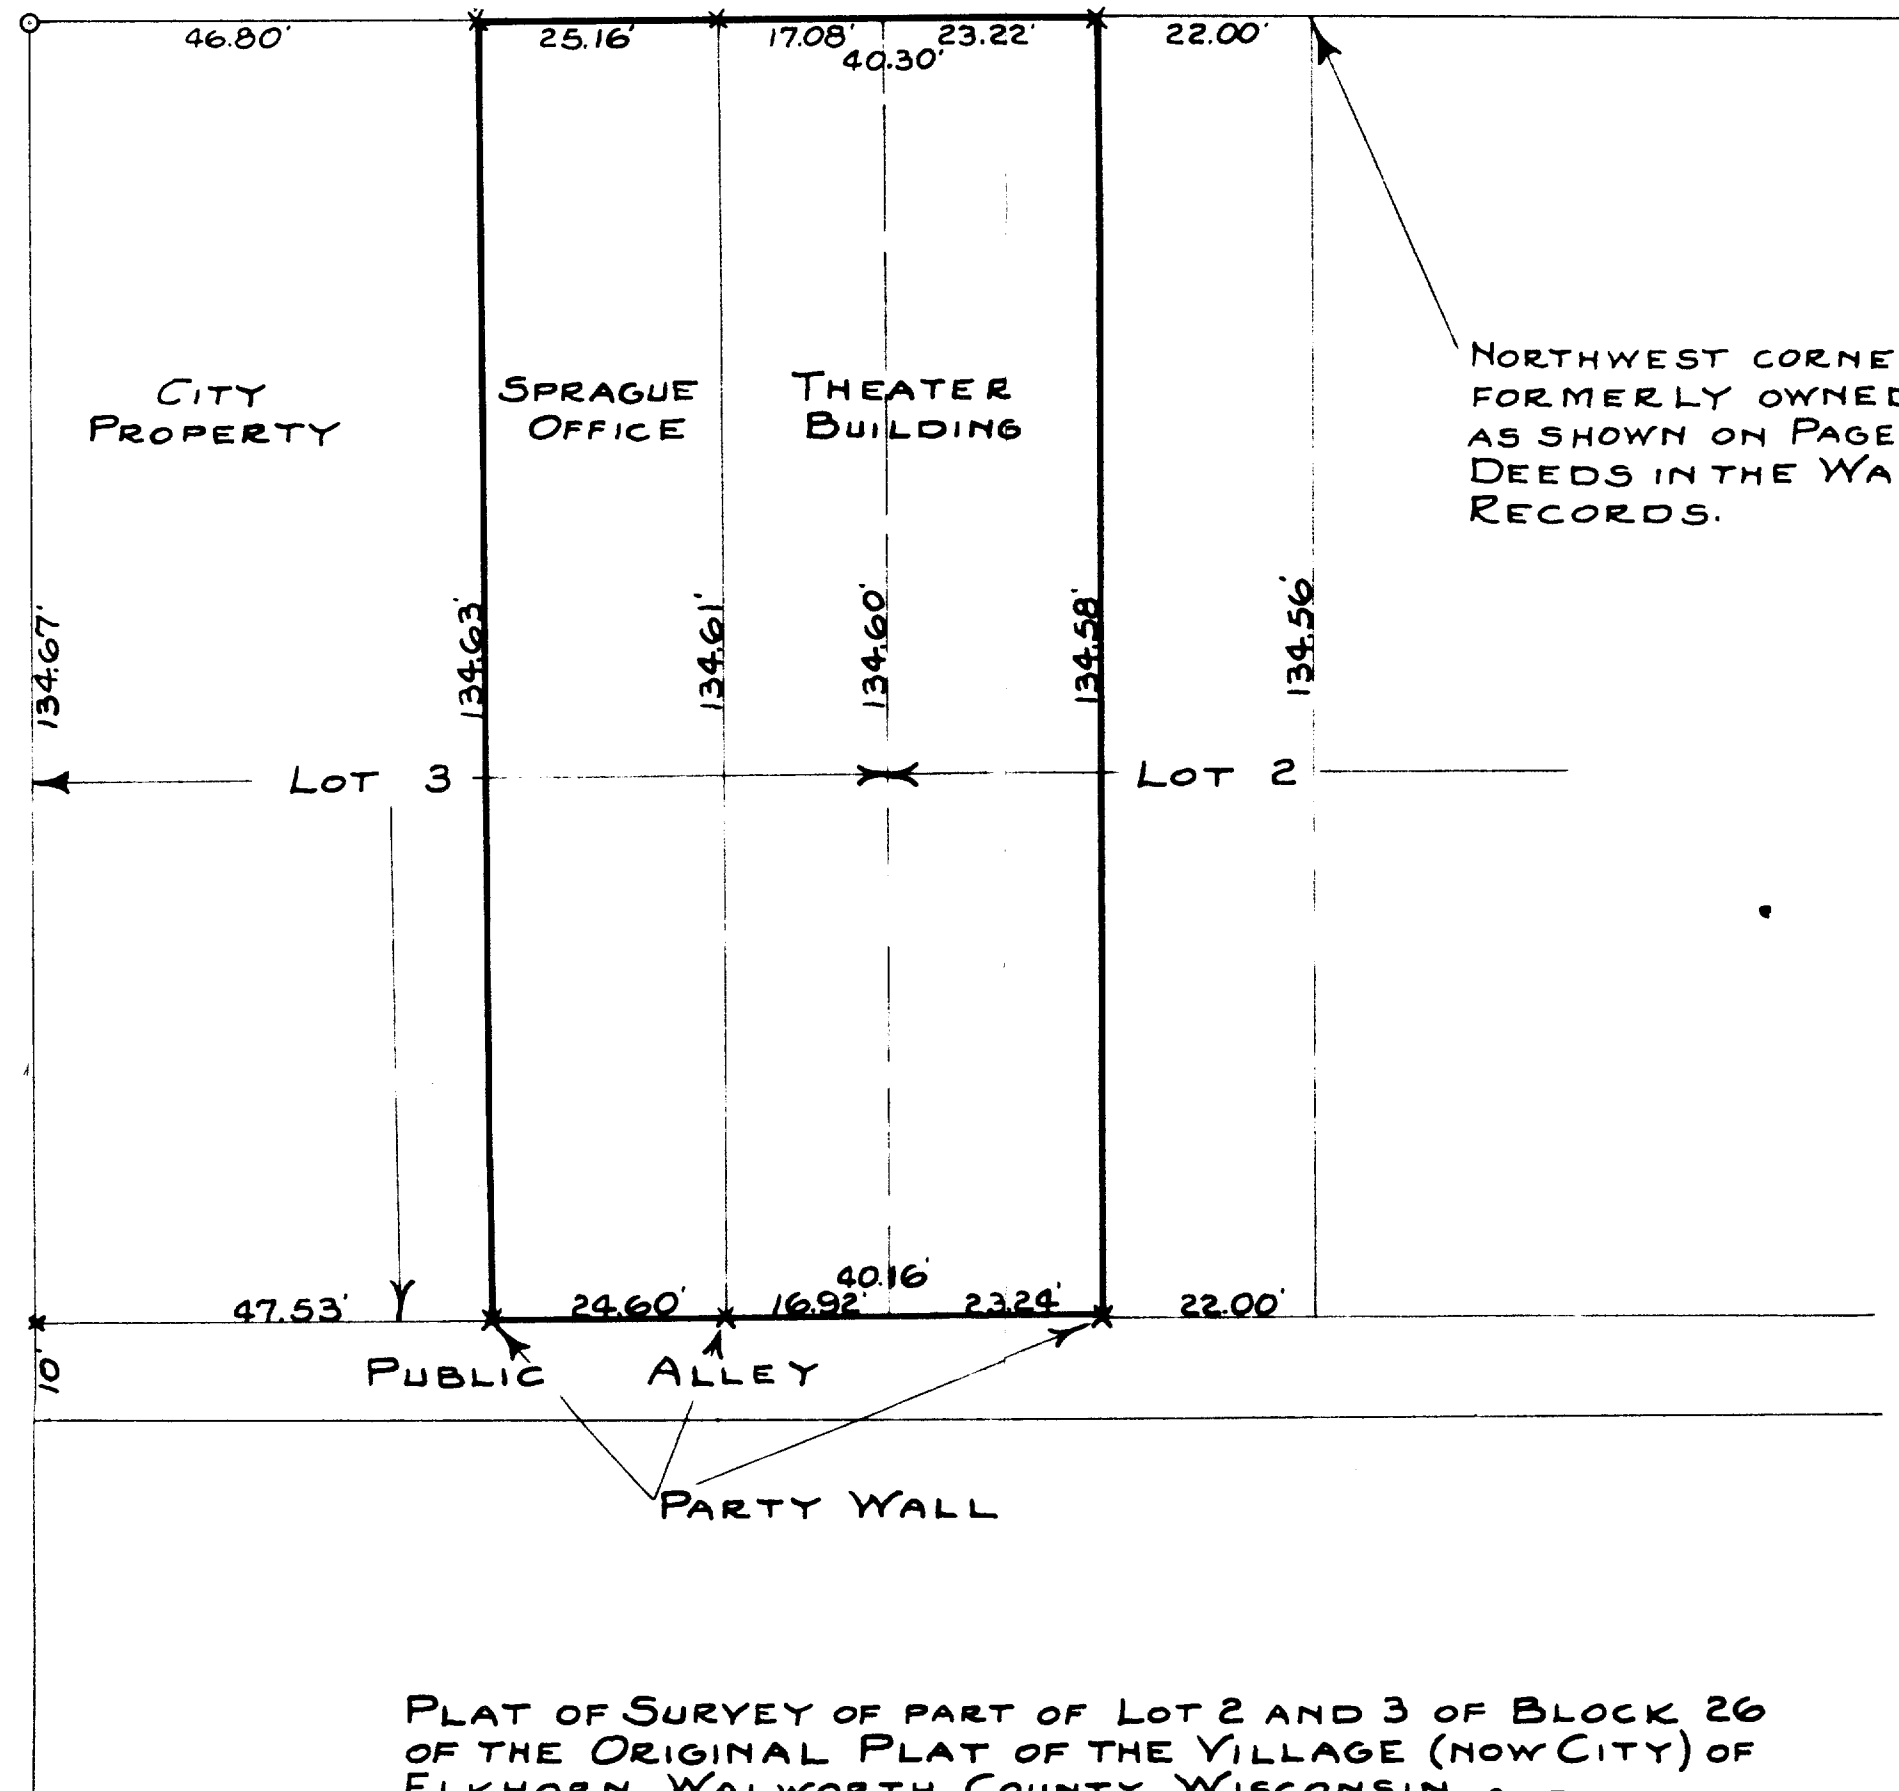

SCALE 1"=20'
O-IRON PIPE
X-CROSS CUT IN CONC.

PLAT OF SURVEY OF PART OF LOT 2 AND 3 OF BLOCK 26
OF THE ORIGINAL PLAT OF THE VILLAGE (NOW CITY) OF
ELKHORN, WALWORTH COUNTY WISCONSIN.

MARCH 1944

Floyd L. Jensen
COUNTY SURVEYOR

OP-226 + 227

4-8J