


Plat of Survey

Survey For: **-JOHN A. SPRAGIA**
Location: **Sandy Lane**

Description LOT 2 in BLOCK 5 in FAIRLANE SUBDIVISION ADD'N NO. 1 being a subdivision of a part of the S.W. 1/4 of the N.W. 1/4 of Section 31, T. 3 N., R. 17 E., in the City of Elkhorn, Walworth County, Wisconsin.

NOTE: BUILDING STAKED 1.0' LARGER &
ELEVATIONS REFER TO CITY DATUM &
B.M. #4 HYD. @ N.W. COR. LINC. & FIRST AVE.
ELEV. 1021.25'

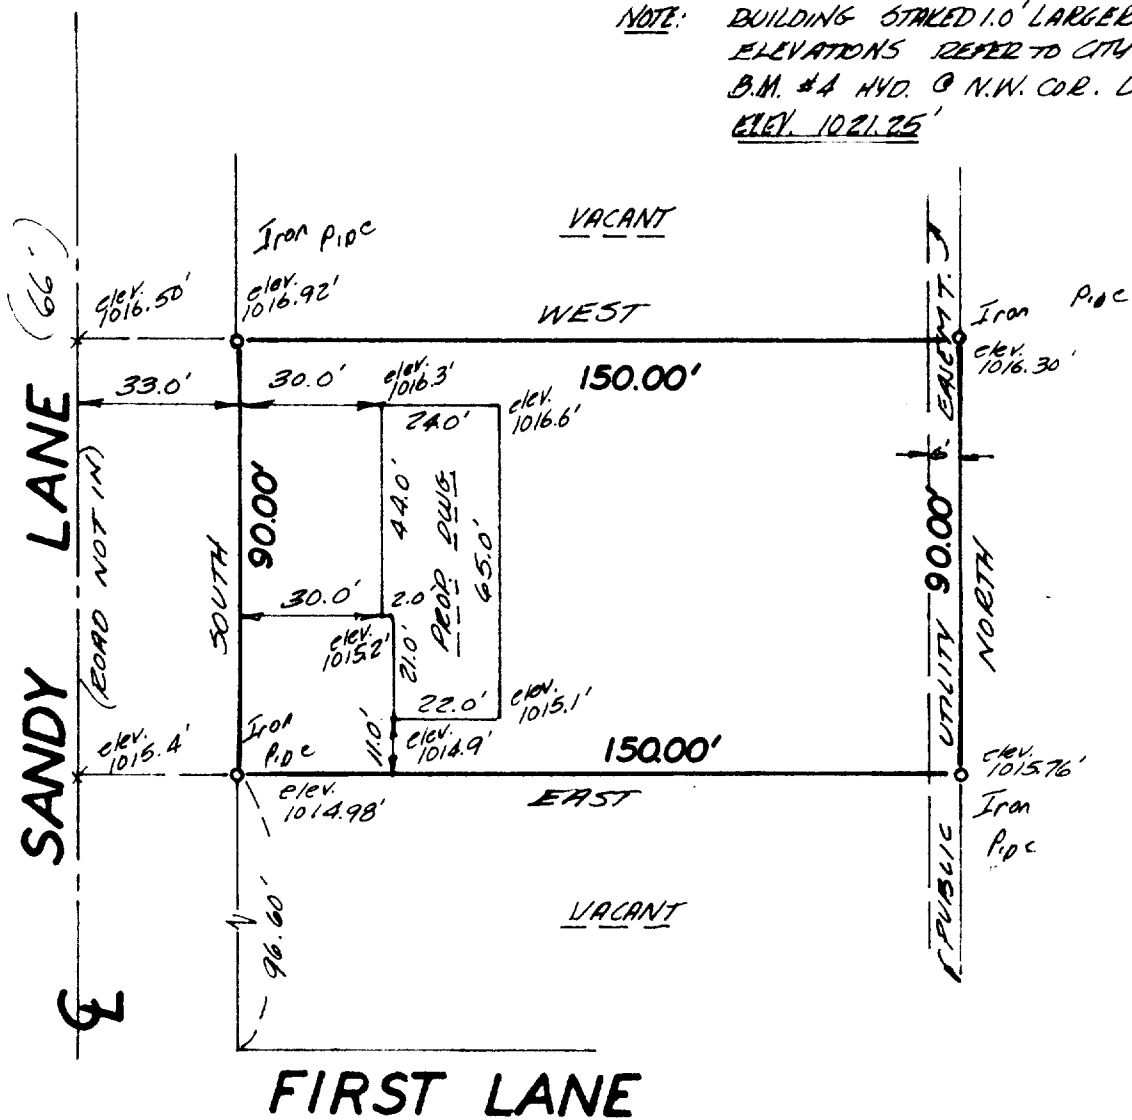

**INMAN ENGINEERING
OF
MILWAUKEE, INC.
ENGINEERS - SURVEYORS**

State of Wisconsin
Milwaukee County, ss. I hereby certify that I have surveyed the above described property, that the above plat is a true representation thereof and correctly shows the exterior boundary lines, location of principal buildings and other visible improvements relative to said boundary lines.

Thomas Ingram, Registered Land Surveyor

Date 7/11/73
Job No 6755

YFLA-20

4-91