
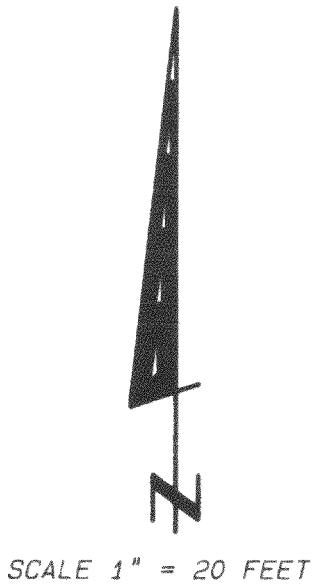


PLAT OF SURVEY

LOT 11 OF BLOCK 10 OF THE
ORIGINAL PLAT TO THE CITY OF
ELKHORN, WALWORTH COUNTY,
WISCONSIN.

OWNER: JERRY BOGACZ
203 N. WISCONSIN
ELKHORN, WI. 53121

NORTH WISCONSIN ST.
66' WIDE

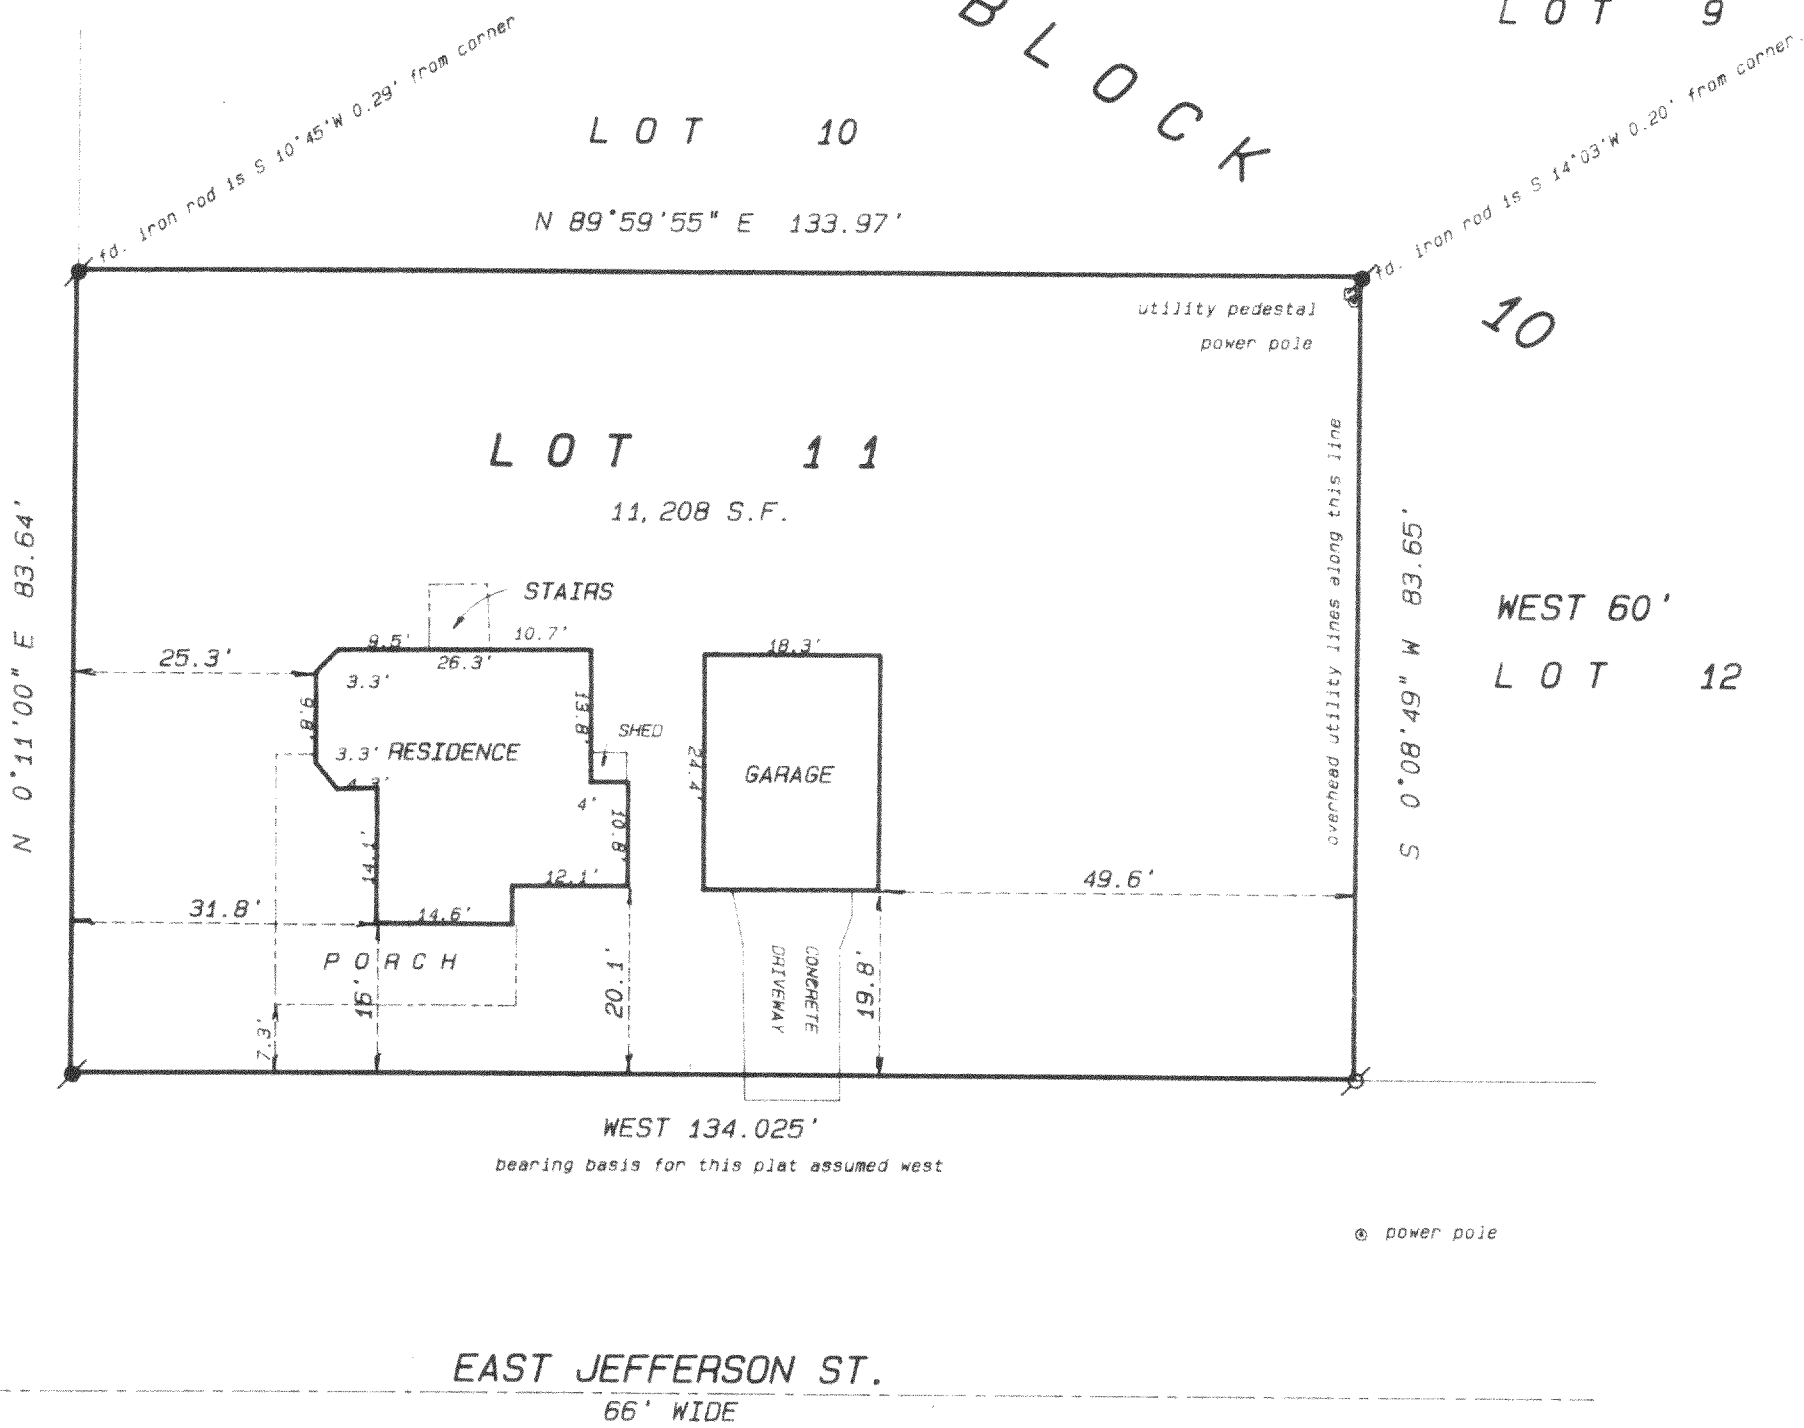

NOTE:
THE ORIGINAL PLAT ON RECORD SHOWS BLOCK 10 AS
BEING 495' NORTH AND SOUTH AND 264' EAST AND WEST
WITH THE LOTS BEING 132' x 82.5'. MR. TUBBS AS
CITY ENGINEER RESURVEYED ELKHORN AND FOUND THE
OVERRUN AND UNDERRUN IN THE BLOCKS AND RECORDED
THE MEASUREMENTS IN THE CITY ENGINEERING RECORDS.


- Legend
- FOUND IRON PIPE
 - FOUND IRON ROD
 - FOUND BRASS CAPPED MONUMENT
 - FOUND CONCRETE MONUMENT
 - CHISEL CUT IN CONCRETE
 - SET IRON ROD, 24" LONG, WEIGHING 1.5 LBS. LINEAL FT., 3/4" DIA.
 - SET IRON ROD, 30" LONG, WEIGHING 4.5 LBS. LINEAL FT., 1-11/16" DIA.
 - RECORDED AS DIMENSION
 - EXISTING FENCE

SCALE: 1"=20 FEET

"I hereby certify that the above described property has been surveyed by me or under my direction and that the above map is a true representation thereof and shows the size and location of the property, its exterior boundaries, the location of all visible structures and dimensions of all principal buildings thereon, boundary fences, apparent easements, roadways and visible encroachments, if any."

"This survey is made for the use of the present owners of the property and also those who purchase, mortgage, or guarantee the title thereto within one year from date hereof."

Kenneth B. Abernathy, Jr.
KENNETH B. ABERNATHY, JR.
WISCONSIN REGISTERED LAND SURVEYOR,
S-1594
Date: 4/11/95 Job No. 95.404

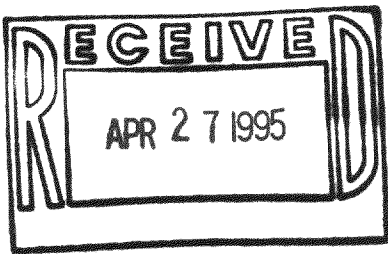

726700

ABERNATHY and ASSOCIATES
Kenneth B. Abernathy Jr.
Wisconsin Registered Land Surveyor S-1594

Rt. 3, Box 273
Elkhorn, Wisconsin 53121
Phone: (414) 723-4260 (office)
(414) 723-7209 (FAX)



19-201

PLAT OF SURVEY

LOT 11 OF BLOCK 10 OF THE
ORIGINAL PLAT TO THE CITY OF
ELKHORN, WALWORTH COUNTY,
WISCONSIN.



OWNER: JERRY BOGACZ
203 N. WISCONSIN
ELKHORN, WI. 53121

NORTH WISCONSIN ST.
66' WIDE

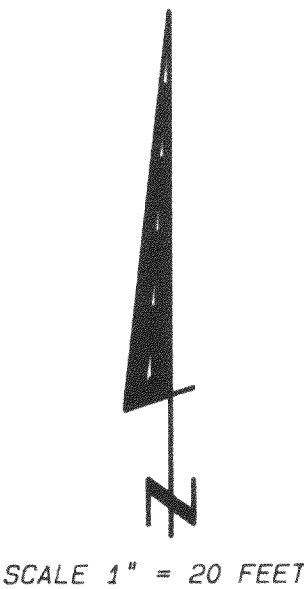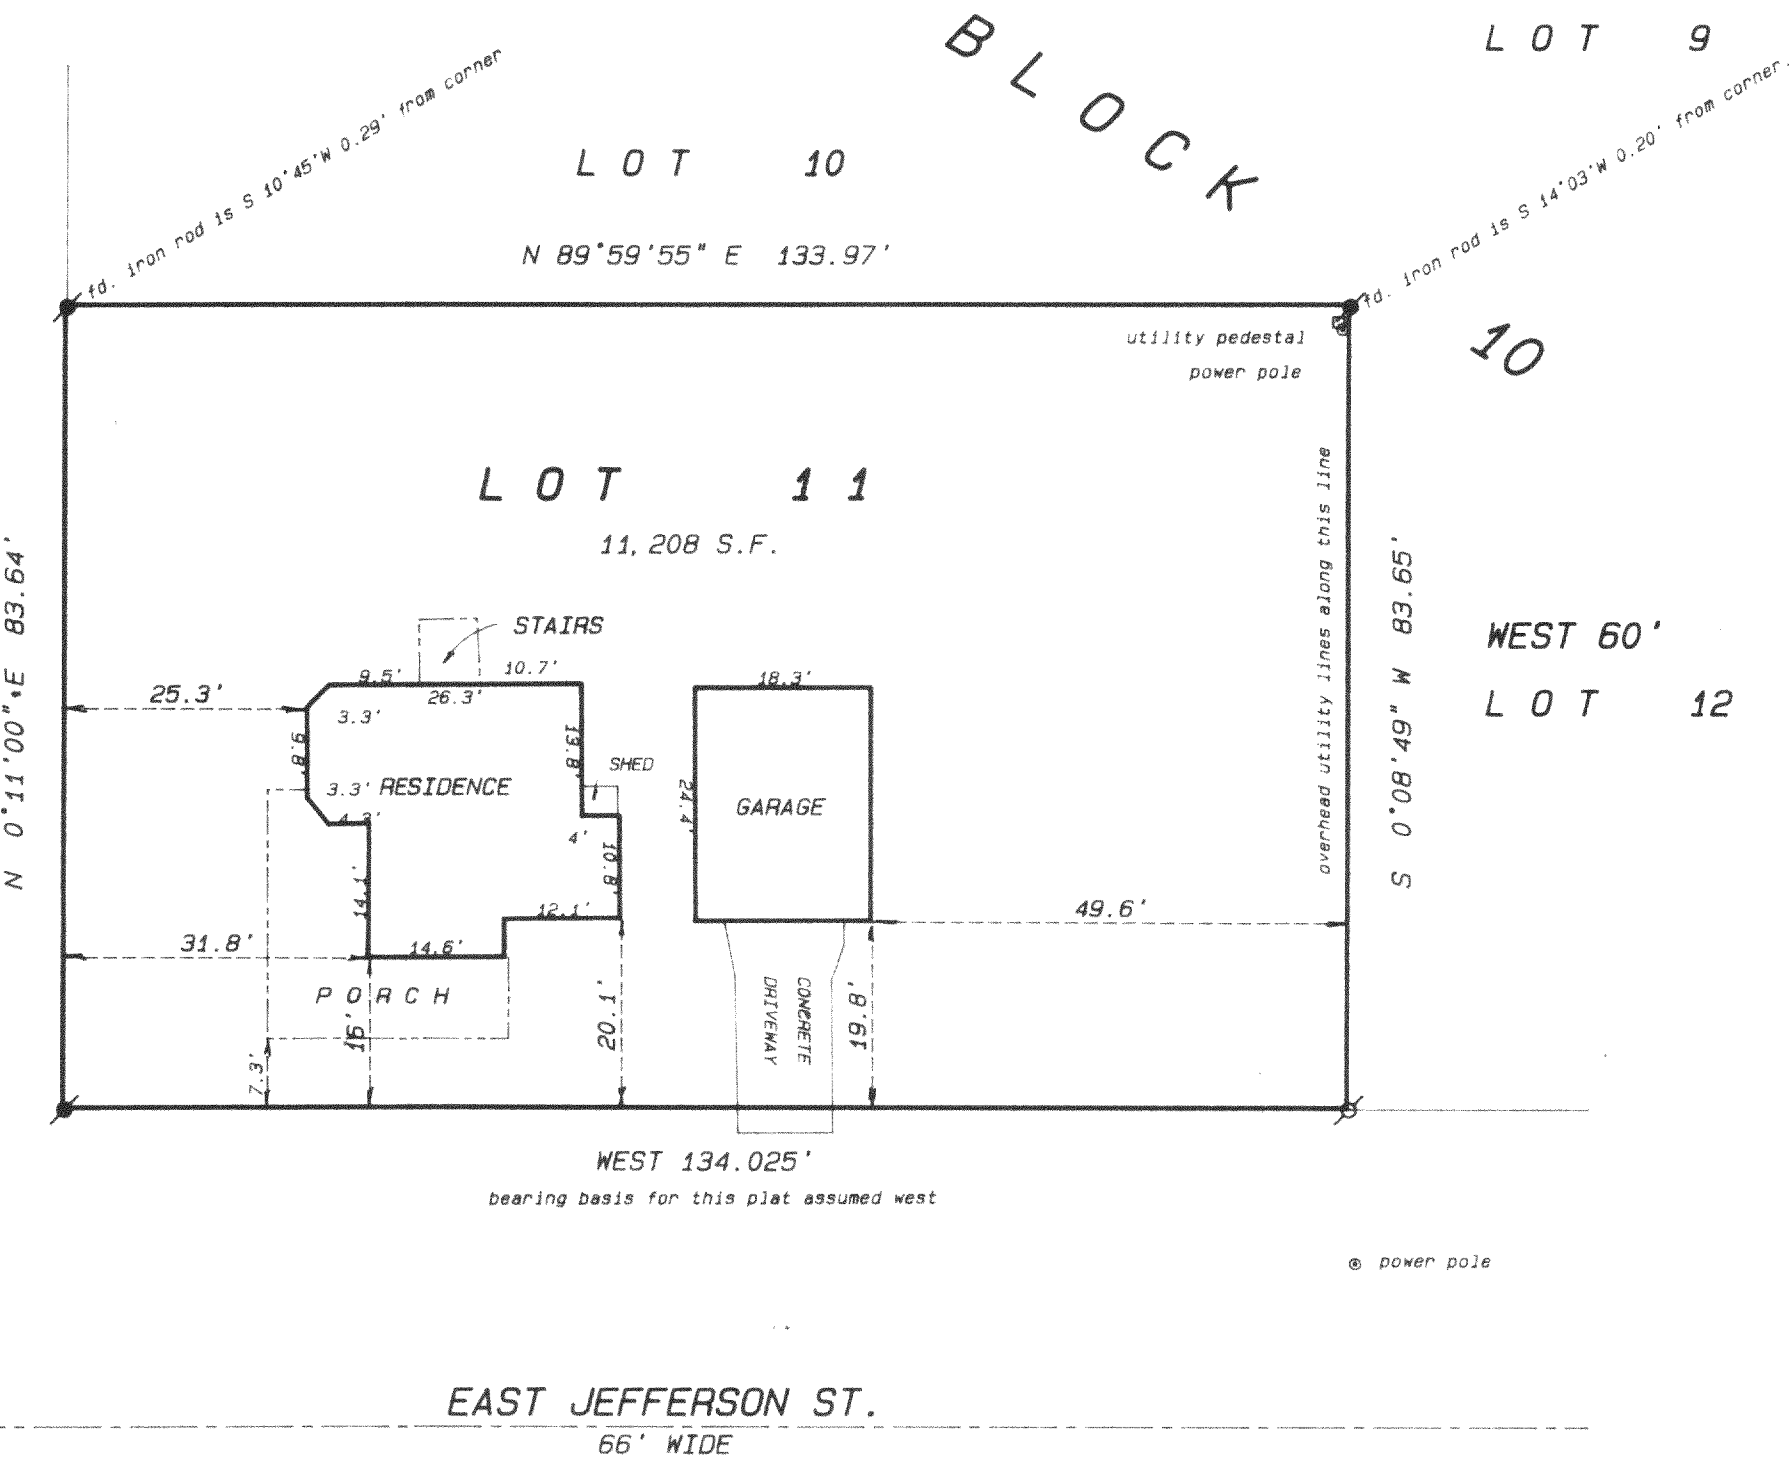

- Legend
- FOUND IRON PIPE
 - FOUND IRON ROD
 - FOUND BRASS CAPPED MONUMENT
 - FOUND CONCRETE MONUMENT
 - CHISEL CUT IN CONCRETE
 - SET IRON ROD, 24" LONG, WEIGHING 1.5 LBS. LINEAL FT., 3/4" DIA.
 - SET IRON ROD, 30" LONG, WEIGHING 4.5 LBS. LINEAL FT., 1-11/16" DIA.
 - RECORDED AS DIMENSION
 - EXISTING FENCE

NOTE:
THE ORIGINAL PLAT ON RECORD SHOWS BLOCK 10 AS BEING 495' NORTH AND SOUTH AND 264' EAST AND WEST WITH THE LOTS BEING 132' x 82.5'. MR. TUBBS AS CITY ENGINEER RESURVEYED ELKHORN AND FOUND THE OVERRUN AND UNDERRUN IN THE BLOCKS AND RECORDED THE MEASUREMENTS IN THE CITY ENGINEERING RECORDS.

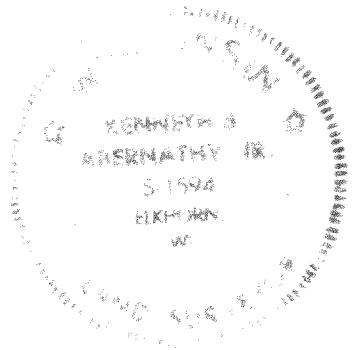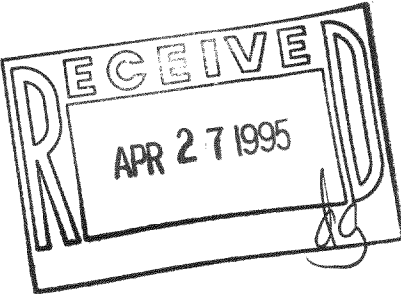

"I hereby certify that the above described property has been surveyed by me or under my direction and that the above map is a true representation thereof and shows the size and location of the property, its exterior boundaries, the location of all visible structures and dimensions of all principal buildings thereon, boundary fences, apparent easements, roadways and visible encroachments, if any."
"This survey is made for the use of the present owners of the property, and also those who purchase, mortgage, or guarantee the title thereto within one year from date hereof."

Kenneth B. Abernathy, Jr.
KENNETH B. ABERNATHY, JR.
WISCONSIN REGISTERED LAND SURVEYOR,
S-1594
Date: 4/11/95 Job No. 95.404

SCALE: 1"=20 FEET