


PLAT OF SURVEY

LOT 40 OF URBANDALE SUBDIVISION,
LOCATED IN THE SE 1/4 AND SW 1/4
OF THE NW 1/4, AND THE SW 1/4 OF
THE NE 1/4 ALL IN SECTION 1, T.2
N., R. 16 E., CITY OF ELKHORN,
WALWORTH COUNTY, WISCONSIN.

*ORDERED BY: PREFERRED HOMES
2903 BORG ROAD
DELAVAN, WI. 53115*

JOB REF. NO. 129.1522

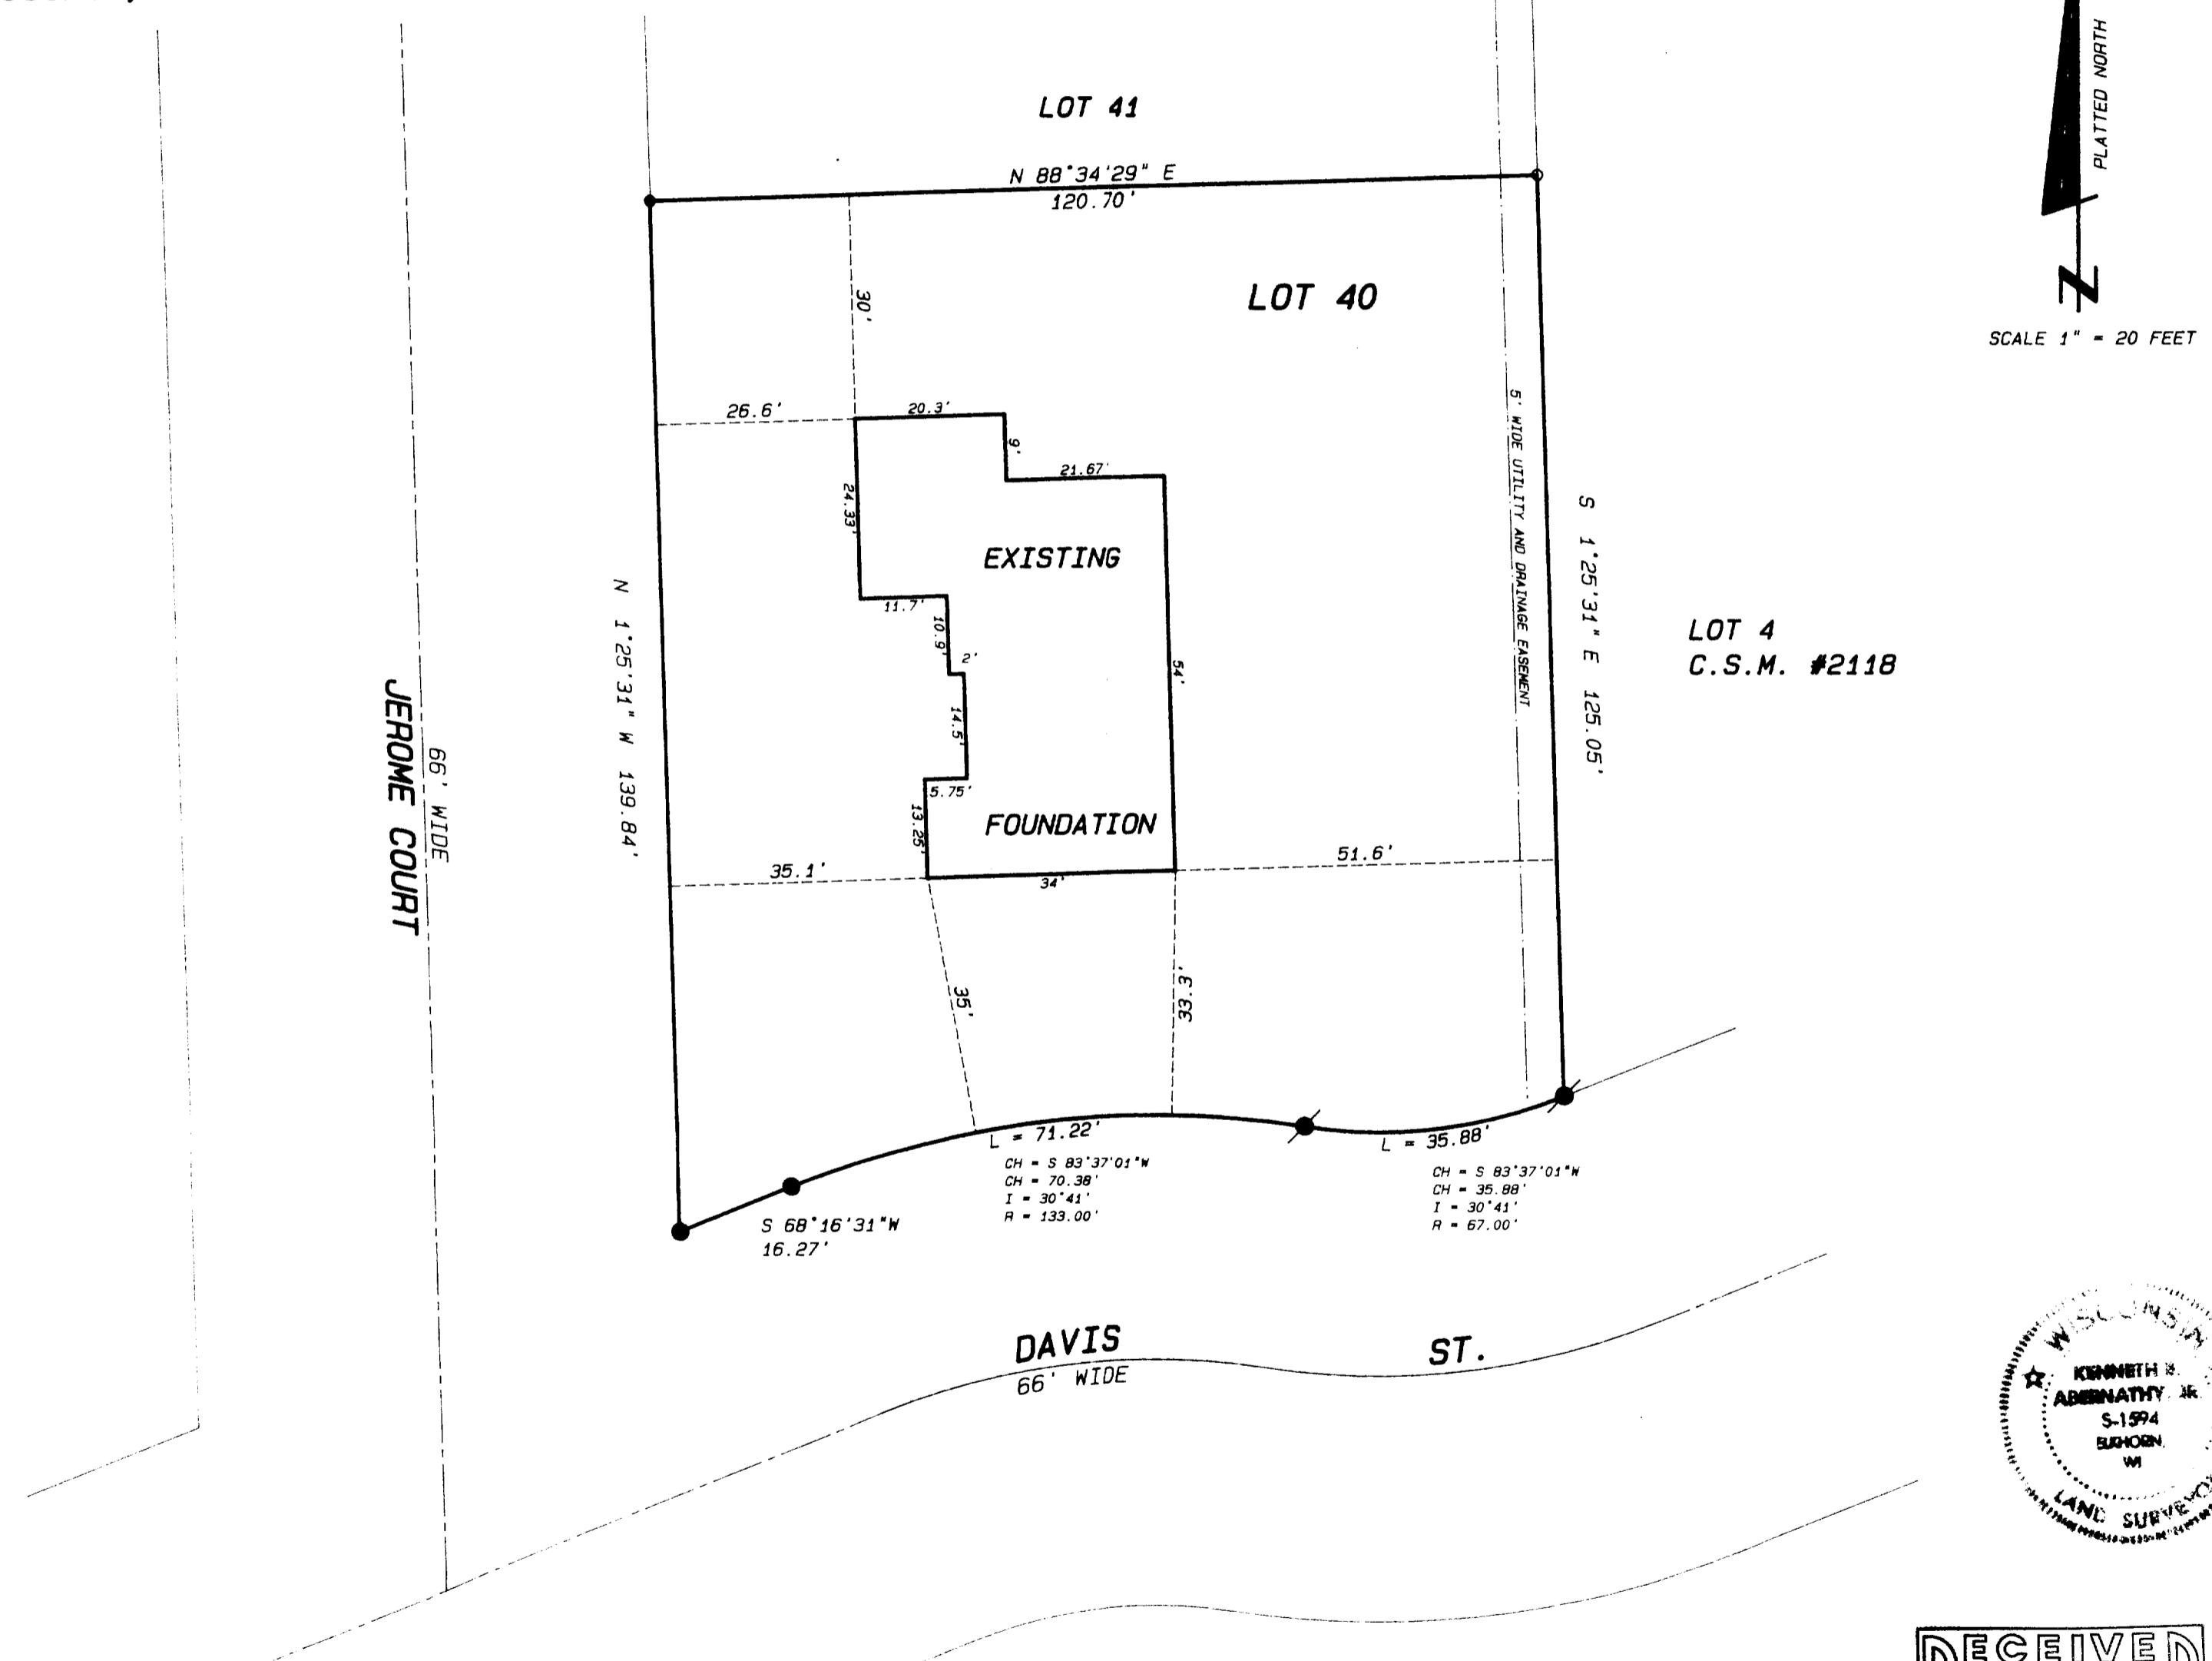

" AS BUILT " LOCATED 6/8/93



"I hereby certify that the above described property has been surveyed by me or under my direction and that the above map is a true representation thereof and shows the size and location of the property, its exterior boundaries, the location of all visible structures and dimensions of all principal buildings thereon, boundary fences, apparent easements, roadways and visible encroachments, if any."

"This survey is made for the use of the present owners of the property and also those who purchase, mortgage or guarantee the title thereto within one year from date hereof."

KENNETH B. ABERNATHY, JR.
WISCONSIN REGISTERED LAND SURVEYOR,
S-1594

Date: MAY 9, 1995 Job No. 95,505

939

ABERNATHY and ASSOCIATES

Kenneth B. Abernathy Jr.

Wisconsin Registered Land Surveyor S-1594

Rt. 3, Box 273
Elkhorn, Wisconsin 53121
Phone: (414) 723-4260 (office)
(414) 723-7209 (FAX)

PLAT OF SURVEY

LOT 40 OF URBANDALE SUBDIVISION,
LOCATED IN THE SE 1/4 AND SW 1/4
OF THE NW 1/4, AND THE SW 1/4 OF
THE NE 1/4 ALL IN SECTION 1, T.2
N., R.16 E., CITY OF ELKHORN,
WALWORTH COUNTY, WISCONSIN.

ORDERED BY: PREFERRED HOMES
2903 BORG ROAD
DELAVAL, WI. 53115

JOB REF. NO. 129.1522




SCALE 1" = 20 FEET

WOOD STAKES HAVE BEEN PLACED AT BUILDING CORNERS.
BUILDER IS TO VERIFY DIMENSIONS TO INSURE PROPER
PLAN INTERPRETATION AND CONTACT THIS OFFICE
IMMEDIATELY IF ANY DISCREPANCY EXISTS.

TOP OF STAKE ELEV. = 992.5
TOP OF CURB ELEV. 993.6 proposed


POINTS MARKED "A" AND "B" WERE
UNDER WATER THE DAY THE PARCEL
WAS SURVEYED AND THE PROPOSED
RESIDENCE STAKED OUT AND WERE
BELIEVED TO HAVE BEEN TORN OUT.
THEY WILL BE RESET DURING THE "AS
BUILT" LOCATION.

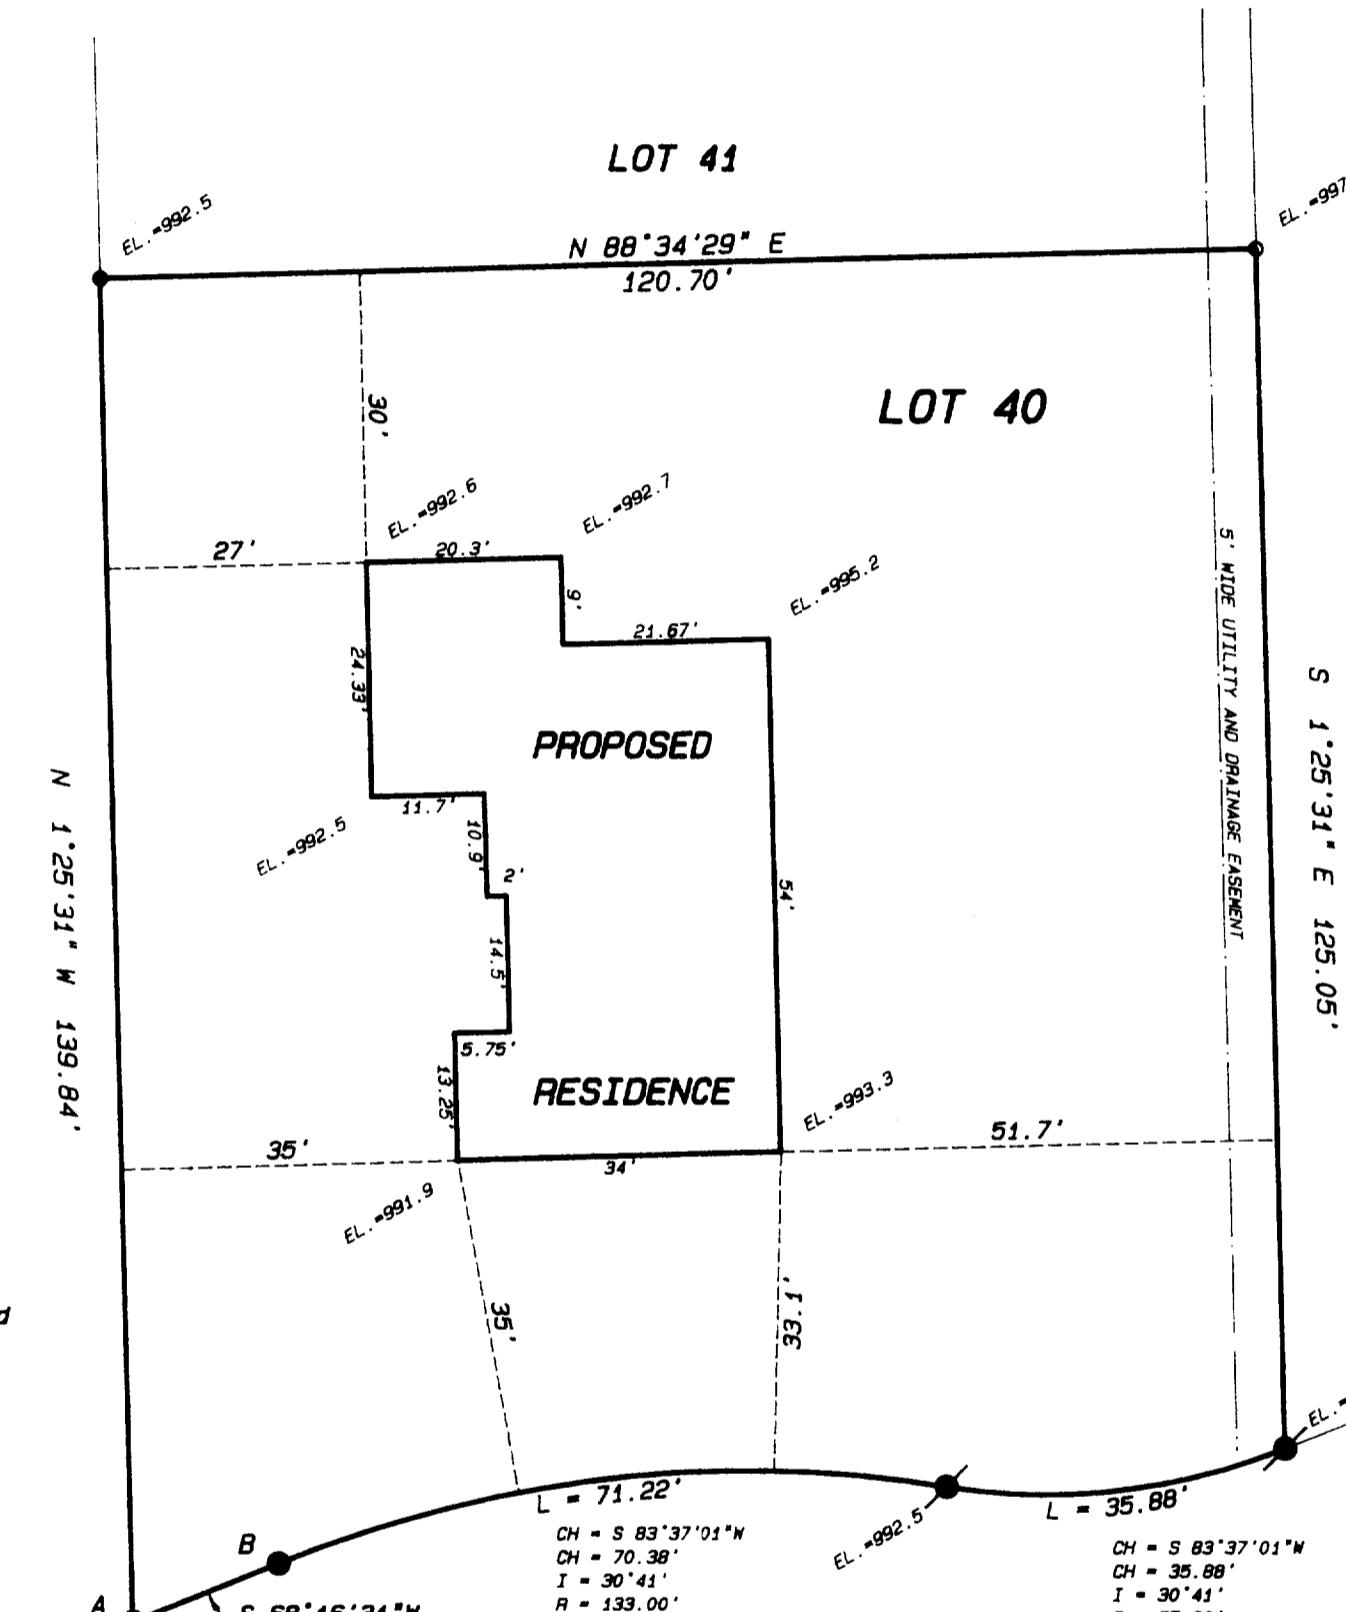

ELEVATIONS ARE REFERENCED TO THE TOP NUT OF A FIRE
HYDRANT LOCATED AT DEVENDORF AND DAVIS STREET
ELEVATION = 1001.64'.

Legend


- FOUND IRON PIPE
- FOUND IRON ROD
- FOUND BRASS CAPPED MONUMENT
- FOUND CONCRETE MONUMENT
- CHISEL CUT IN CONCRETE
- SET IRON ROD, 24" LONG, WEIGHING 1.5 LBS./LINEAL FT., 3/4" DIA.
- SET IRON ROD, 30" LONG, WEIGHING 4.5 LBS./LINEAL FT., 1-11/16" DIA.
- (xx) RECORDED AS DIMENSION
- EXISTING FENCE

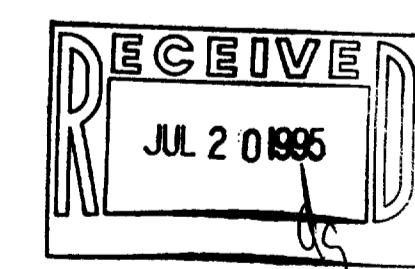

SCALE: 1" = 20 FEET

"I hereby certify that the above described property has been surveyed
by me or under my direction and that the above map is a true
representation thereof and shows the size and location of the property, its
exterior boundaries, the location of all visible structures and dimensions of
all principal buildings, the location of all boundaries, fences, apparent easements,
roads and visible encroachments, if any."

"This survey is made for the use of the present owners of the property,
and also those who purchase, mortgage, or guarantee the title thereto within
one year from date hereof."

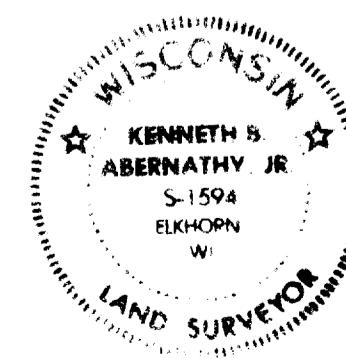

KENNETH B. ABERNATHY, JR.
WISCONSIN REGISTERED LAND SURVEYOR,
S-1594
Date: MAY 9, 1995 Job No. 96505

004-939