

H0-13A

4-93B

WEST ROCKWELL STREET

DESCRIPTION:



The south 50.00 feet of the west 66.00 feet of Lot 2
Block 2 Hodges Addition to the City of Elkhorn, Walworth
County, Wisconsin.

CERTIFICATE:

I, Carl Elfstrom, surveyor do hereby certify that I,
have surveyed the property hereon described.

April 22nd 1968.

Carl Elfstrom S-903
Elkhorn, Wisconsin.

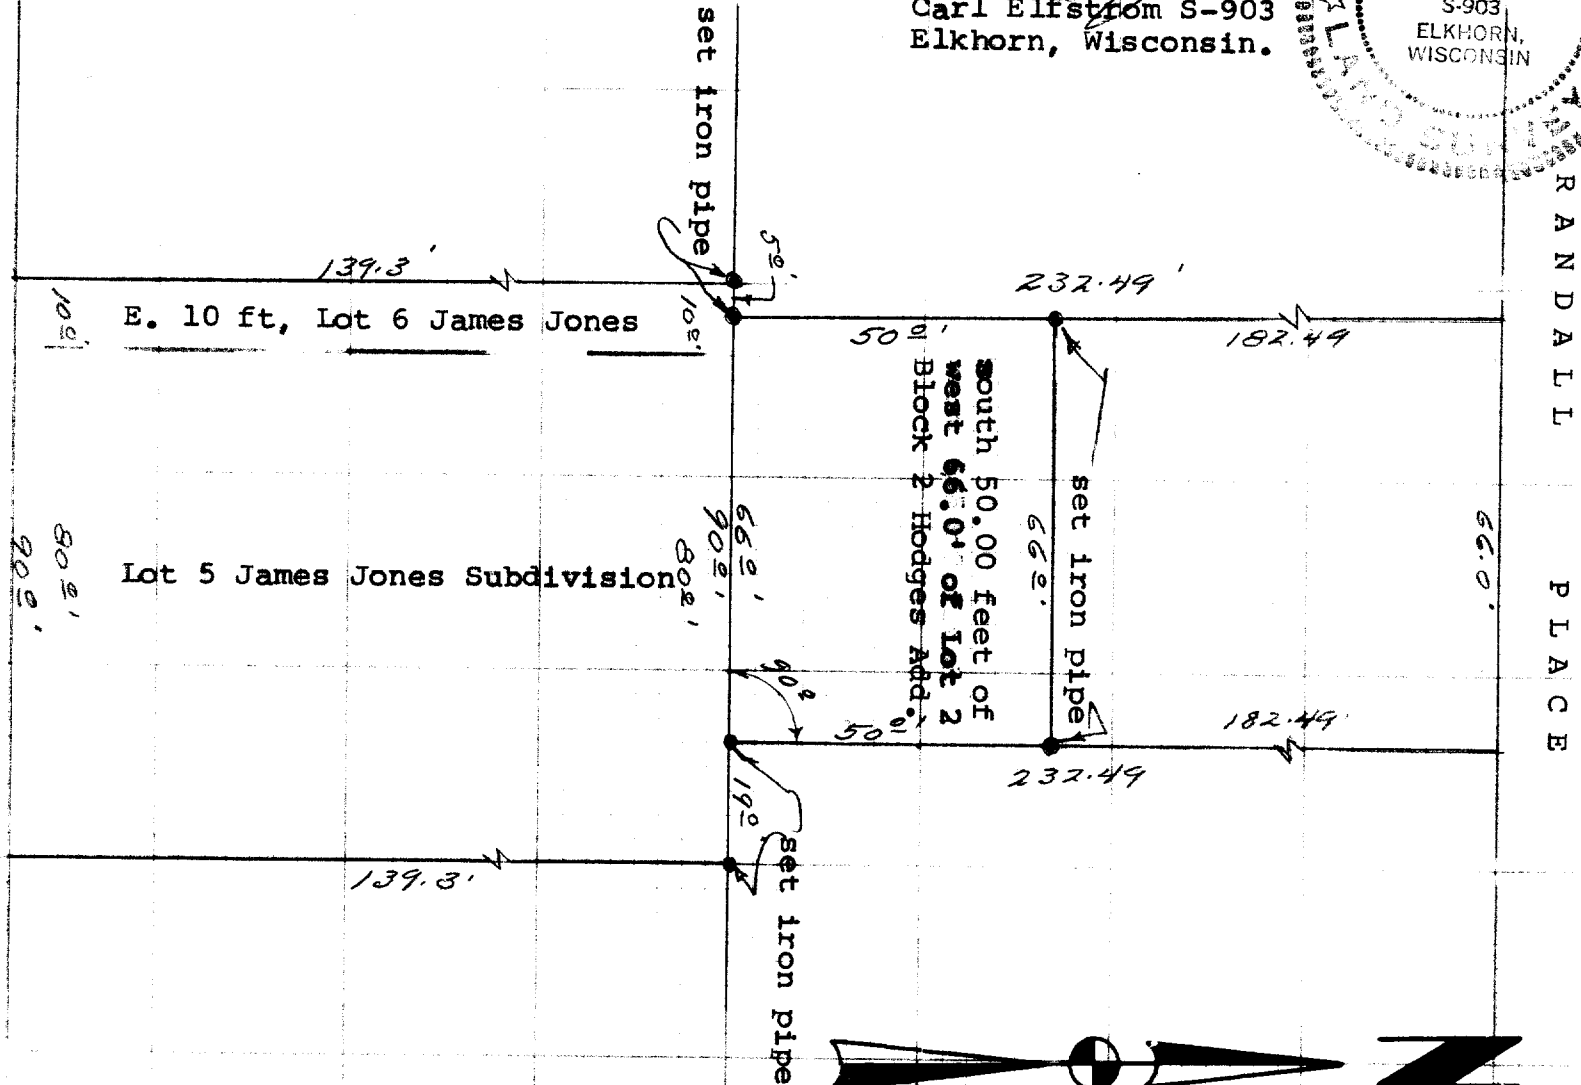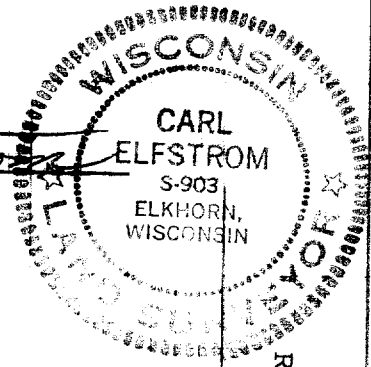

39-68