


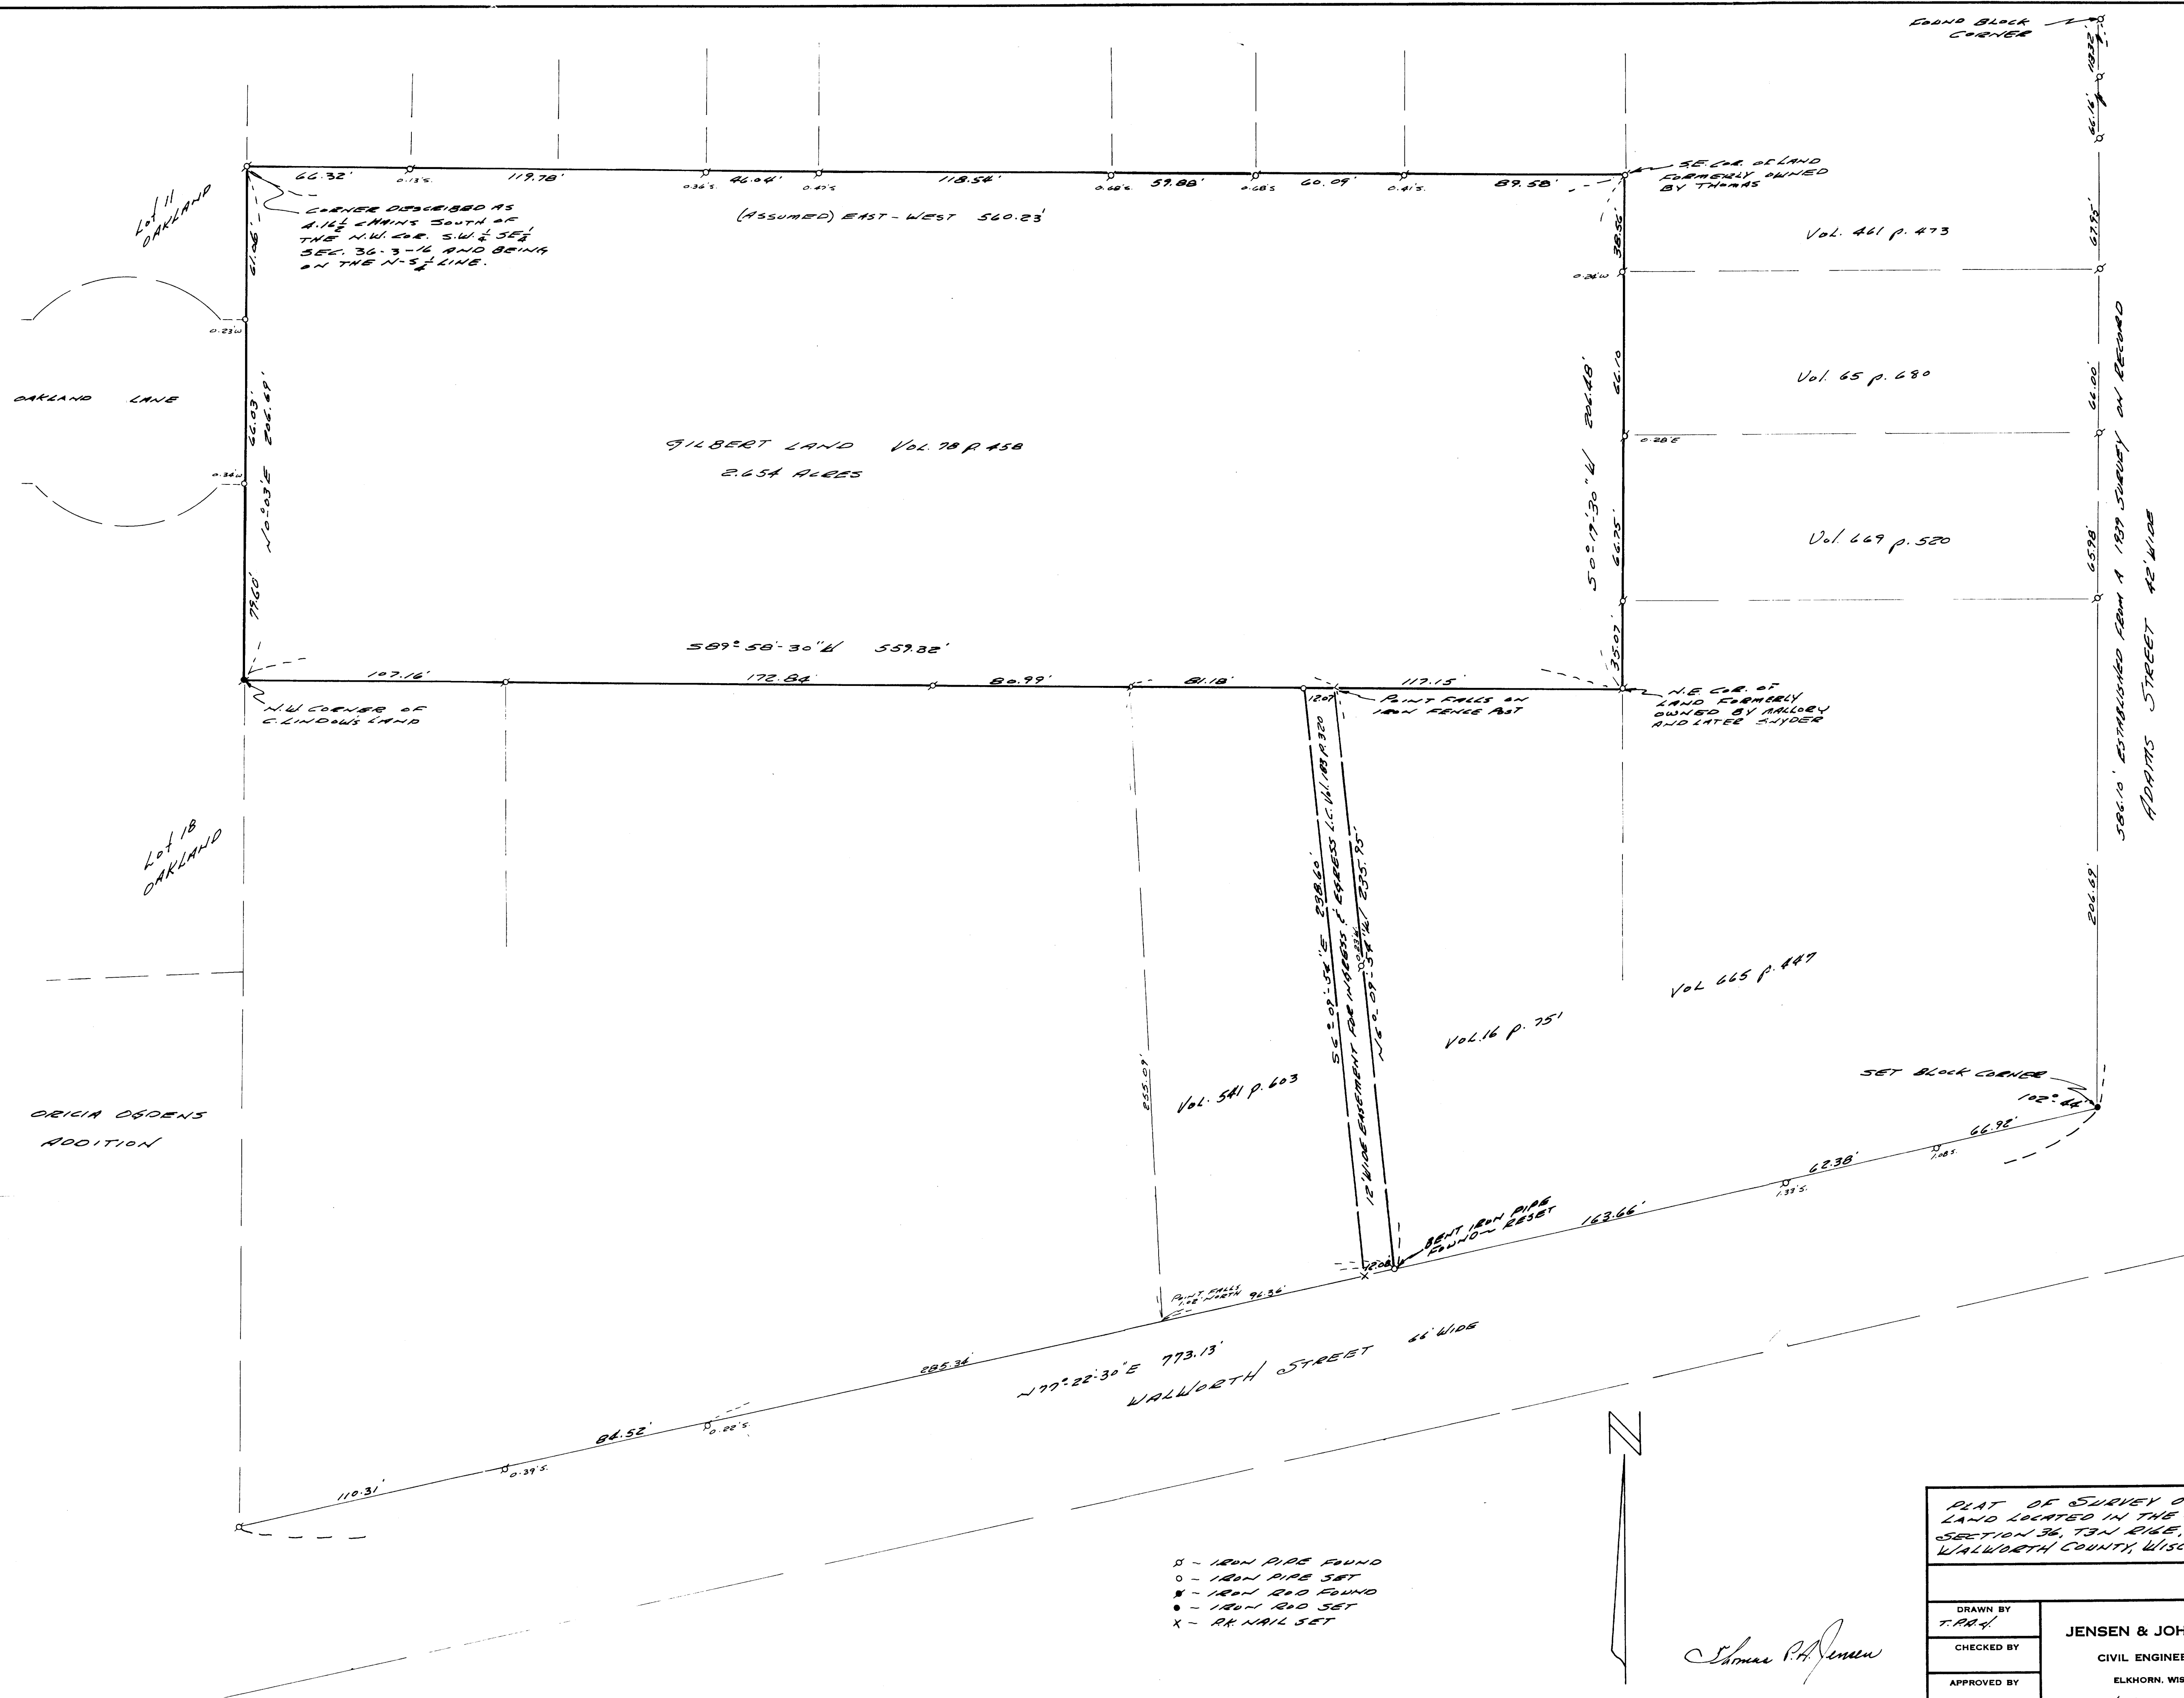

PLAT OF SURVEY OF THE GILBERT LAND LOCATED IN THE S.E. 1/4 OF SECTION 36, T3N, R1E, CITY OF ELKHORN, WALWORTH COUNTY, WISCONSIN.		
DRAWN BY T. R. H. J.	JENSEN & JOHNSON CIVIL ENGINEERS ELKHORN, WIS. DATE July 29, 1923	SCALE: 1"=30'
CHECKED BY		REVISED
APPROVED BY		SHEET NO. 1 OF 1

- - IRON PIPE FOUND
- o - IRON PIPE SET
- x - IRON ROD FOUND
- - IRON ROD SET
- x - RR NAIL SET

Edmund P. Jensen