


Kenneth B. Abernathy Jr.

Wisconsin Registered Land Surveyor S-1594

Rt. 3, Box 273
Elkhorn, Wisconsin 53121
Phone: (414) 723-4260 (office)
(414) 723-7209 (FAX)

PLAT OF SURVEY

LOT 7 OF JACKSON CREEK SUBDIVISION, LOCATED IN PART OF THE NW 1/4 OF THE SW 1/4 AND PART OF THE SW 1/4 OF THE SW 1/4 AND PART OF THE SE 1/4 OF THE SW 1/4 OF SECTION 7, TOWN 2 NORTH, RANGE 17 EAST, CITY OF ELKHORN, WALWORTH COUNTY, WISCONSIN.

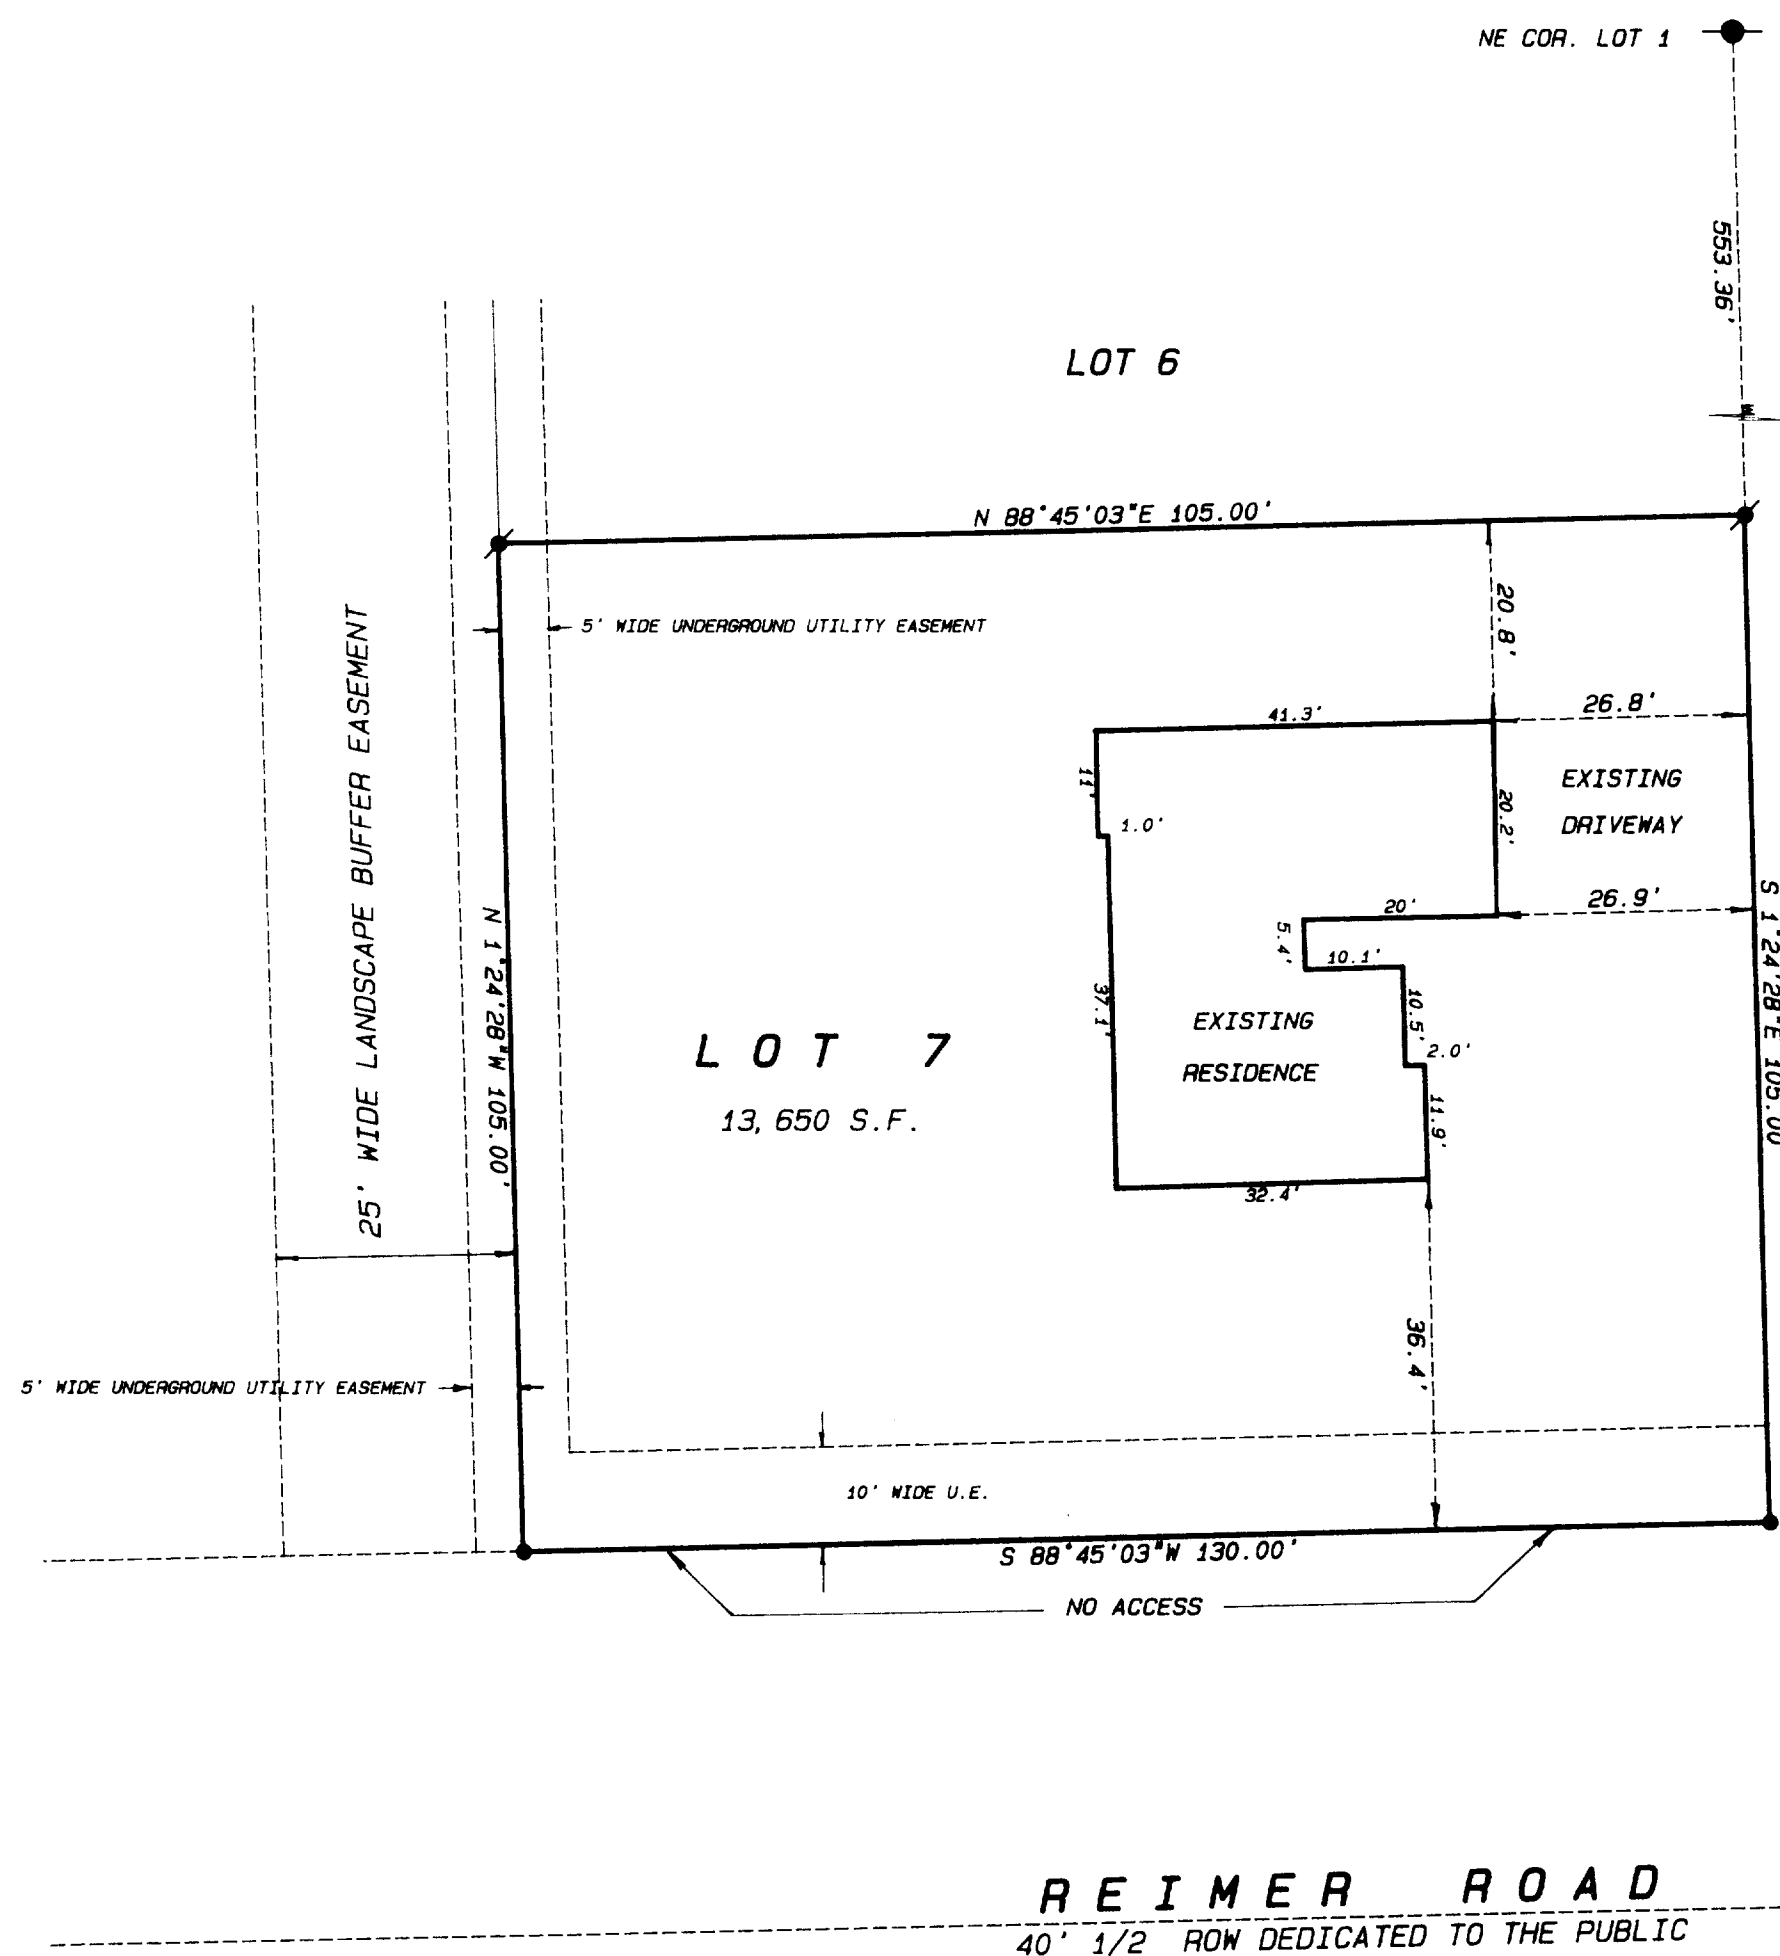

66' WIDE PUBLIC ROAD
MEADOW LANE




SCALE 1" = 20 FEET

BEARINGS REFERENCED TO PLATTED
NORTH

LOT 8

Legend

- ✱ FOUND IRON PIPE
 - FOUND IRON ROD
 - FOUND BRASS CAPPED MONUMENT
 - FOUND CONCRETE MONUMENT
 - ✱ CHISEL CUT IN CONCRETE
 - SET IRON ROD, 24" LONG, WEIGHING 1.5 LBS./LINEAL FT., 3/4" DIA.
 - SET IRON ROD, 30" LONG, WEIGHING 4.5 LBS./LINEAL FT., 1-11/16" DIA.
- (xx) RECORDED AS DIMENSION
- x—x— EXISTING FENCE

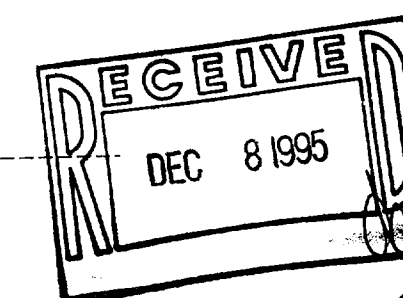

SCALE: 1" = 20 FEET

ORDERED BY: BROOKSTONE HOMES
SUITE 206
4450 MILTON AVE.
JANESVILLE, WI. 53546



"I hereby certify that the above described property has been surveyed and that the above map is a true and correct representation of the size and location of the property, its exterior boundaries, the location of all visible structures and dimensions of all principal buildings thereon, boundary fences, apparent easements, roadways and visible encroachments, if any."

"This survey is made for the use of the present owners of the property, and also those who purchase, mortgage, or guarantee the title thereto within one year from date hereof."

KENNETH B. ABERNATHY, JR.
WISCONSIN REGISTERED LAND SURVEYOR,

Date: 11-30-95 Job No. 95.1107

DESIGN PRODUCTS 082401

VSC-7

884-964