



JEFFERSON ST.

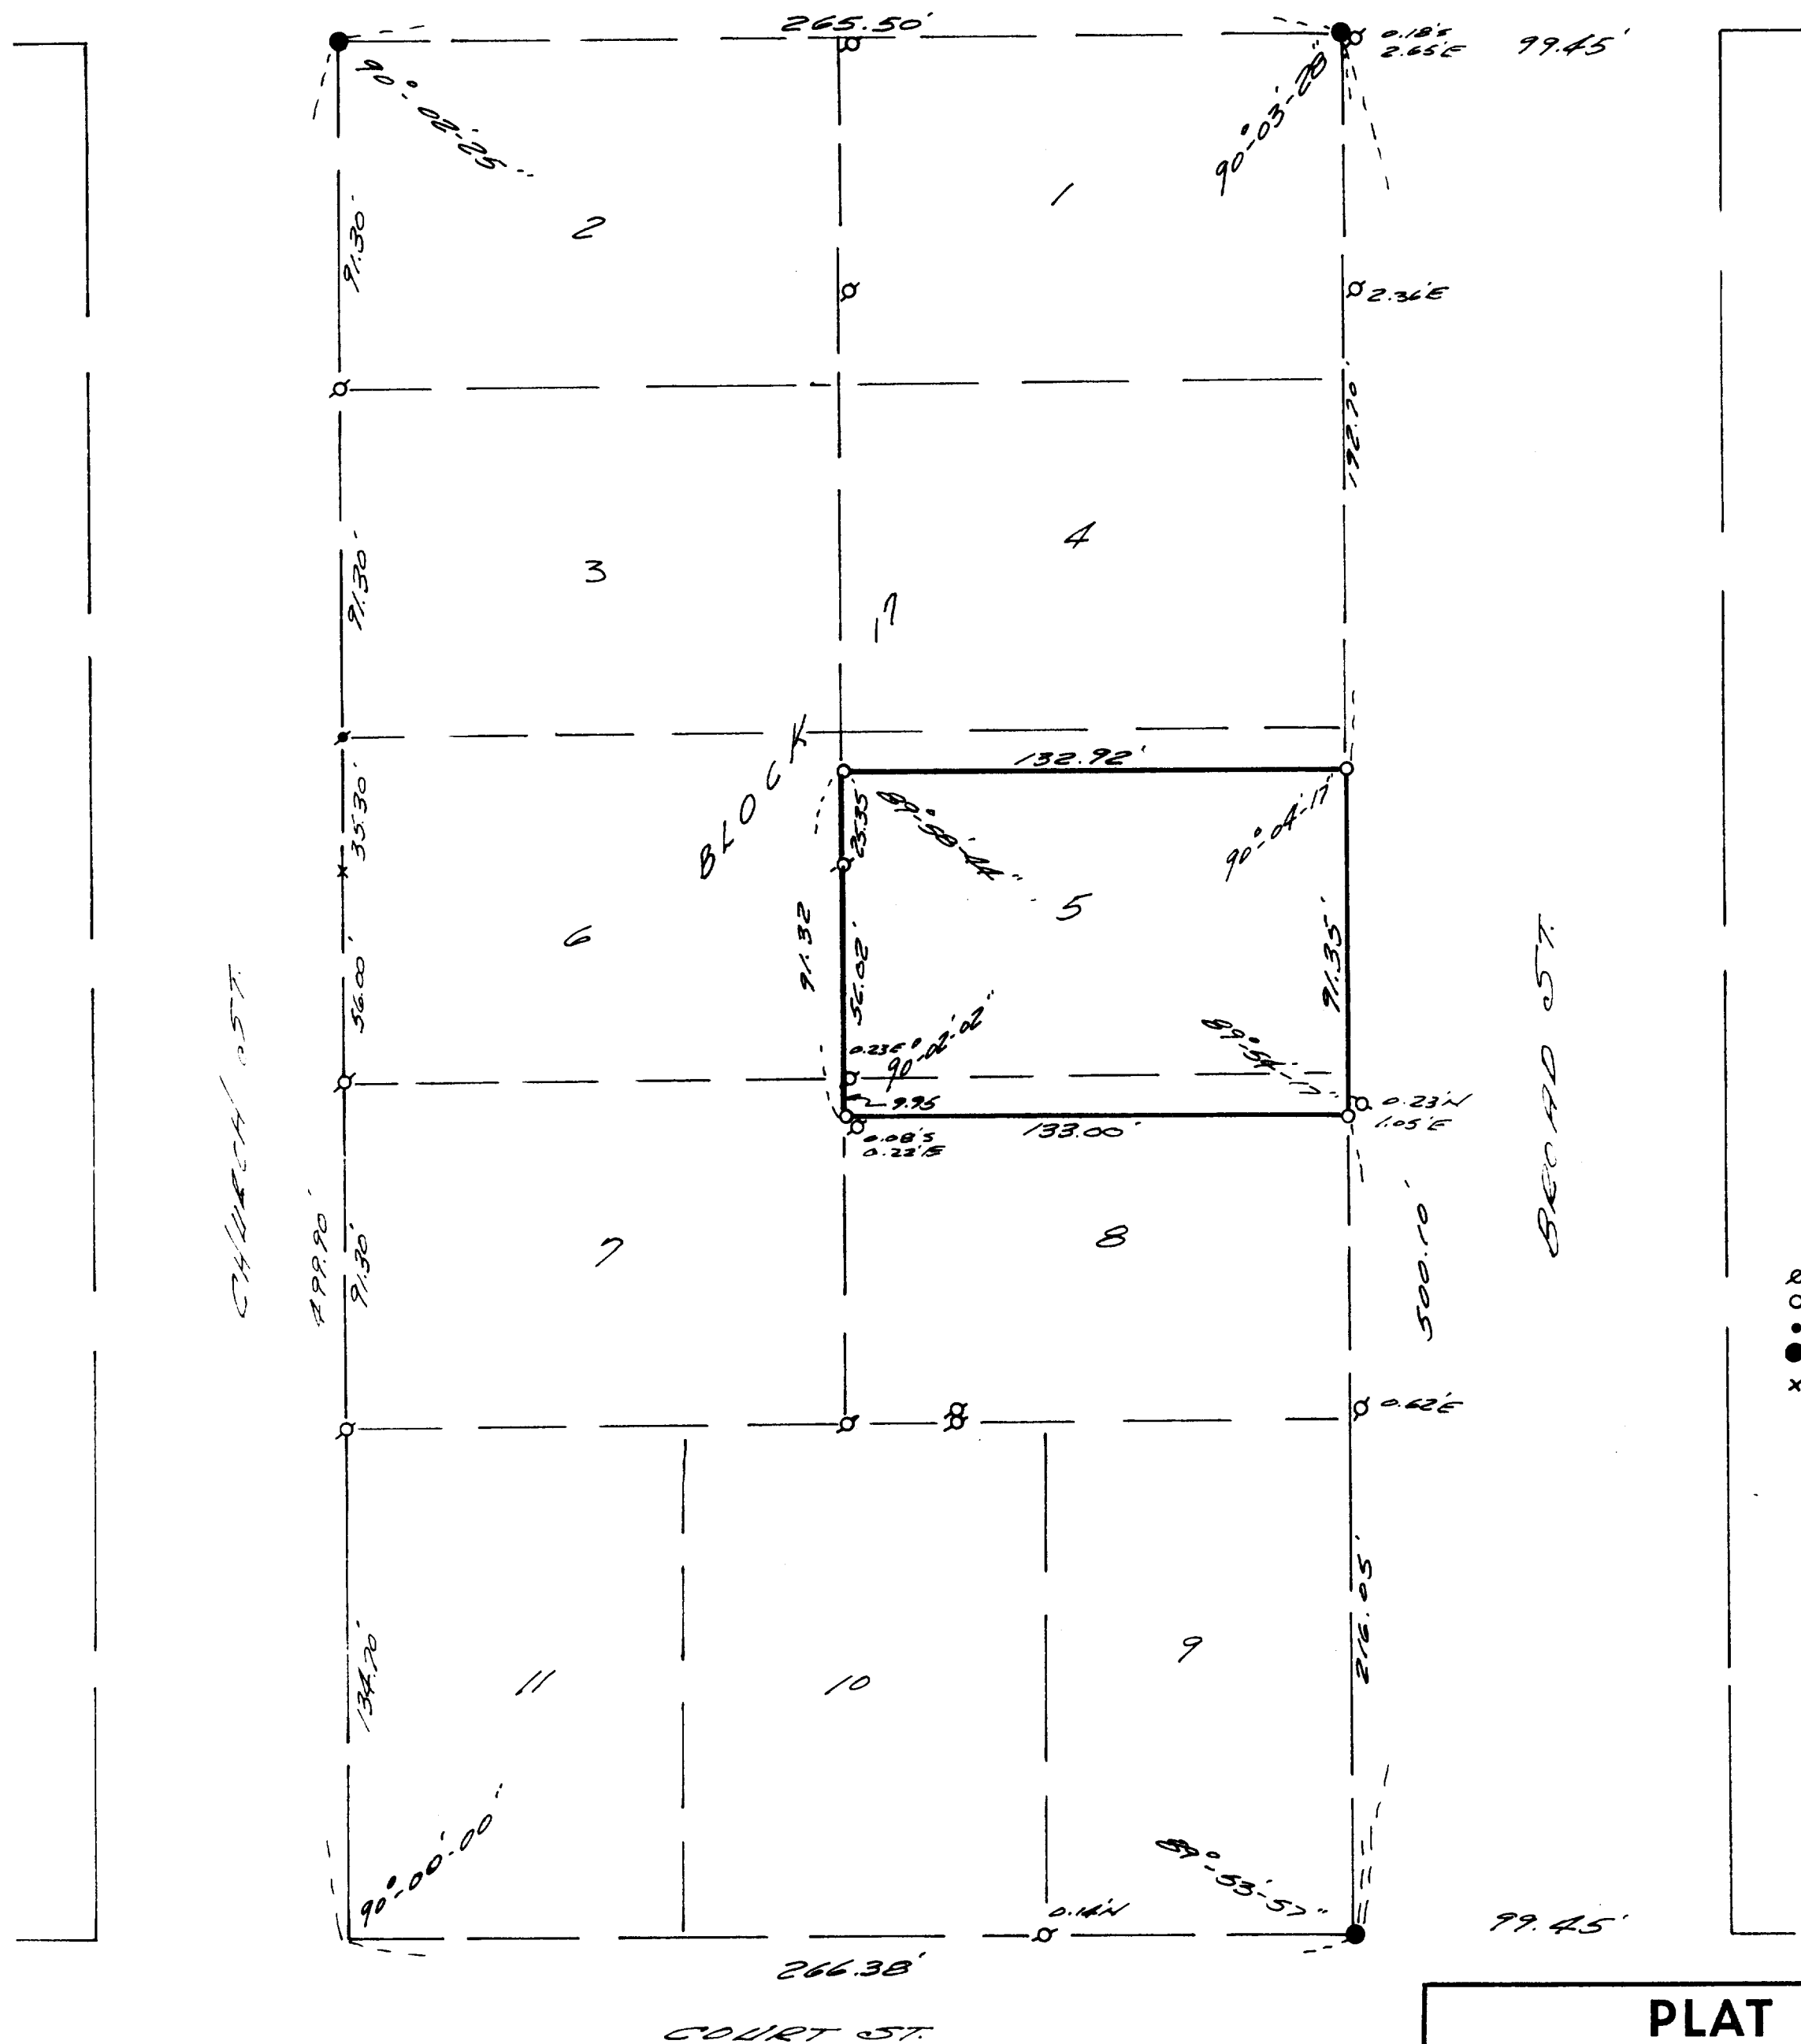

- SCALE 1" = 40'
- ⊗ ~ IRON PIPE FOUND
 - ~ IRON PIPE SET
 - ~ IRON ROD FOUND
 - ⦿ ~ IRON BAR SET
 - x ~ CHISEL CROSS IN CONC. FOUND

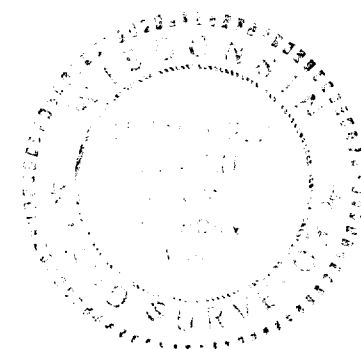

PLAT OF SURVEY OF

PART OF LOT 8 AND PART OF
LOT 5, BLOCK 17 OF THE ORIGINAL
PLAT OF THE VILLAGE (NOW CITY)
OF ELKHORN, WALKWORTH
COUNTY, WISCONSIN.

Thomas P. Jensen
SURVEYOR

SCALE 1" = 40'

DATE MAY 26, 1973