


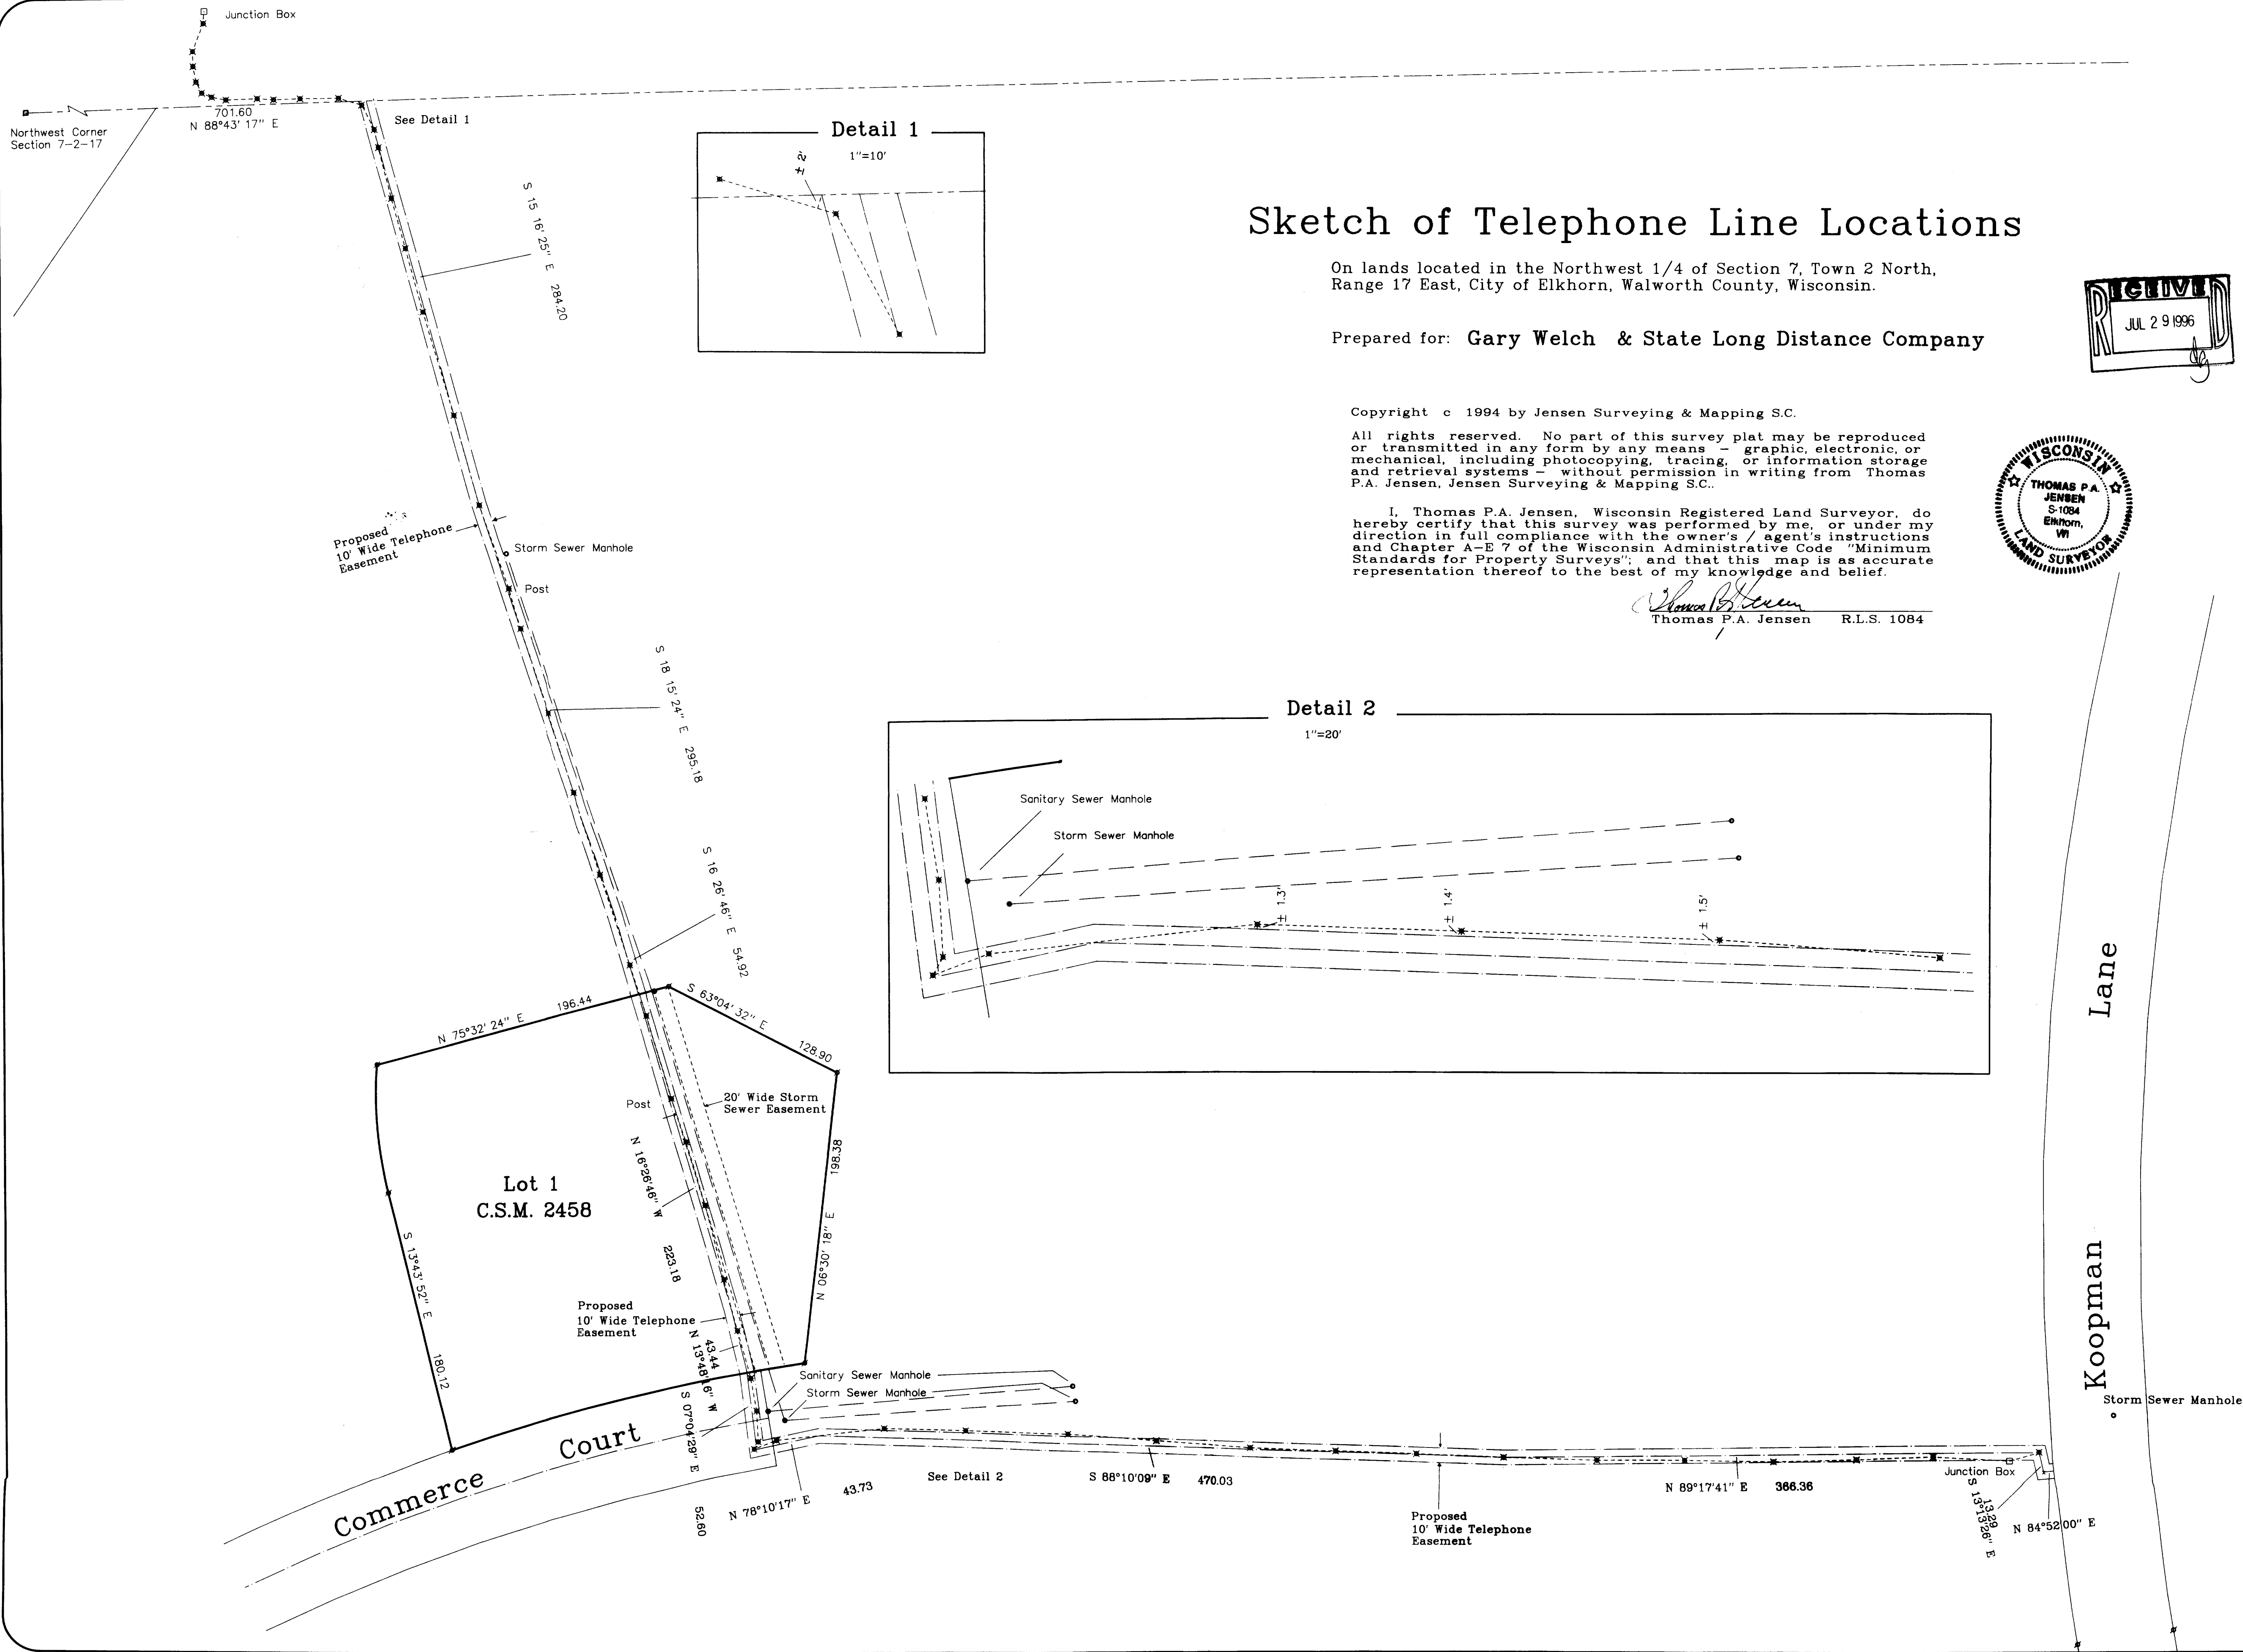

Sketch of Telephone Line Locations

On lands located in the Northwest 1/4 of Section 7, Town 2 North, Range 17 East, City of Elkhorn, Walworth County, Wisconsin.



Prepared for: Gary Welch & State Long Distance Company

Copyright © 1994 by Jensen Surveying & Mapping S.C.

All rights reserved. No part of this survey plat may be reproduced or transmitted in any form by any means - graphic, electronic, or mechanical, including photocopying, tracing, or information storage and retrieval systems - without permission in writing from Thomas P.A. Jensen, Jensen Surveying & Mapping S.C.

I, Thomas P.A. Jensen, Wisconsin Registered Land Surveyor, do hereby certify that this survey was performed by me, or under my direction in full compliance with the owner's / agent's instructions and Chapter A-E 7 of the Wisconsin Administrative Code "Minimum Standards for Property Surveys"; and that this map is as accurate representation thereof to the best of my knowledge and belief.

Thomas P.A. Jensen
Thomas P.A. Jensen R.L.S. 1084

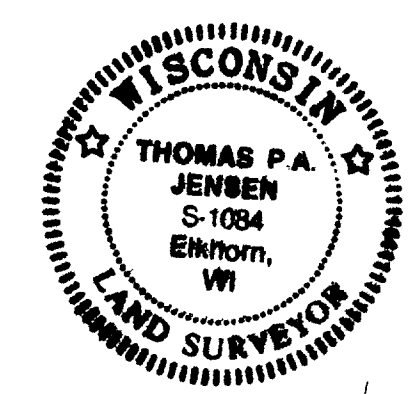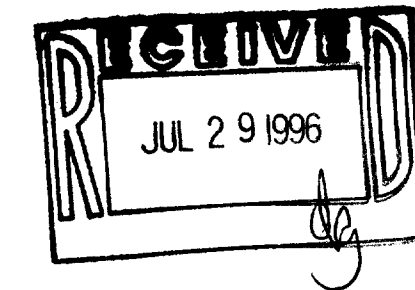

Mapping date: August 28, 1994	
Revisions:	
Scale in Feet 1" = 50' 0' 25' 50' 100' 150'	
JENSEN SURVEYING & MAPPING S.C. 45 South Wisconsin Street P.O. Box 322 Elkhorn, Wisconsin. 53121 Telephone & Facsimile: (414) 723-3434	
Sheet 1 of 1 Sheets.	Legend □ Found County Section Corner x Found Iron Rod ○ Utility Manhole □ Utility Pole x Flag indicating location of buried cable.
Job Reference Number 1994.053	
1994.053 x	