
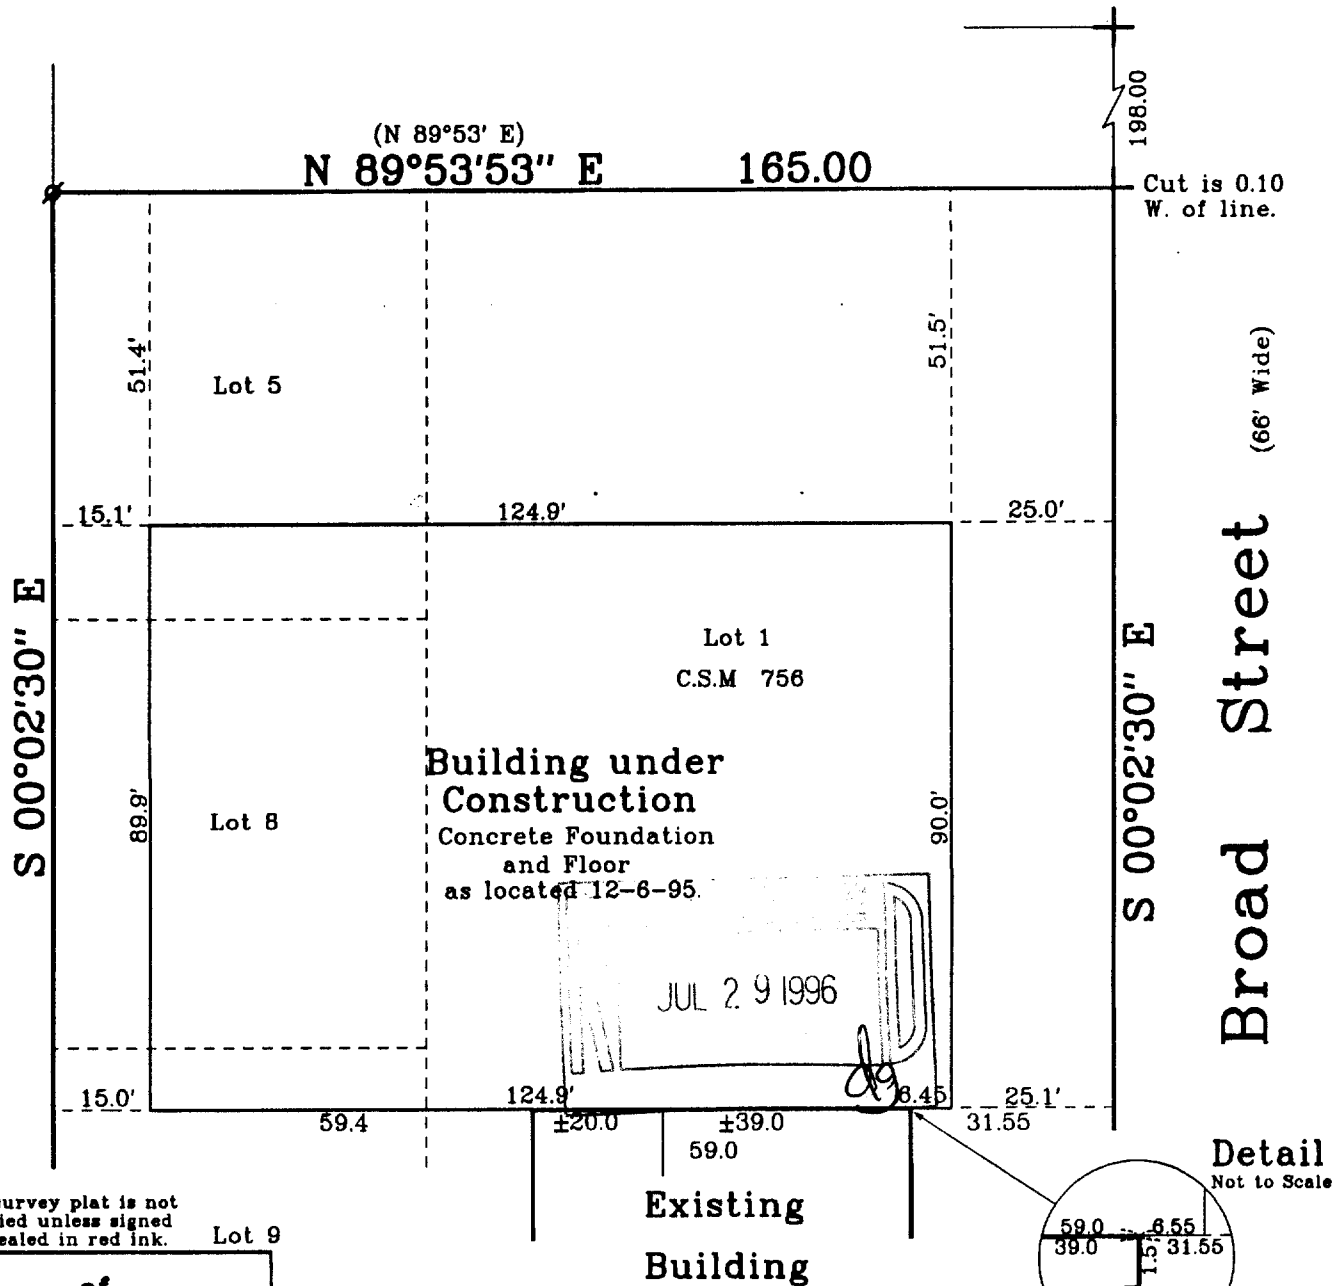


Plat of Survey


of

A proposed building addition located on Lot 1 of Certified Survey
Map No. 756 and part of Lots 5, 8, and 9 of Block 1 of Rockwell
Brothers Addition to the City of Elkhorn, Walworth County, Wisconsin.

Surveyed for: **Henry Van Dyken**
Southern Lakes Recycle
220 South Broad Street
Elkhorn, Wisconsin. 53121

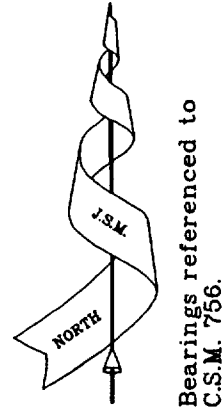

Note: This survey plat is not
certified unless signed
and sealed in red ink. Lot 9

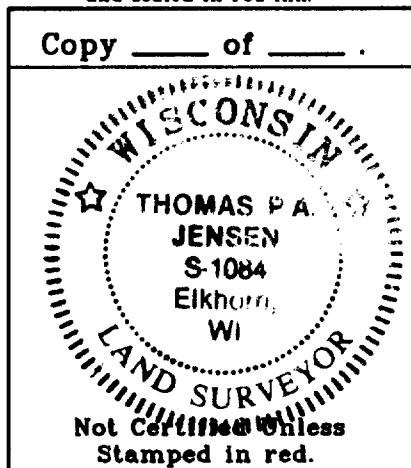

Copyright © 1995 by Jensen Surveying & Mapping S.C.

All rights reserved. No part of this survey plat may be reproduced or transmitted in any form by any means - graphic, electronic, or mechanical, including photocopying, tracing, or information storage and retrieval systems - without permission in writing from Thomas P.A. Jensen, Jensen Surveying & Mapping S.C.

I, Thomas P.A. Jensen, Wisconsin Registered Land Surveyor, do hereby certify that this survey was performed by me, or under my direction in full compliance with the owner's / agent's instructions and Chapter A-E 7 of the Wisconsin Administrative Code "Minimum Standards for Property Surveys", and that this map is as accurate representation thereof to the best of my knowledge and belief.

Date: 12-11-95

Thomas P.A. Jensen
Thomas P.A. Jensen R.L.S. 1084


Legend

- + Found Chiseled Crosscut
- Ø Found Iron Pipe
- Set Iron Rod, 3/4" dia.
- Set Wood Stake

Jensen Surveying & Mapping S.C.

45 South Wisconsin Street P.O. Box 322
Elkhorn, Wisconsin. 53121
Telephone & Facsimile (414) 723-3434

Scale in feet: 1" = 30'

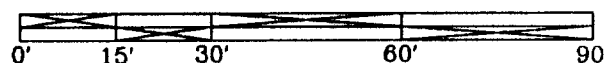

Mapping Date: 10-9-95

Revisions: 10-10-95
12-11-95

Sheet 1 of 1 Sheets

Job Reference No.

1995.085

VA-756-1
004-995