




● = CONCRETE MONUMENT

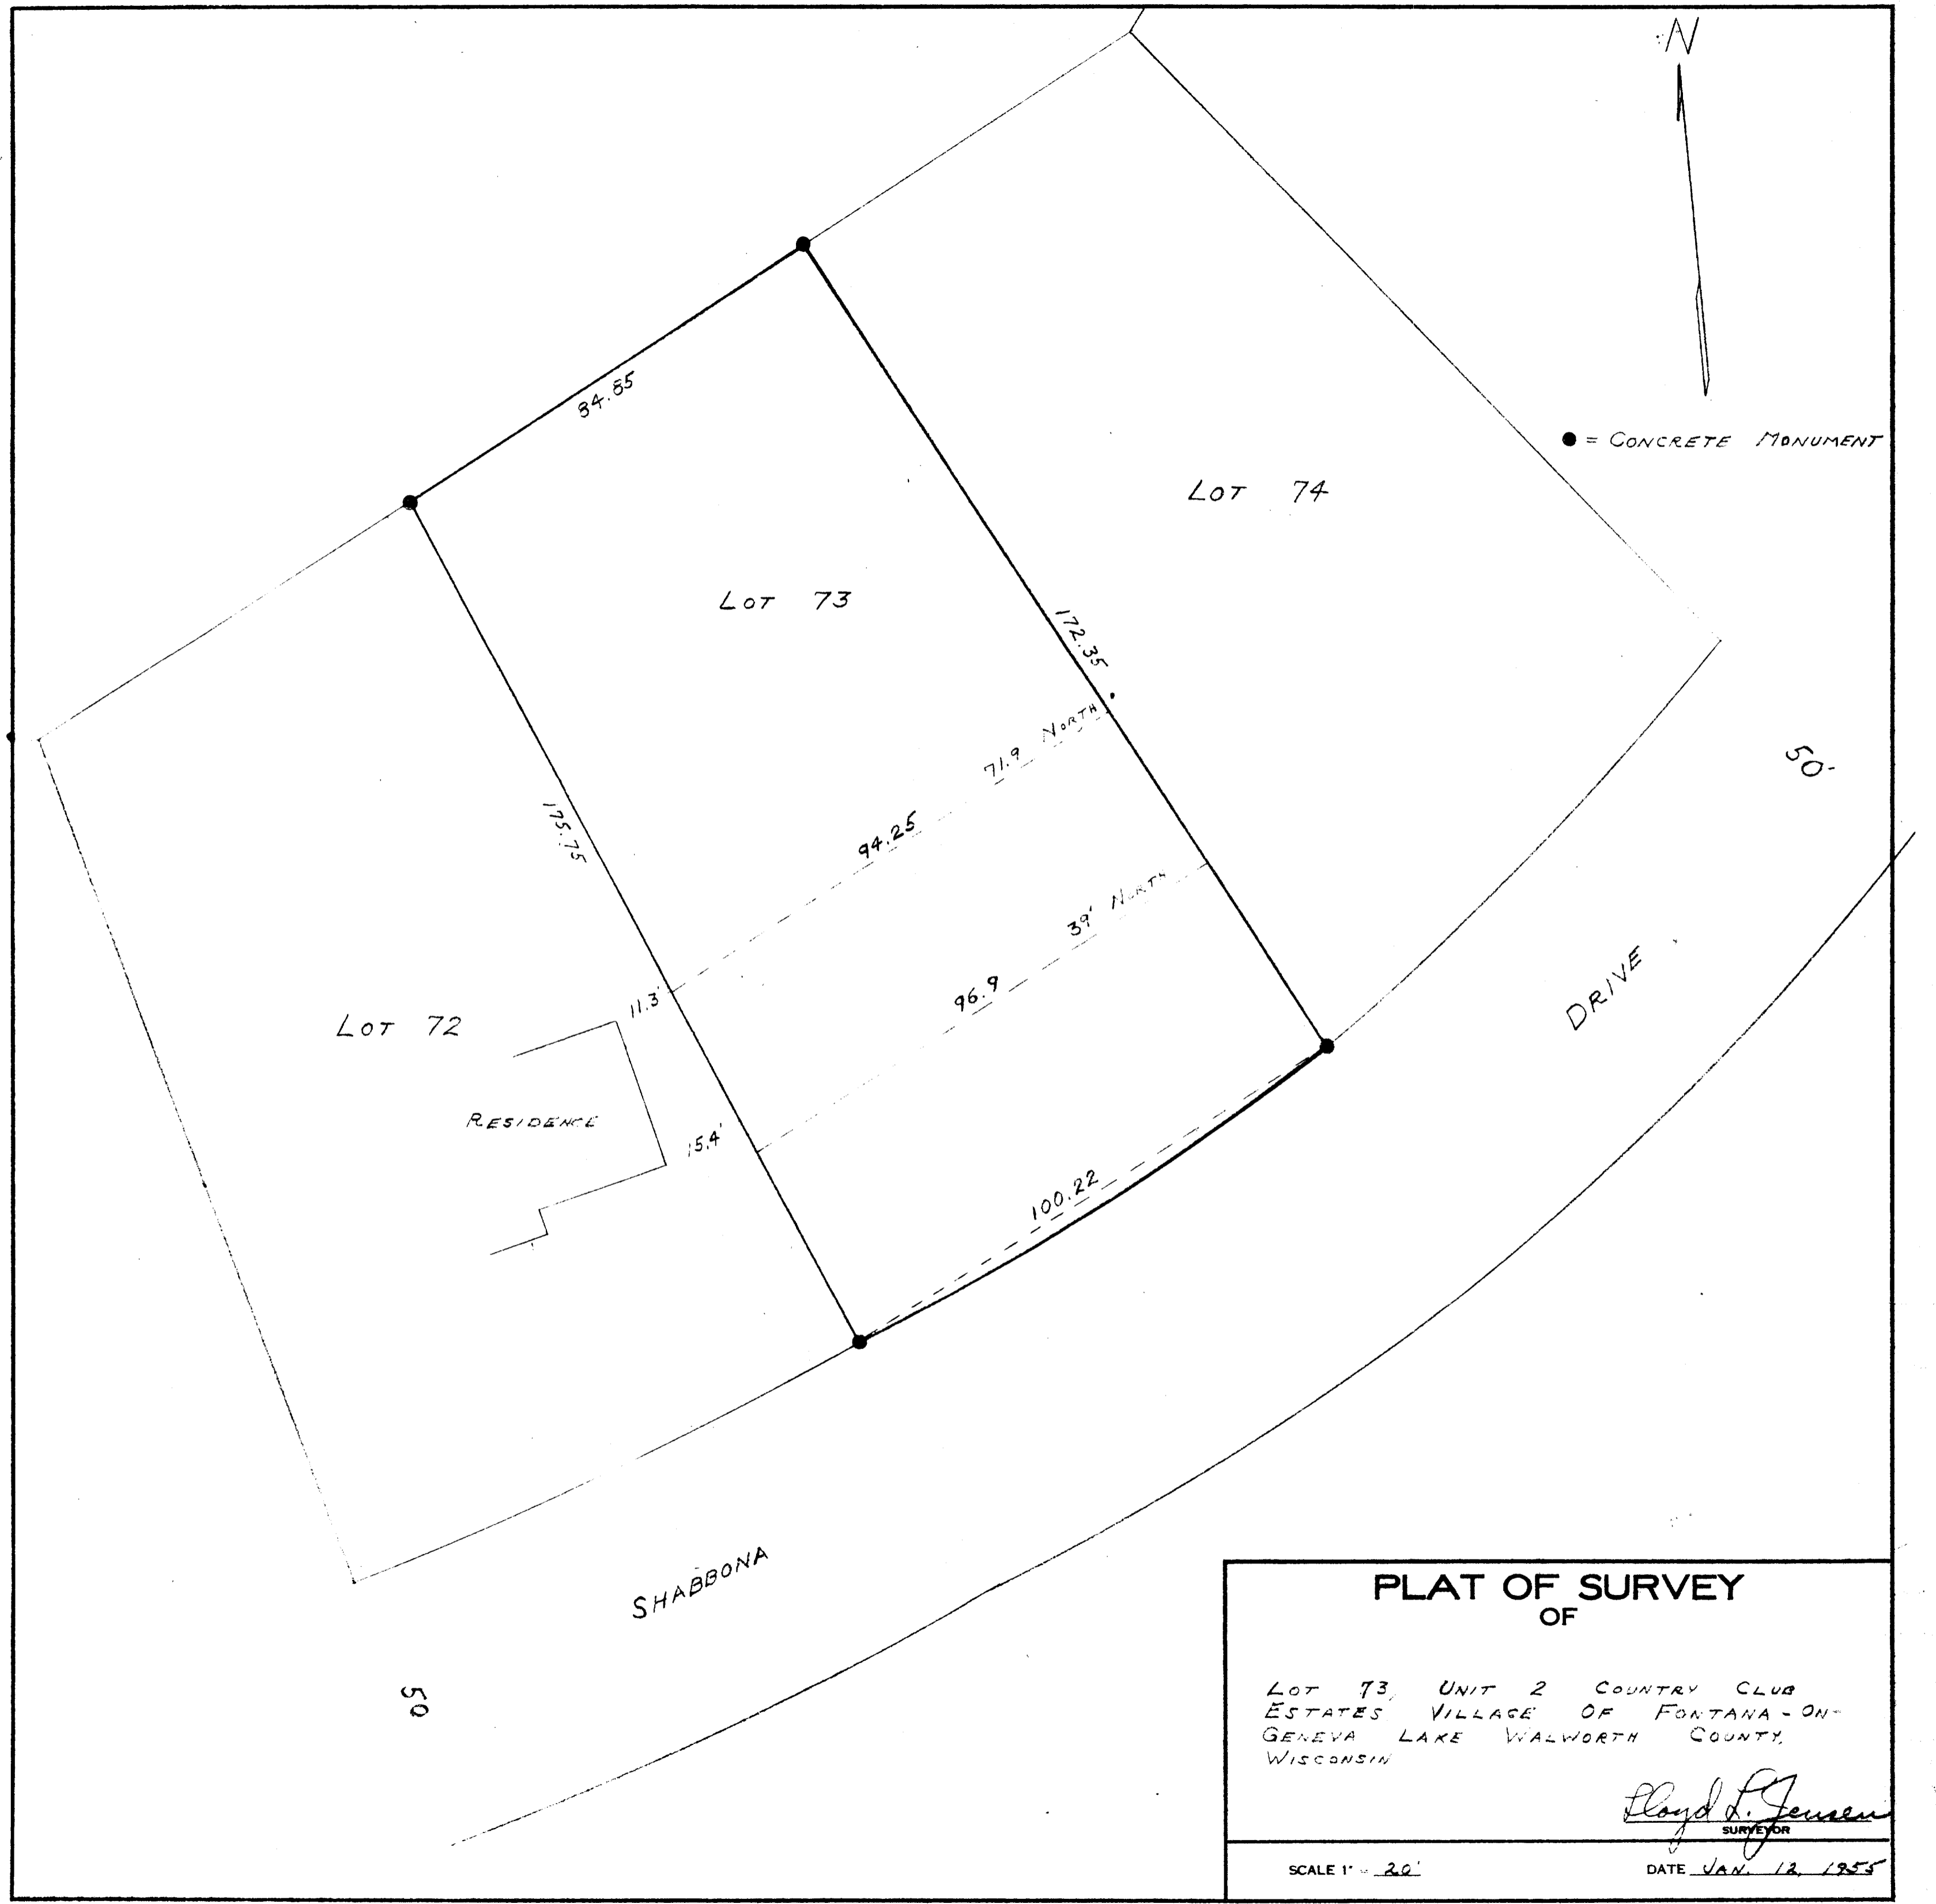

LOT 72

RESIDENCE

LOT 73

LOT 74

DRIVE

SHABBONA

50

50

PLAT OF SURVEY
OF

LOT 73, UNIT 2 COUNTRY CLUB
ESTATES VILLAGE OF FONTANA - ON -
GENEVA LAKE WALWORTH COUNTY,
WISCONSIN

Lloyd L. Jensen
SURVEYOR

SCALE 1" = 20'

DATE JAN. 12, 1955

5-100J