


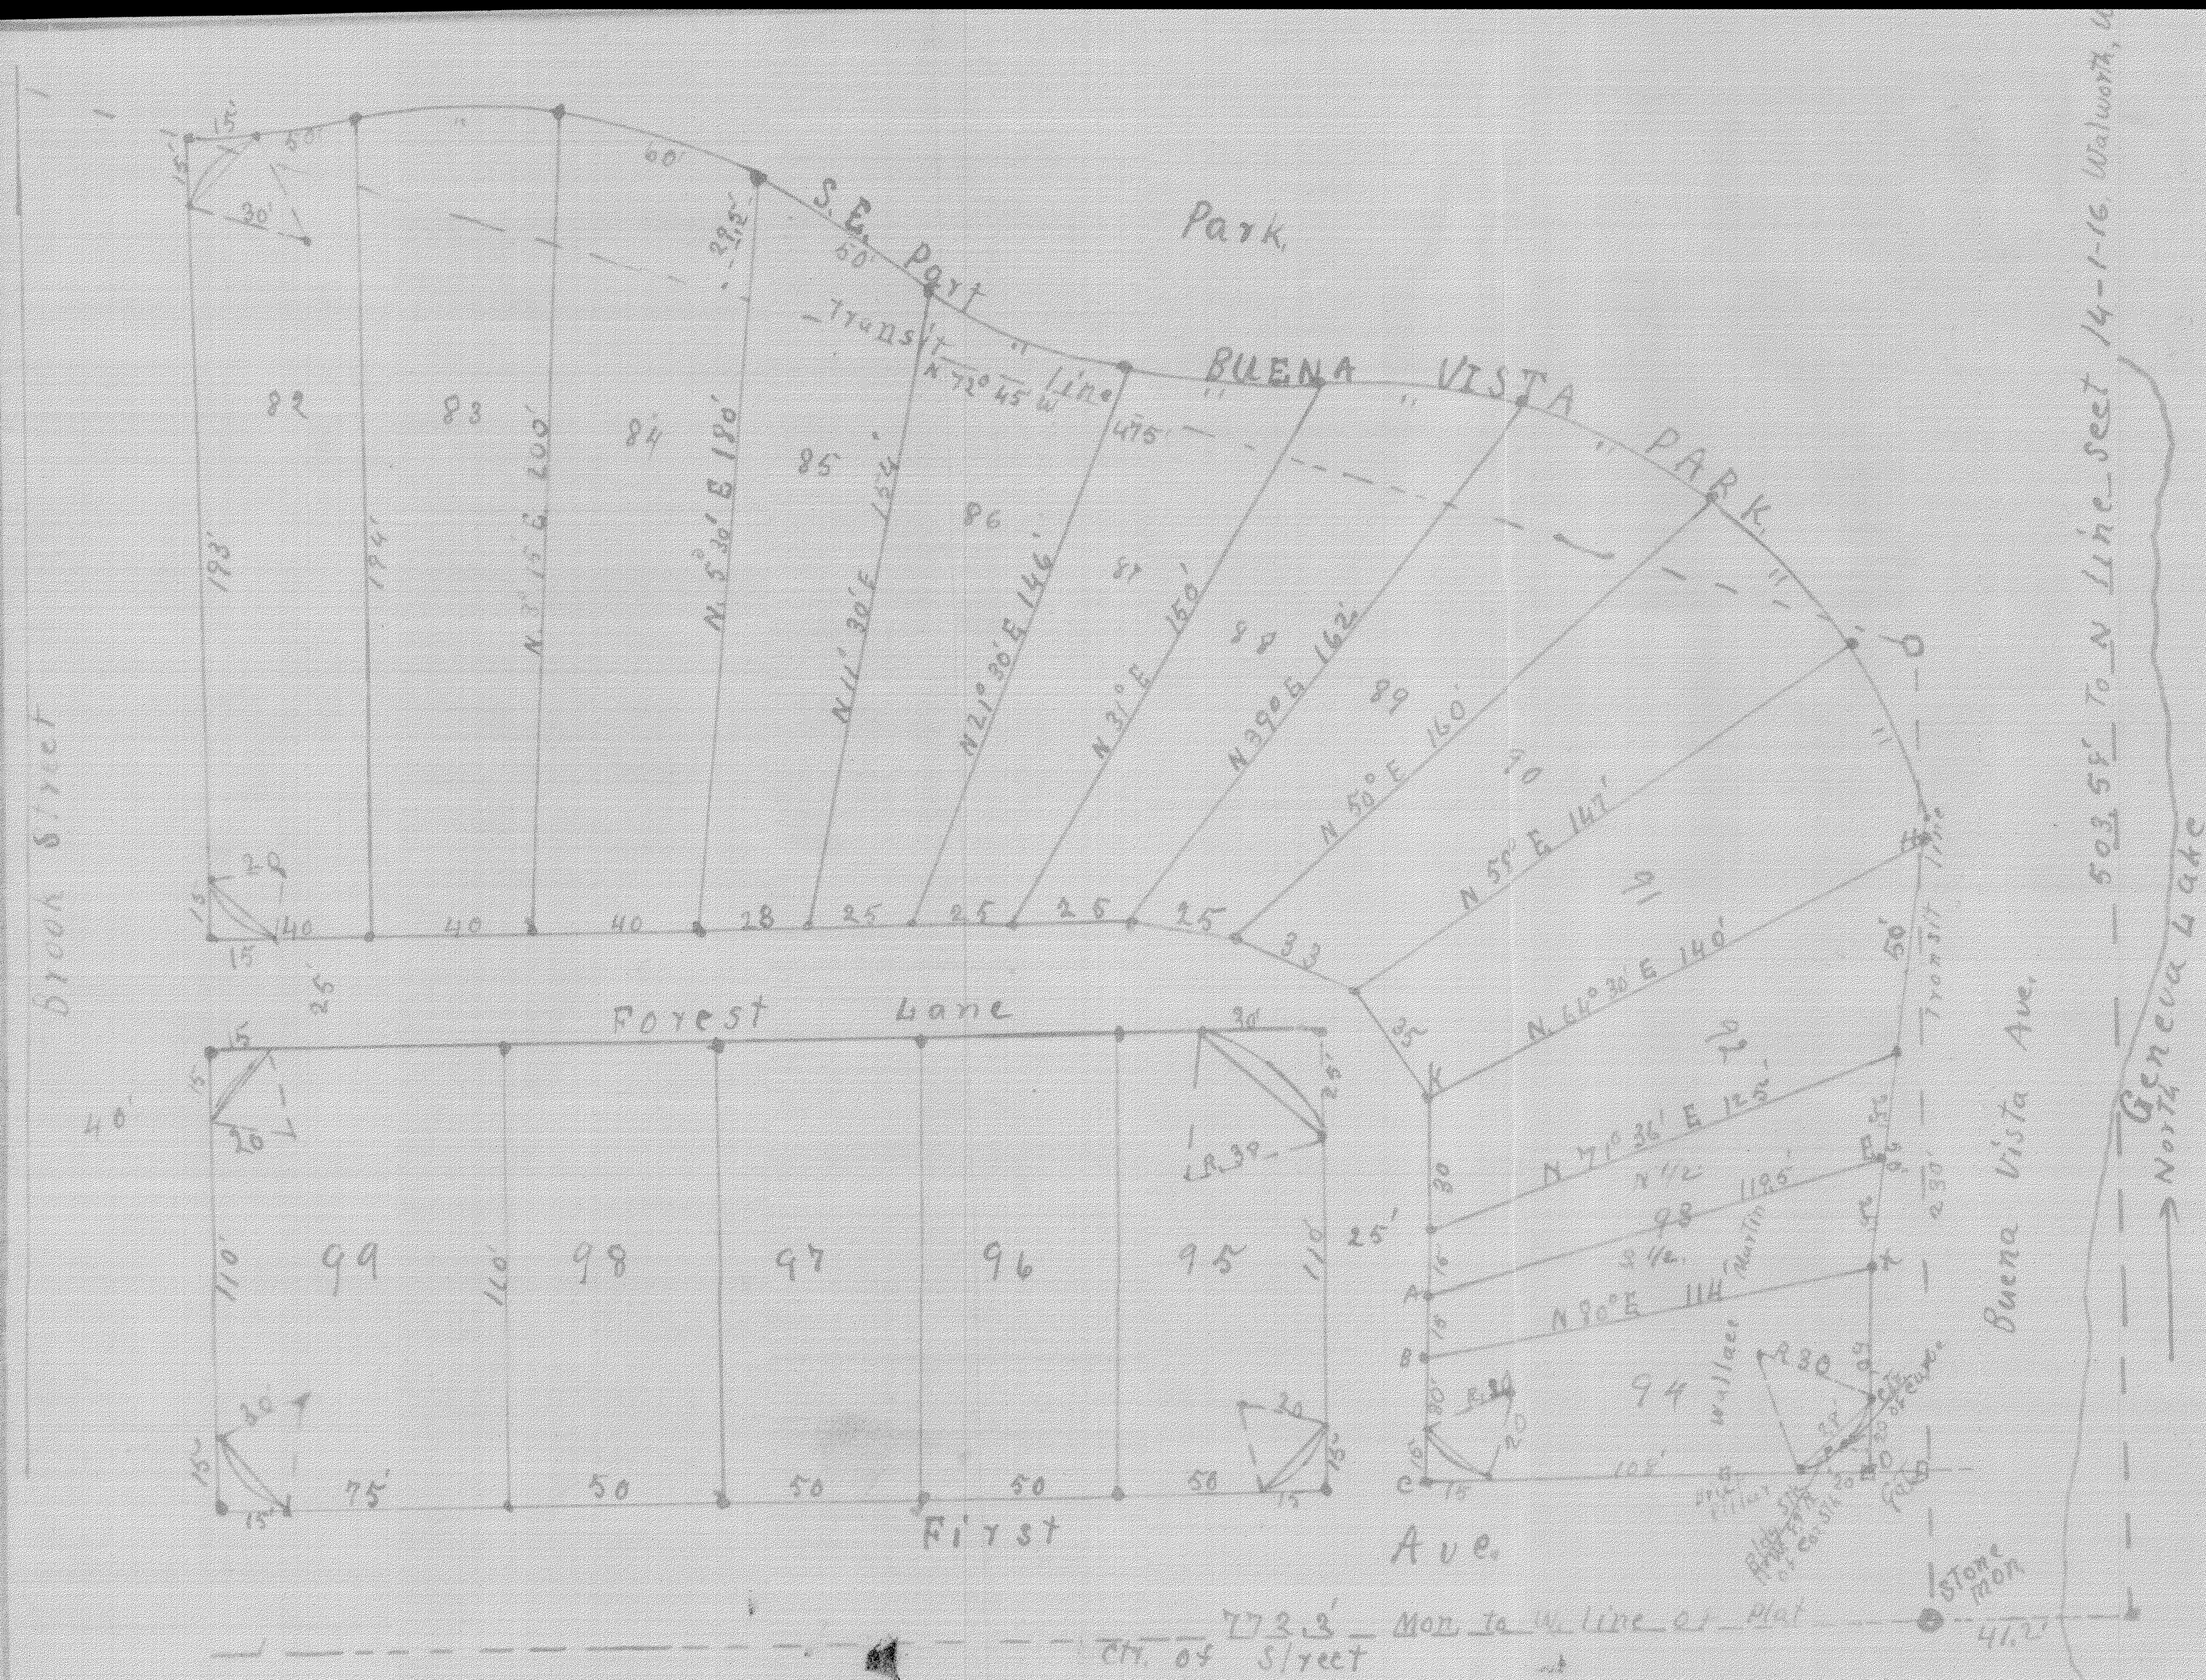

CERTIFICATE

This to certify that by request of the owner, Wallace Martin, we have today surveyed & measured & staked lot 94 and S. 1/2 of 93, Buena Vista, as shown herewith.


Iron stakes were found at K, H, & K and original wood stakes at B & C. 2" by 2" iron stakes are set at A, B, C, D & E.

A, Bldg. stake is set as indicated. The curve at the gate is marked by 3 stakes as indicated.

Radius of curve 30' tangents 20'. The remainder of map is a copy from Elkhorn Records. Stakes as indicated by . . .

Scale 40' to 1"

June 30, 1921
J. G. Skeels, C. E.
Bessie Palmer, Asst.

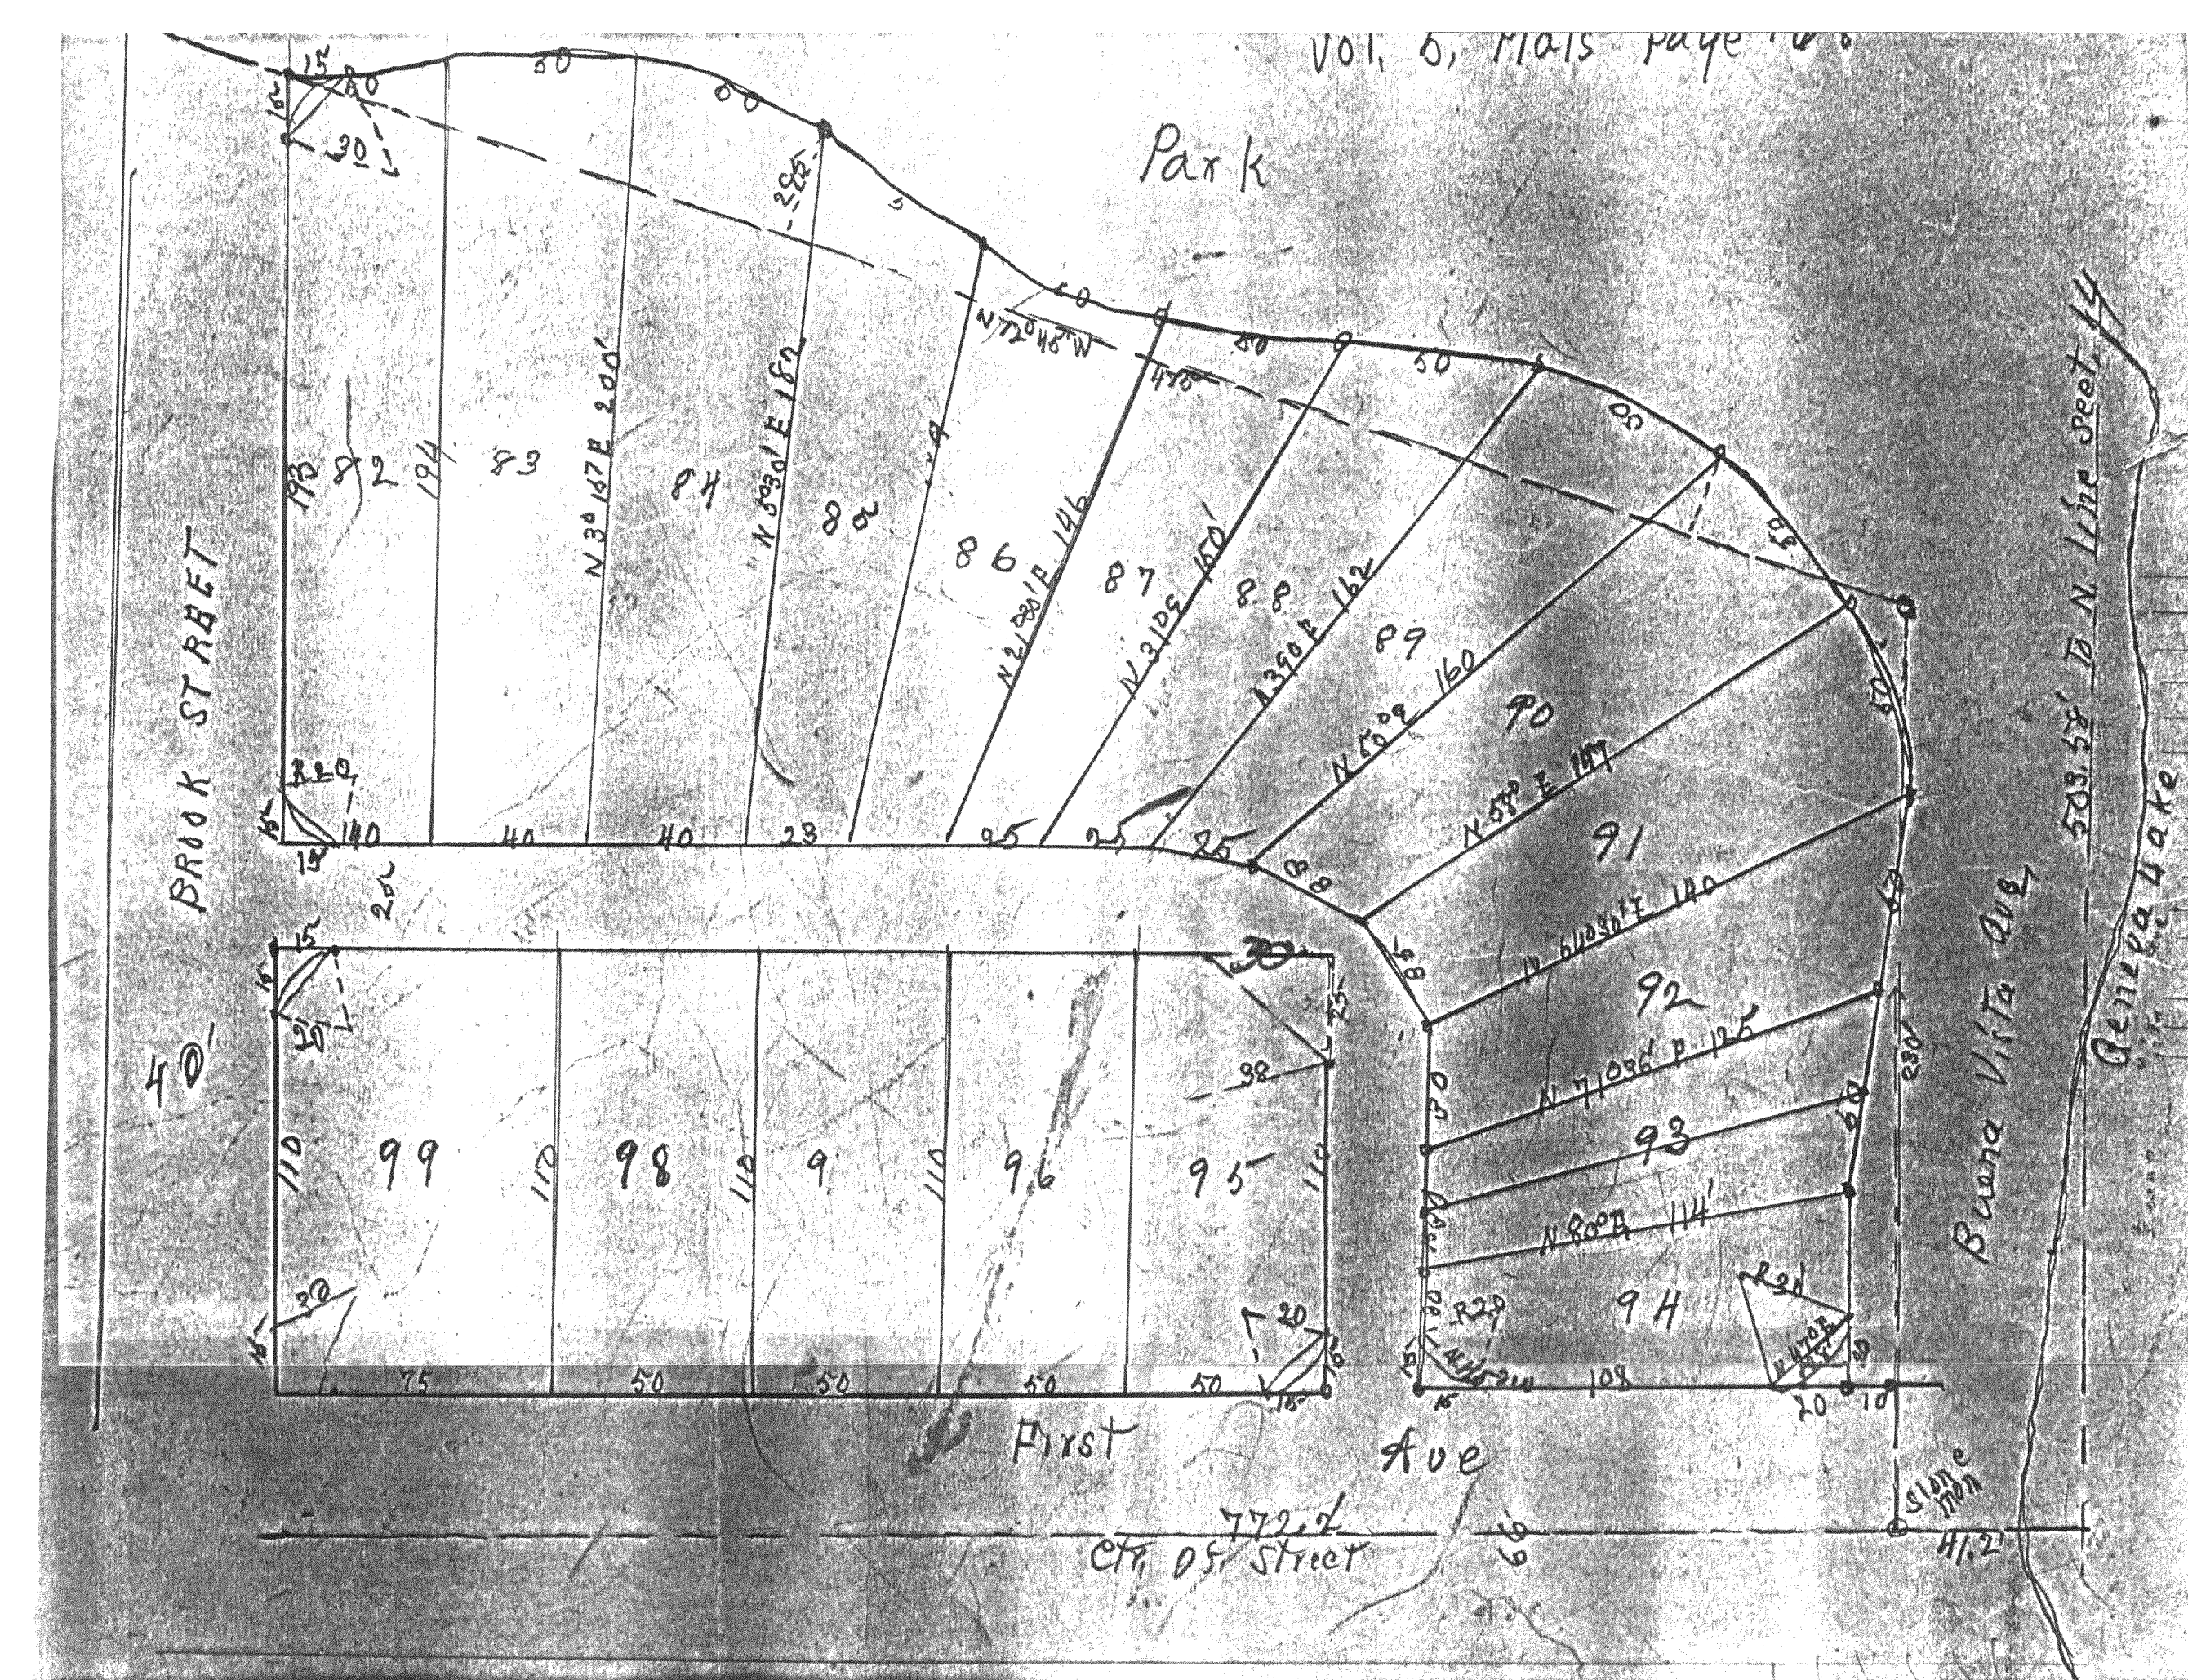

73 June 30/11
Survey of lot 94 &
Wallace Martin
lot 5, 50' front 90'
Old stakes found
and at N.W. Cor,
at S.W. Cor, 93 & 94,
2" x 2" iron stakes
93 and at N.W.
stakes set at end
Radius 30'. Tang.
S/L 93 Buena Vista Park.
rear,
at N.E. Cor, 94 & 92
92, and old wood stake
set at end of middle line
& S.W. Cor's 94, & S.E. 94,
& middle of curve at gate
20' chord 18'

Lot 93 & 94 Buena Vista Park
5-1021h