


GEORGE T. DUNHAM  
SURVEYING & SUBDIVIDING  
DELAVAN, WISCONSIN

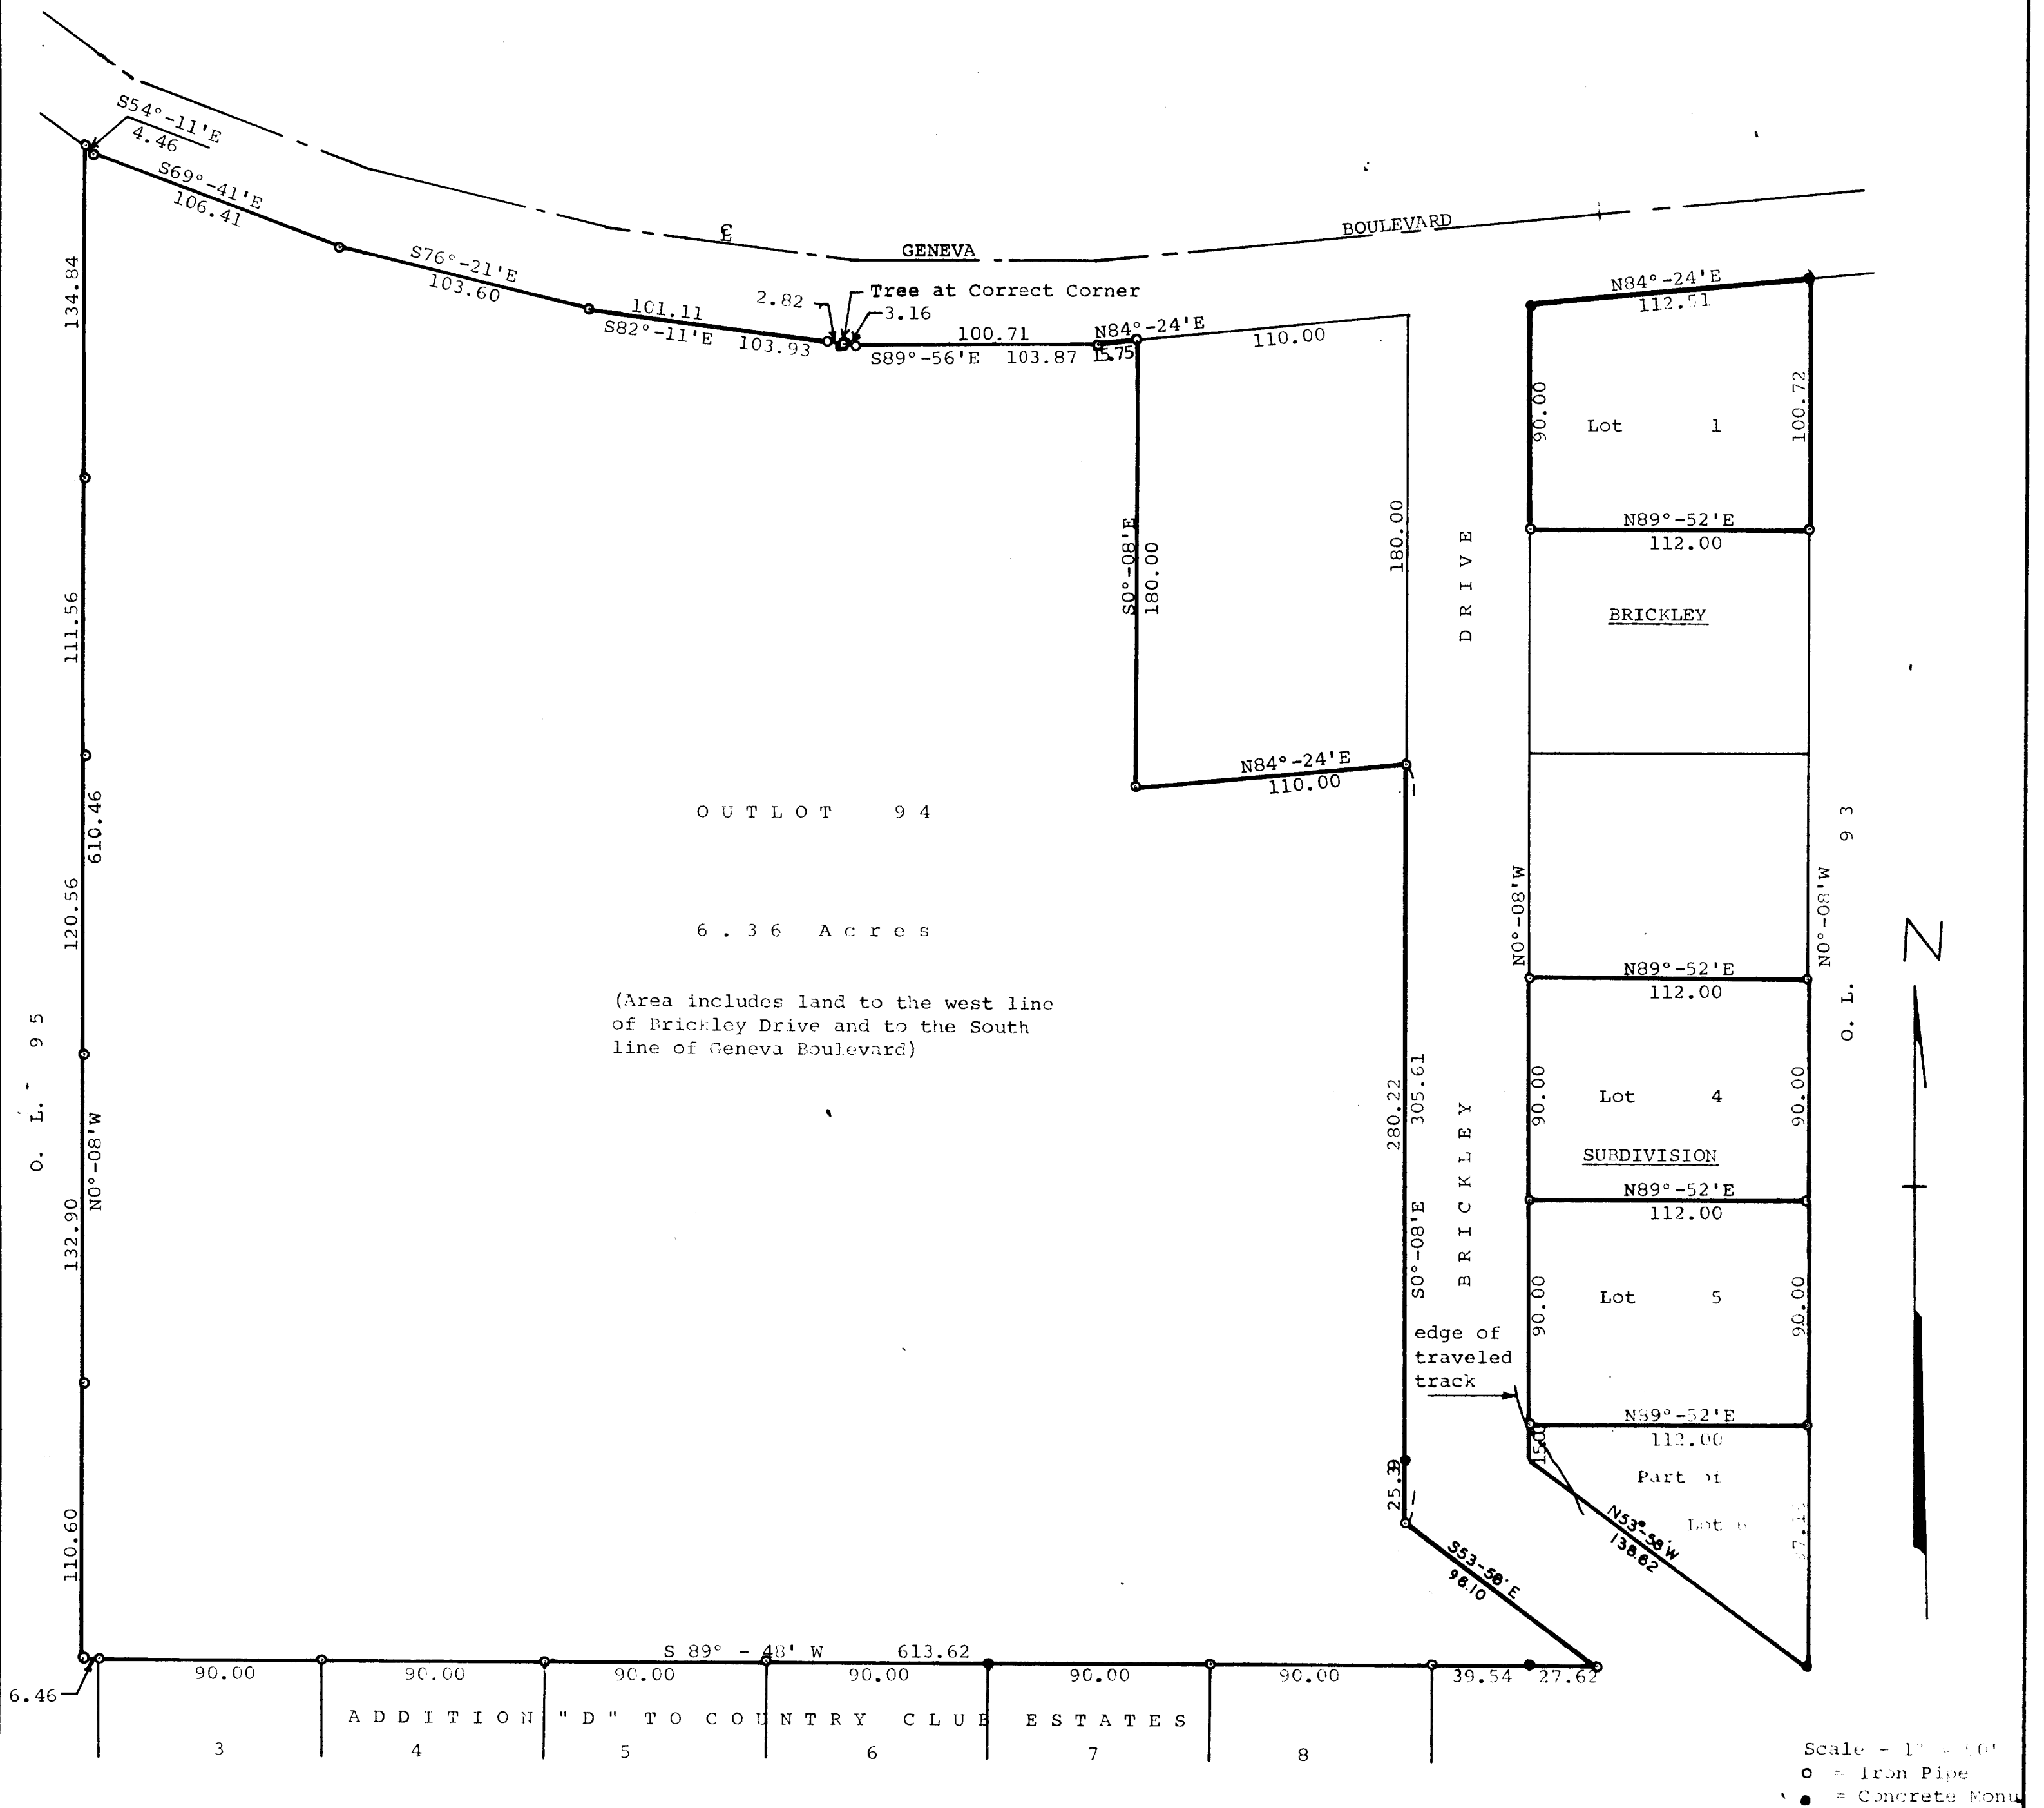

Plat of survey of land located in Outlot 94 of the Assessors Plat of the Village of Fontana on Geneva Lake and of land located in Brickley Subdivision, Village of Fontana, Walworth County, Wisconsin.  
July 12, 1966

George T. Dunham, Surveyor