

76

7/20/22.

Survey for
Lot No. 3.

This had been platted in 1892
Bertolet and divided into
block 30' square and
wide thru center. The
But the W. line measures
The iron stakes said to have
in part, from $\frac{1}{2}$ " in diam.
many instances,

As requested we have
10 of them 68' E & W. and
a parking at The lake
E. side. iron stakes
along E line and
on west line 29' from
1" in diam. to be followed

J. W. Smith, Hebron, Ill. Sylvan Glen
R. Gardner's Sub. near Harvard Camp
S. side Geneva Lake 13-1-16,


for Carpenter & Janurin by J. B.
2 blocks, and 19 lots in each
and an Ave. (Sylvan Ave) 22'
tract is 82' wide ^{supposed} 68' to E. N. & S.
664.2' to waters edge and east line 642.5'
been set at all corners were found
to $\frac{1}{4}$ " of various scrap iron in

divided the tract into 11 lots
50' N. & S. and 1. 68' x 70'
and a driveway 14' wide along
set at all lot corners, 5'
1 on E line 6.3' from shore 1
shore, $\frac{1}{2}$ " square, all others
by 2" stakes, 18" long

See plat No.

Sylvan Glen Subd. Lot 3 of R. B. Gardner's Subd.

5-103 sk

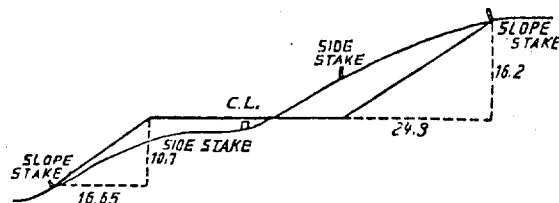

DISTANCES FROM SIDE STAKES FOR CROSS-SECTIONING.
SLOPE 1 1/2 TO 1. ROADWAY OF ANY WIDTH.

	0	.1	.2	.3	.4	.5	.6	.7	.8	.9	
0	0.00	0.15	0.30	0.45	0.60	0.75	0.90	1.05	1.20	1.35	0
1	1.50	1.65	1.80	1.95	2.10	2.25	2.40	2.55	2.70	2.85	1
2	3.00	3.15	3.30	3.45	3.60	3.75	3.90	4.05	4.20	4.35	2
50	75.00	75.15	75.30	75.45	75.60	75.75	75.90	76.05	76.20	76.35	50

Lot in N.W. 1/4 Section 16-1-17
Wit. for W. 1/4 Cor. { S. 32° W. B.O. 16" 33'
N. 32° W. B.O. 15" 132
N. 32° W

Wit. for E. 1/4 Cor. { S. 42° W. W.O. 10" 4226'
Iron sth N. 45° W. W.O. 11" 6314'

1320' W. of E. line E. Agr. Res. lot
Should be S.E. cor. of required
lot Stubbs & Wood

Cors. on Lake. W. line Sect. 13
No. 5 Wit. { B.O. 12" S. 63° E. 34.32'
W.O. 20" S. 24 1/2° W. 62.54'

Range line { Sug. 8" S. 46° E. 25.88'
Aspen 10" S. 36° W. 23.10'

These being east divisions and
interior N. & S. are supposed to be
full measure.

Lot 3 of R. Pardner's Sub. now
Sylvan Glen. is first lot west
of Harvard Club and 82' wide
Subdivided into ~~11~~ 11 lots
82' wide 50' x 68' except N. lot
and 14' drive on E side

Geo. Barber to H. R. Nichols. Begin at
an iron sth. 2 1/4 Cor. 16. W. 67° 58' 10" an
iron sth. thence W. 241.56' to an iron
sth. S. W. Cor Barber lot 1322' W. from E
1/4 Cor. to iron sth at E 1/8 Cor.

#5-103 Lk

8

84/021

5/10/74

4071

2

3

ard
Camp
iron
642.5 + 33
66.2

$$\begin{array}{r} 540 \\ \times 36 \\ \hline 3240 \\ 16200 \\ \hline 19440 \end{array}$$

642

J. G. Skeels
 Bessie Palmer
 July 20, 1921
 Scale 50' to 1"

Wood 5/16

Stone Pill

Subdivision
110' wide

4
Lot 4. Gardner
Subdivision
88.3' wide

Harvard
Camp

Lot 3. R. Gardner's Sub. of 1992

512 to City of Highway
612, 712

2364.2' To 1
17 p.p.c

Off. of public Highway

10442
To ctr of Sec W