

The map shows a property with a house and a shed. The house is a complex polygon with the following dimensions (clockwise from top-left): 12', 24.2', 9.4', 8', 10', 12.7', 3.5', 36.2', 24.3', and 12'. The shed is a rectangle measuring 10' by 10'. The gravel parking area is a rectangle measuring 25' by 10'. The property is bounded by a wire fence on the left and a gravel parking area on the right. The dimensions of the property are 151.60' (top), 145.00' (bottom), 49.88' (left), and 97.46' (right). The bearings are 90°04' (top-left), 89°49' (bottom-left), 82°21' (top-right), and 97°46' (bottom-right). The area is divided into three sections labeled 9, 10, and 11. The house is labeled 'HOUSE' and the shed is labeled 'SHED 10'.

49.88' (50')

90°04'

0.2'

0.4'

151.60'

SHED 10'

HOUSE

12'

24.2'

9.4'

8'

10'

12.7'

3.5'

36.2'

24.3'

12'

145.00'

97°46'

GRAVEL PARKING AREA

25'

CH. = 50.00' OVERHEAD UTILITIES ALONG LINE

AWEOGON ROAD


9

10

11

WIRE FENCE

LOT 10, BLOCK 6 OF INDIAN HILLS SUBDIVISION,  
LOCATED IN THE VILLAGE OF FONTANA-ON-GENEVA  
LAKE, WALWORTH COUNTY, WISCONSIN.

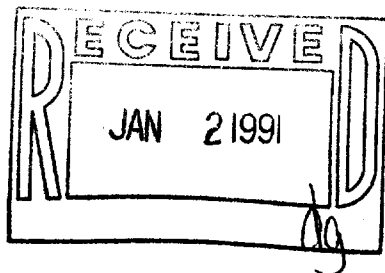

ORDERED BY: ANDREW F. ALLEN  
527 CENTER STREET  
LAKE GENEVA, WISCONSIN  
53147



I HEREBY CERTIFY THAT I HAVE SURVEYED THE ABOVE DESCRIBED PROPERTY AND THAT THE ABOVE MAP IS A TRUE REPRESENTATION THEREOF AND SHOWS THE SIZE AND LOCATION OF THE PROPERTY, ITS EXTERIOR BOUNDARIES, THE LOCATION OF ALL VISIBLE STRUCTURES AND DIMENSIONS OF ALL PRINCIPAL BUILDINGS THEREON, BOUNDARY FENCES, APPARENT EASEMENTS AND ROADWAYS AND VISIBLE ENCROACHMENTS, IF ANY.

THIS SURVEY IS MADE FOR THE EXCLUSIVE USE OF THE PRESENT OWNERS OF THE PROPERTY, AND ALSO THOSE WHO PURCHASE, MORTGAGE, OR GUARANTEE THE TITLE THERETO WITHIN ONE (1) YEAR FROM DATE HEREOF.

- Robert M. Baerenwald  
ROBERT M. BAERENWALD  
WISCONSIN REGISTERED LAND SURVEYOR, S-1508

DATE Aug. 9, 1989 JOB NO. 2087

NOTE: THIS IS NOT A CERTIFIED COPY UNLESS SEALED.