


GEORGE T. DUNHAM
SURVEYING & SUBDIVIDING
DELAVER, WISCONSIN

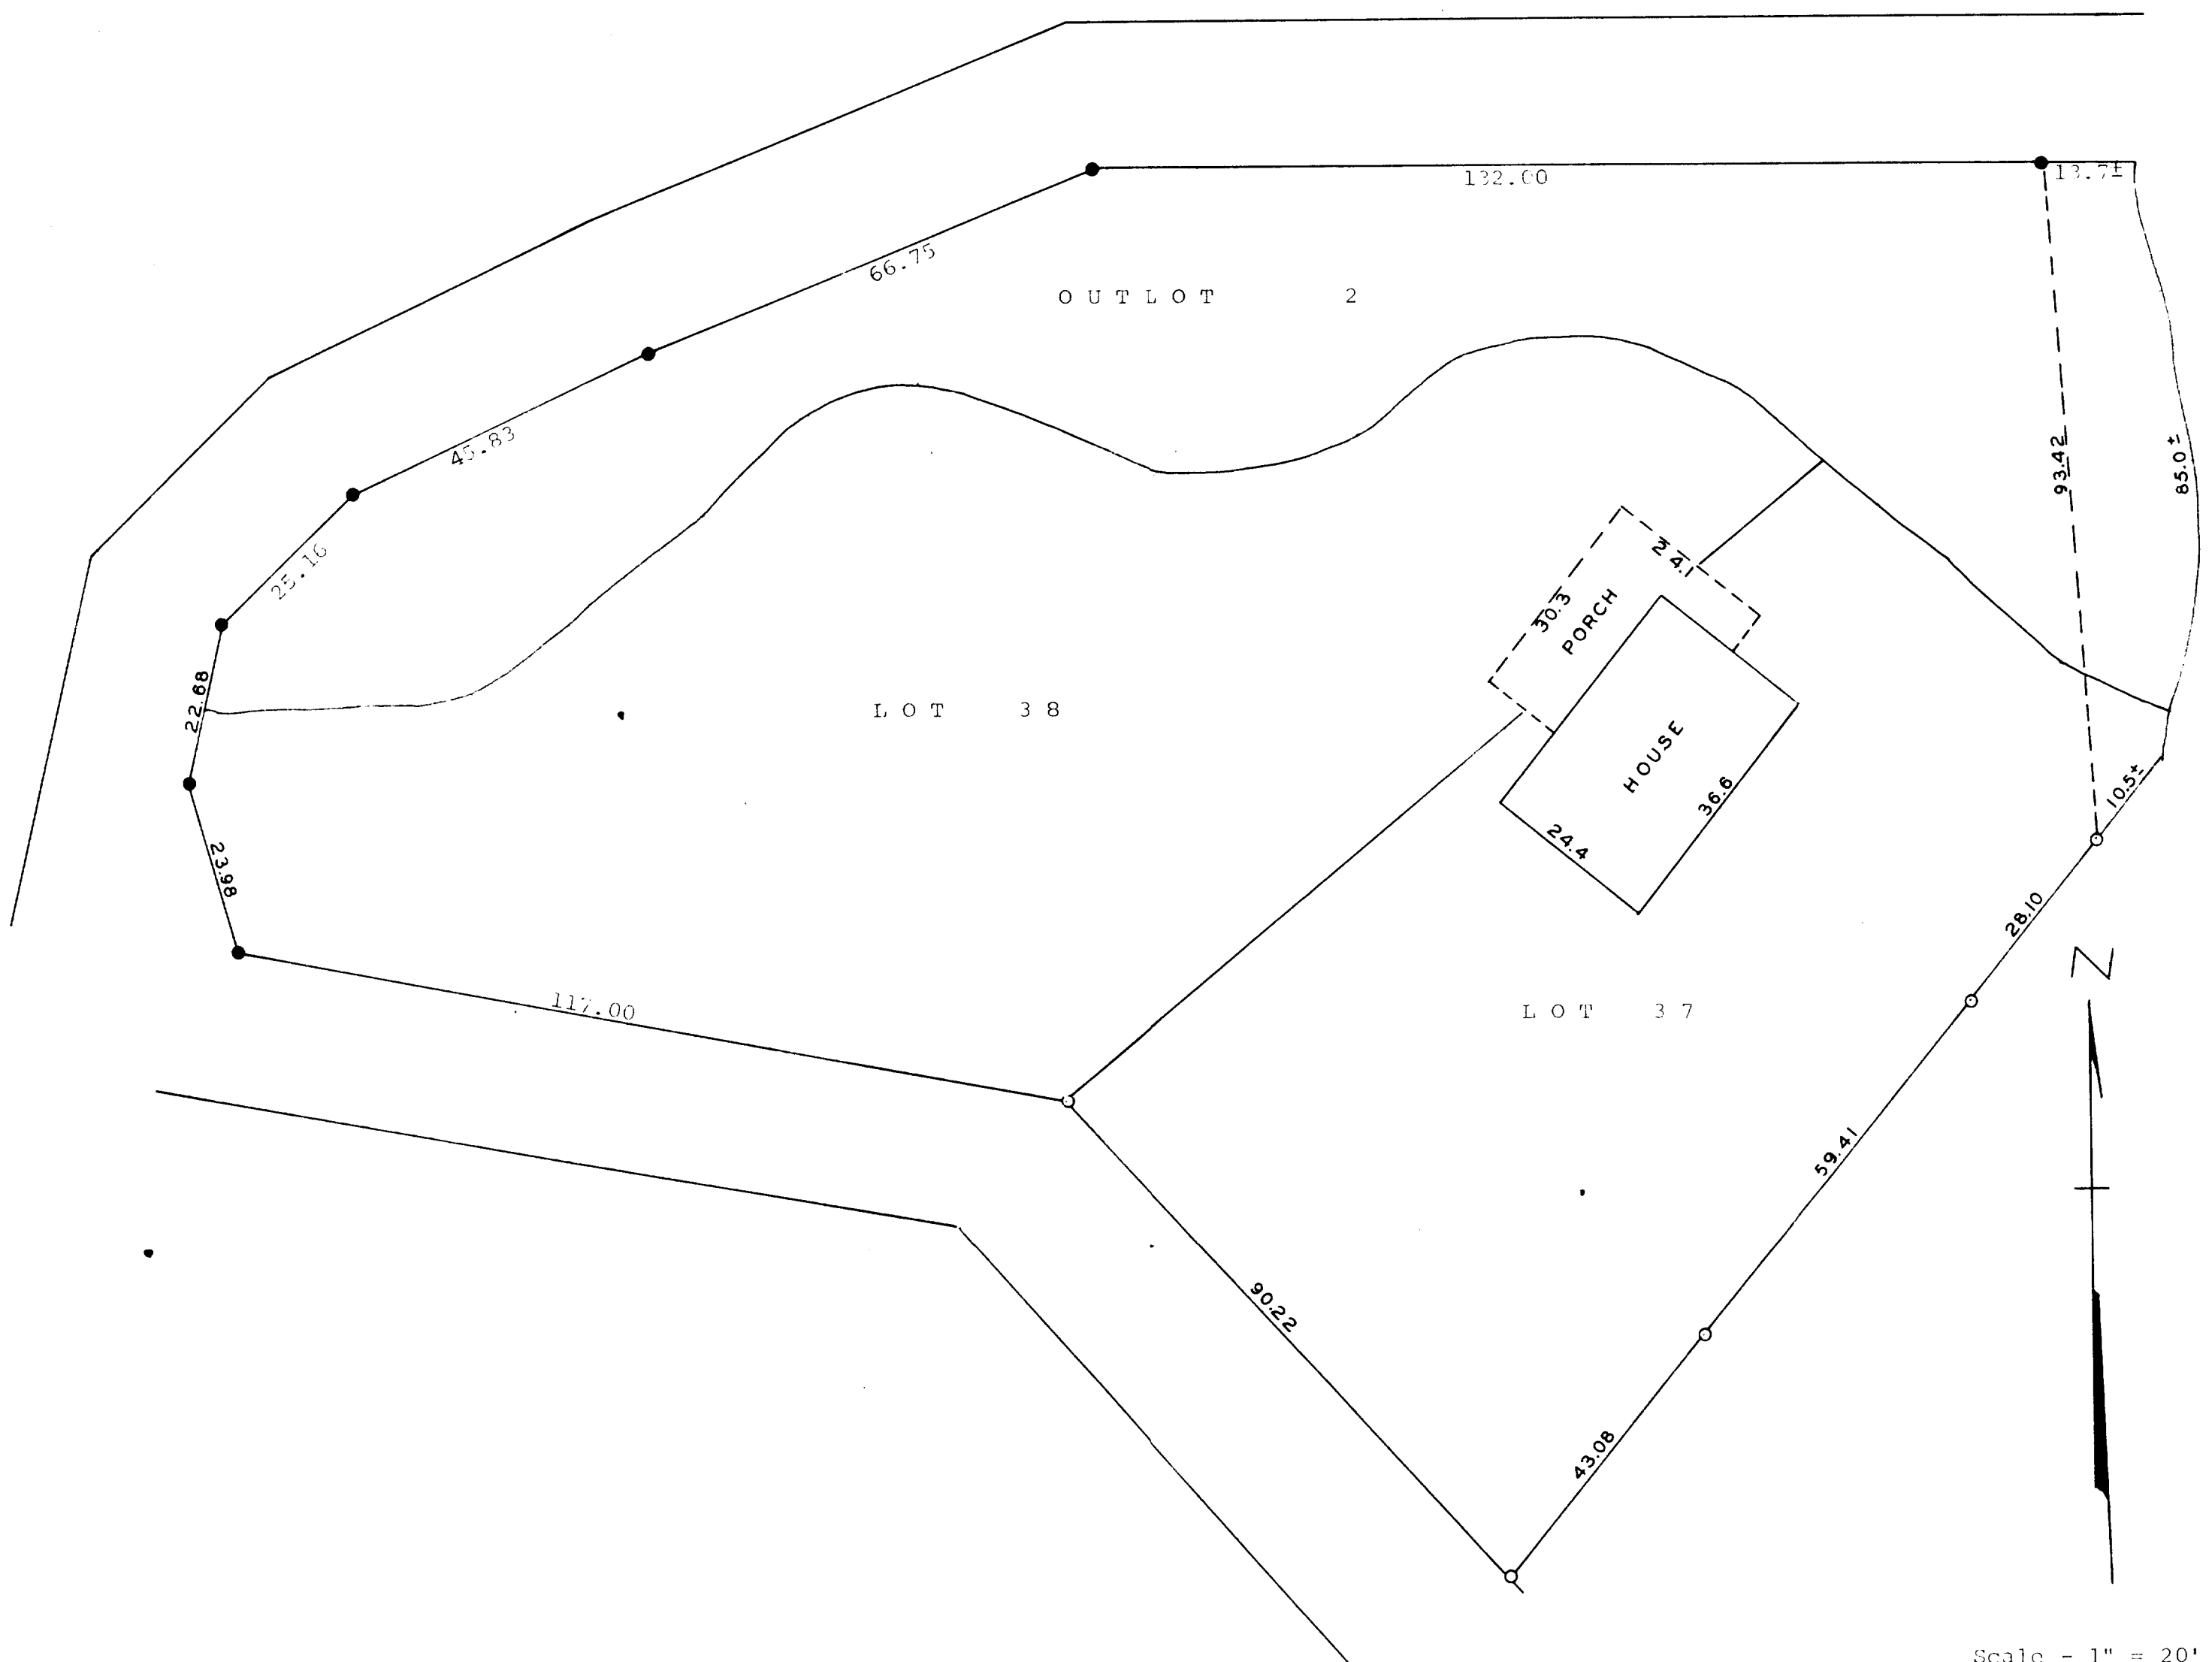

Scale - 1" = 20'
○ = Iron Pipe
● = Concrete Monument

Plat of survey of Lots 37 and 38 and Outlot No. 2 in
the Revised Plat of The Gardens, located in the Village
of Fontana on Geneva Lake, Walworth County, Wisconsin.
August 23, 1968

George T. Dunham
George T. Dunham, Surveyor