

PLAT OF SURVEY OF UNIT 2 LOT 124, COUNTRY CLUB ESTATES LOCATED IN VILLAGE OF FONTANA, NW 1/4 SEC. 23, T1N, R16E WALWORTH COUNTY, WISCONSIN


JENSEN SURVEYING & MAPPING S.C.

PO BOX 322 ELKHORN, WISCONSIN 53121 45 S. WISCONSIN ST.

PHONE: (414) 723-3434

MAPPING DATE: SEPT 20, 1984

REVISED: Nov. 9, 1989.

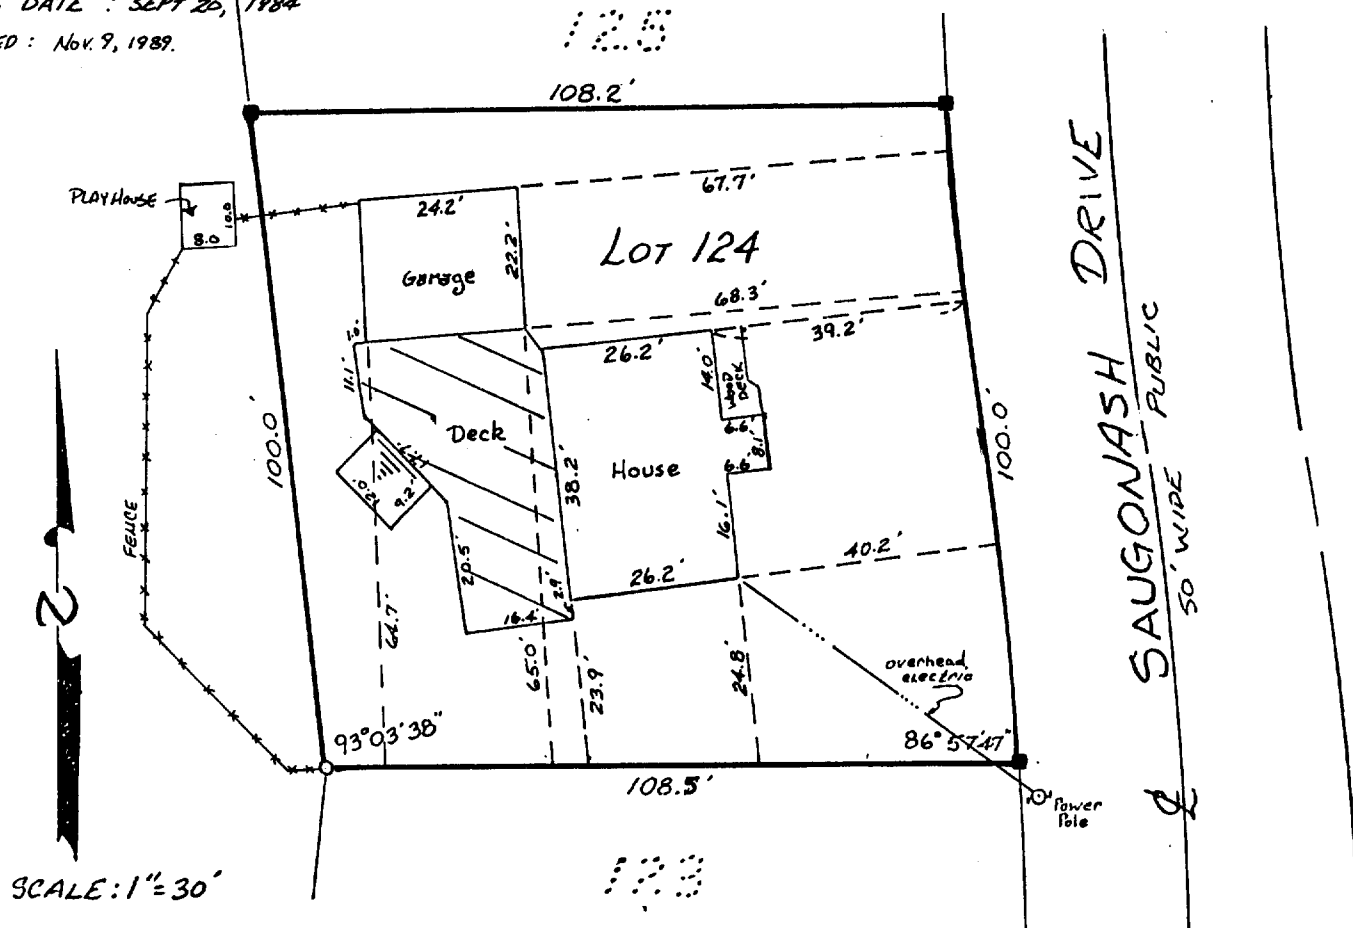

SCALE: 1" = 30'


LEGEND

- ~ FOUND IRON PIPE
- ~ FOUND CONCRETE MONUMENT



SURVEYED FOR: JACKIE RUST
RT#3 Box 56F

FONTANA, WISCONSIN 53125

JOHN LAW • LAKESHORE REAL ESTATE
106 BROAD STREET
LAKE GENEVA, WISCONSIN 53147

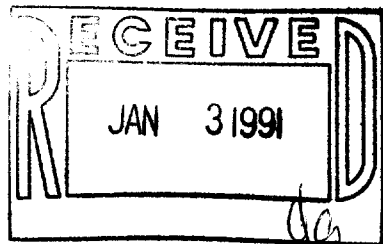

I HEREBY CERTIFY THAT THE ABOVE
DESCRIBED PROPERTY HAS BEEN SURVEYED UNDER
MY DIRECTION THAT THE PLAT SHOWN HEREON IS
AN ACCURATE SURVEY, A TRUE REPRESENTATION THEREOF
CORRECTLY SHOWS THE EXTERIOR BOUNDARY LINES ON
SAID PROPERTY AND CORRECT MEASUREMENTS THEREOF
AND BUILDINGS THEREON.

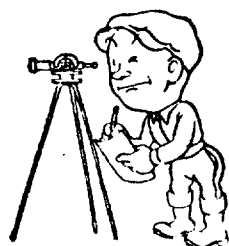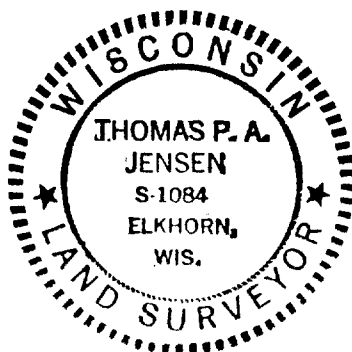

Thomas P.A. Jensen
THOMAS P.A. JENSEN RLS #1084

1984.063 X

1989.143

005-1089

SC02 00117