


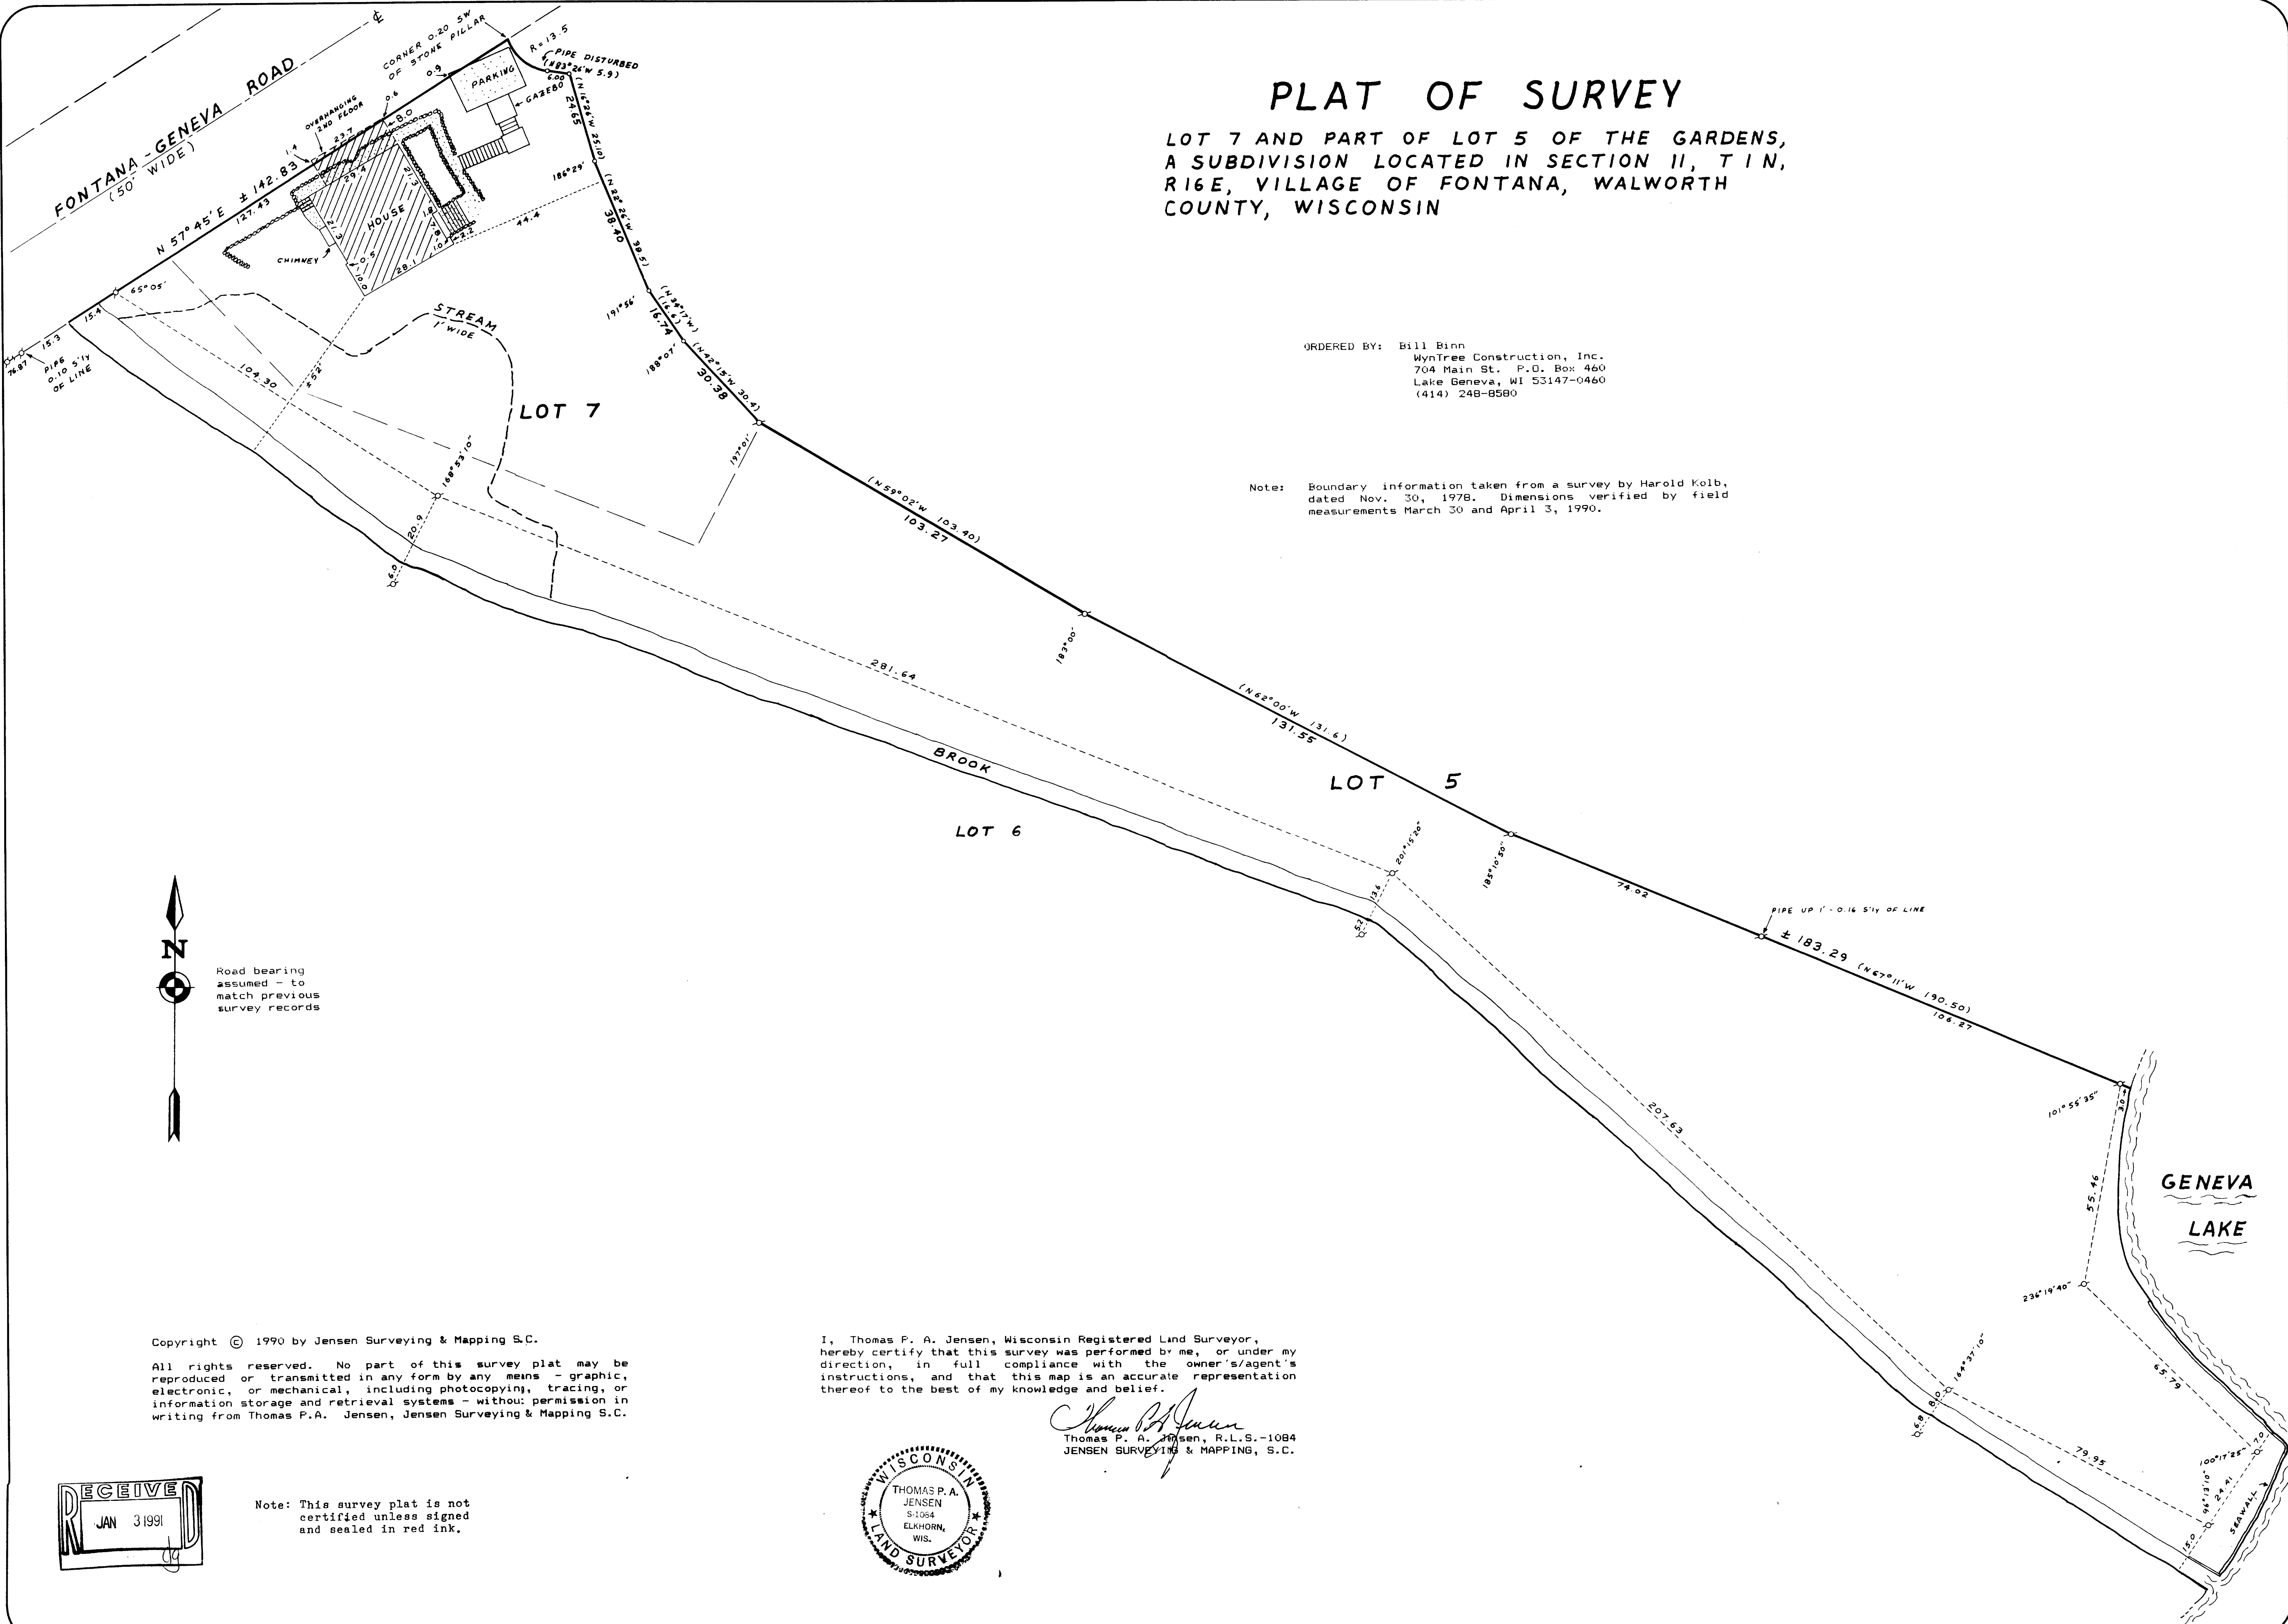

PLAT OF SURVEY

LOT 7 AND PART OF LOT 5 OF THE GARDENS,  
A SUBDIVISION LOCATED IN SECTION 11, T 1 N,  
R 16 E, VILLAGE OF FONTANA, WALWORTH  
COUNTY, WISCONSIN

ORDERED BY: Bill Binn  
WynTree Construction, Inc.  
704 Main St. P.O. Box 460  
Lake Geneva, WI 53147-0460  
(414) 248-8580

Note: Boundary information taken from a survey by Harold Kolb,  
dated Nov. 30, 1978. Dimensions verified by field  
measurements March 30 and April 3, 1990.




Road bearing  
assumed - to  
match previous  
survey records


Copyright © 1990 by Jensen Surveying & Mapping S.C.  
All rights reserved. No part of this survey plat may be  
reproduced or transmitted in any form by any means - graphic,  
electronic, or mechanical, including photocopying, tracing, or  
information storage and retrieval systems - without permission in  
writing from Thomas P.A. Jensen, Jensen Surveying & Mapping S.C.

I, Thomas P. A. Jensen, Wisconsin Registered Land Surveyor,  
hereby certify that this survey was performed by me, or under my  
direction, in full compliance with the owner's/agent's  
instructions, and that this map is an accurate representation  
thereof to the best of my knowledge and belief.

*Thomas P. A. Jensen*  
Thomas P. A. Jensen, R.L.S.-1084  
JENSEN SURVEYING & MAPPING, S.C.

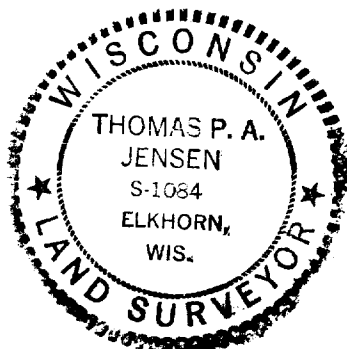

Note: This survey plat is not  
certified unless signed  
and sealed in red ink.

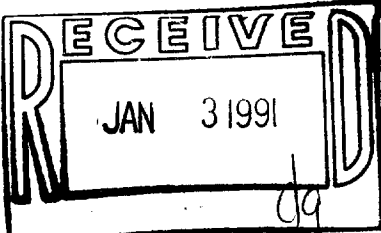

|                                                                                                                         |                           |
|-------------------------------------------------------------------------------------------------------------------------|---------------------------|
| Mapping date: 4-5-1990                                                                                                  |                           |
| Revisions:                                                                                                              |                           |
| Scale: 1" = 20'                                                                                                         |                           |
|                                                                                                                         |                           |
|                                                                                                                         |                           |
| JENSEN SURVEYING & MAPPING S.C.<br>45 South Wisconsin Street P.O. Box 322<br>Elkhorn, Wisconsin 53121<br>(414) 723-3434 |                           |
| Legend                                                                                                                  | Legend                    |
| FOUND IRON PIPE - 1/2" DIA.                                                                                             | FOUND IRON PIPE - 1" DIA. |
| ( ) RECORDED DIMENSION                                                                                                  | STONE WALL                |
| CONCRETE SURFACE                                                                                                        |                           |
| Sheet no. 1 of 1 sheets.                                                                                                | Job reference number      |
|                                                                                                                         | 1990.030                  |
| 1990.030                                                                                                                |                           |

045-1095

SG 04445