

PLAT OF SURVEY OF

A part of a parcel of land located in the NE 1/4 of Section 13, T1N, R16E, being in Outlot 63 and being part of Tax Parcels FV-93 and FV-94 of the Assessor's Plat of the Village of Fontana-on-Geneva Lake, Walworth County, Wisconsin.


JENSEN SURVEYING & MAPPING S.C.
45 South Wisconsin Street P.O. Box 322
Elkhorn, Wisconsin 53121
(414) 723-3434



SURVEYED FOR: KATHERINE E. CAMPBELL
LAROWE & GERLACH, S.C.
110 MAIN ST. PO BOX 231
REEDSBURG, WI 53959-0231




BEARINGS ARE REFERENCED TO
PREVIOUS SURVEYS OF RECORD

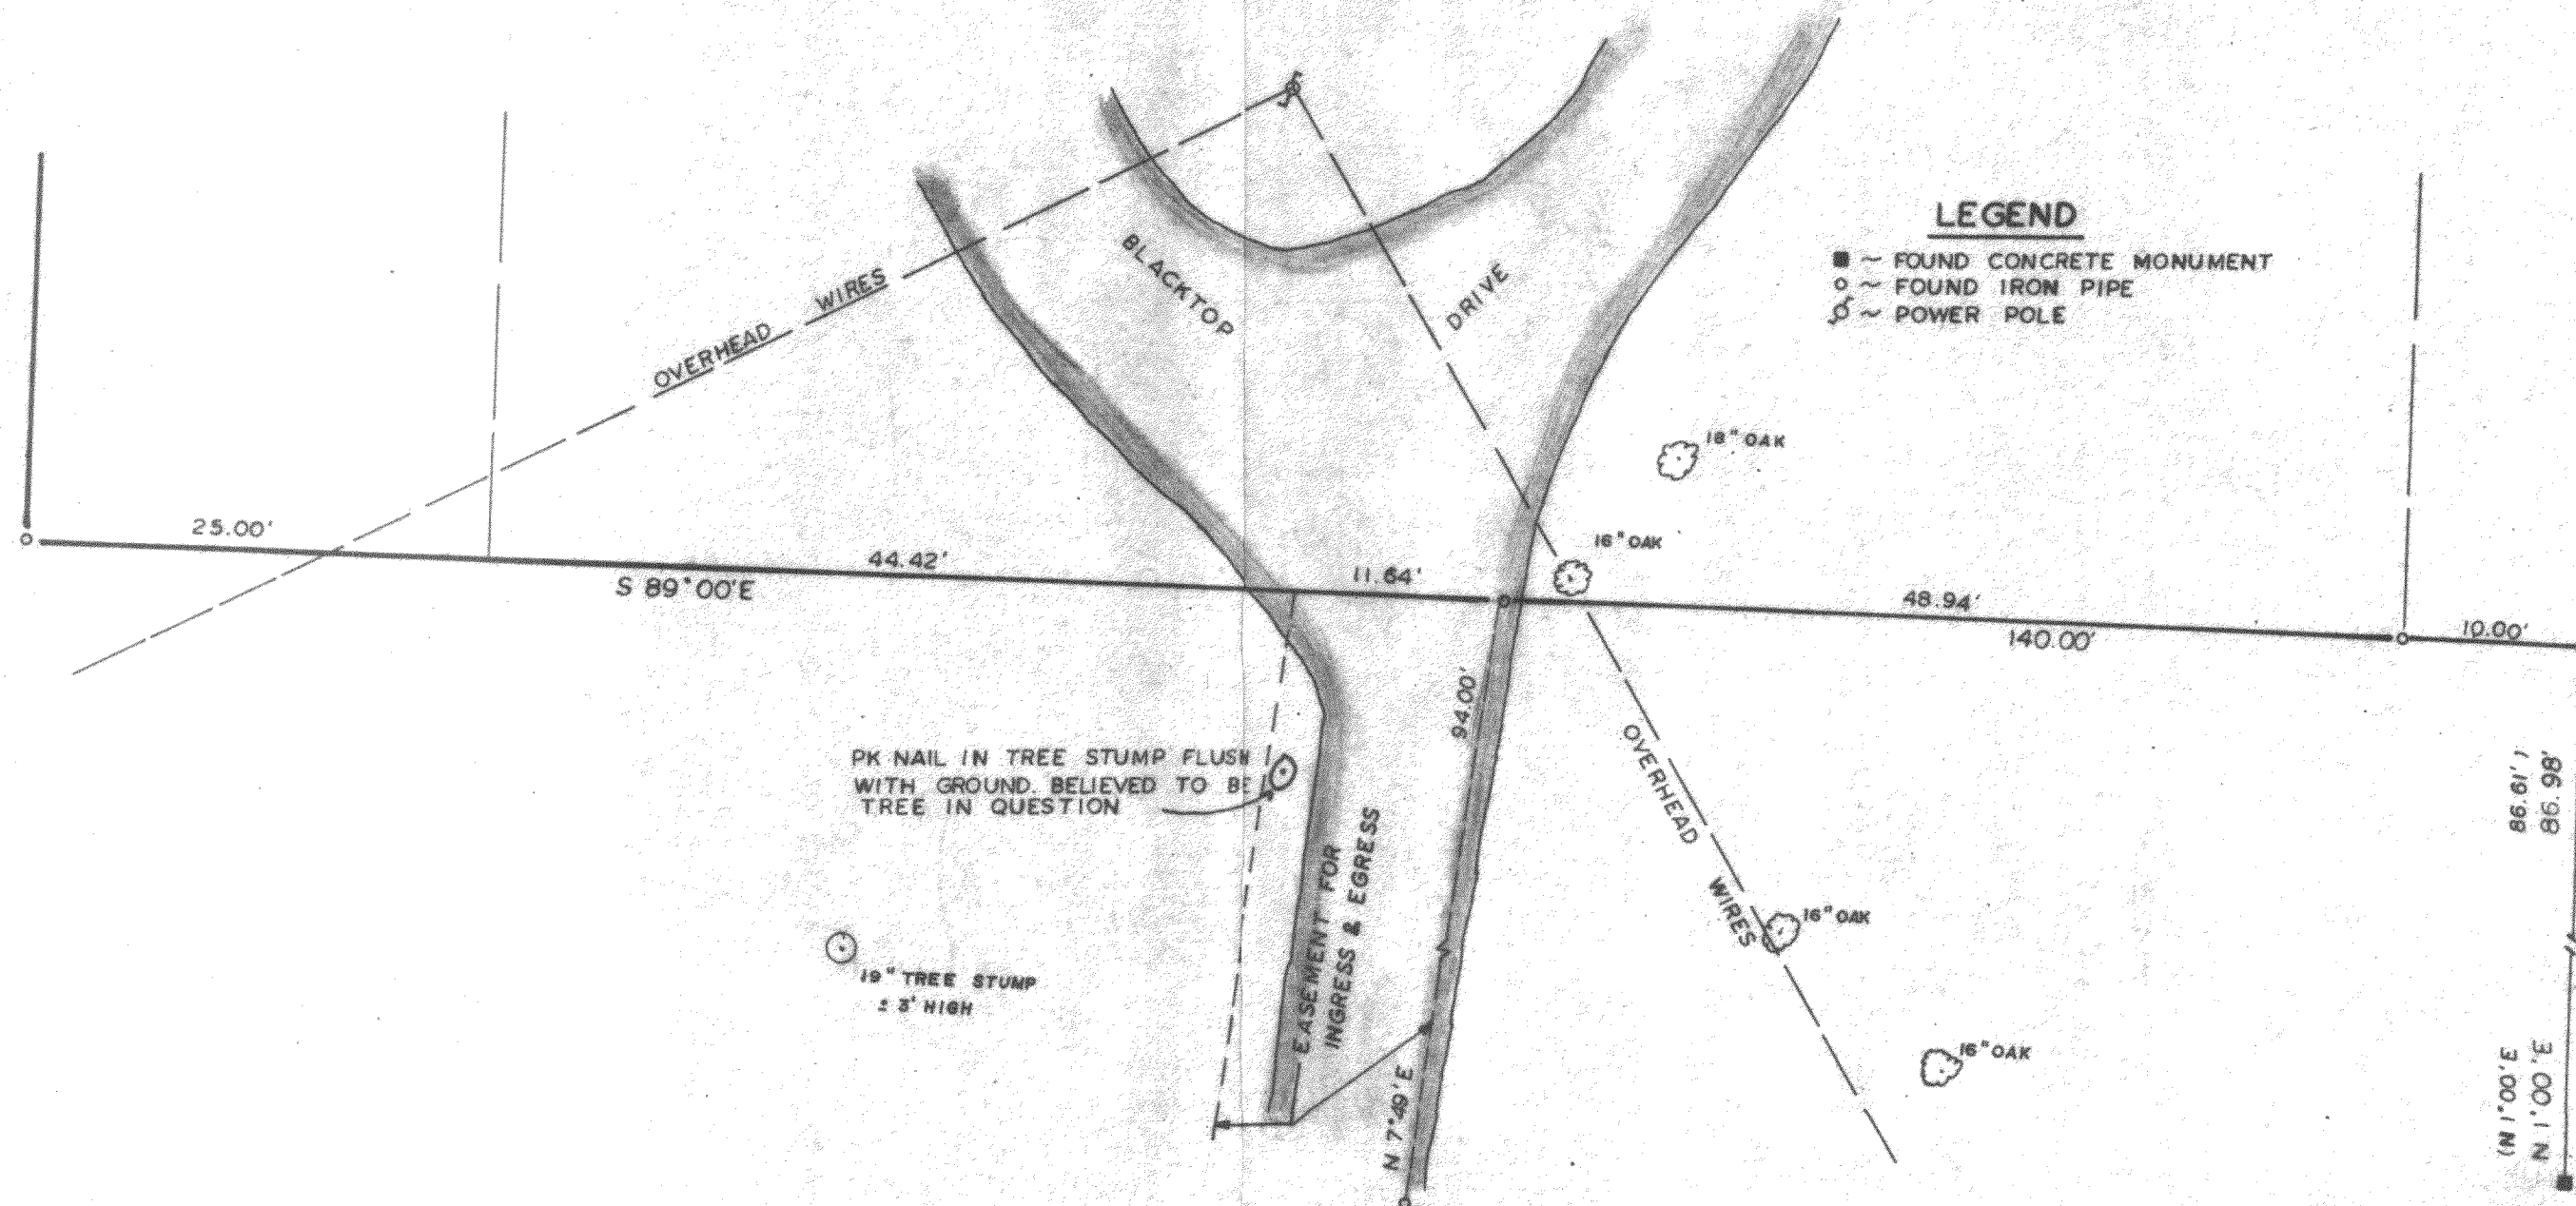

LEGEND

- ~ FOUND CONCRETE MONUMENT
- ~ FOUND IRON PIPE
- ⊙ ~ POWER POLE

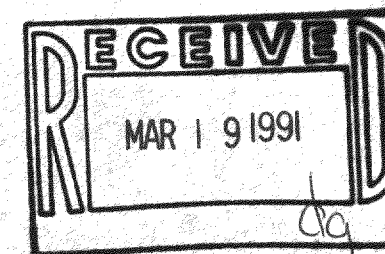

SCALE - 1" = 10'

MAPPING DATE- 10/01/90

I, Thomas P.A. Jensen, Wisconsin Registered Land Surveyor, do hereby certify that this survey was performed by me, or under my direction, in full compliance with the owner's/agent's instructions and Chapter A-E 7 of the Wisconsin Administrative Code "Minimum Standards For Property Surveys"; and that this map is an accurate representation thereof to the best of my knowledge and belief.

Thomas P.A. Jensen R.L.S-1084
Jensen Surveying & Mapping S.C.

Note: This survey plat is not certified unless signed and sealed in red ink.

STFV 00093
STFV 00094

Copyright © 1990 by Jensen Surveying & Mapping S.C.

All rights reserved. No part of this survey plat may be reproduced or transmitted in any form by any means - graphic, electronic, or mechanical, including photocopying, tracing, or information storage and retrieval systems - without permission in writing from Thomas P.A. Jensen, Jensen Surveying & Mapping S.C.

1990-140

005-1098