


GEORGE T. DUNHAM
SURVEYING & SUBDIVIDING
DELAVAN, WISCONSIN

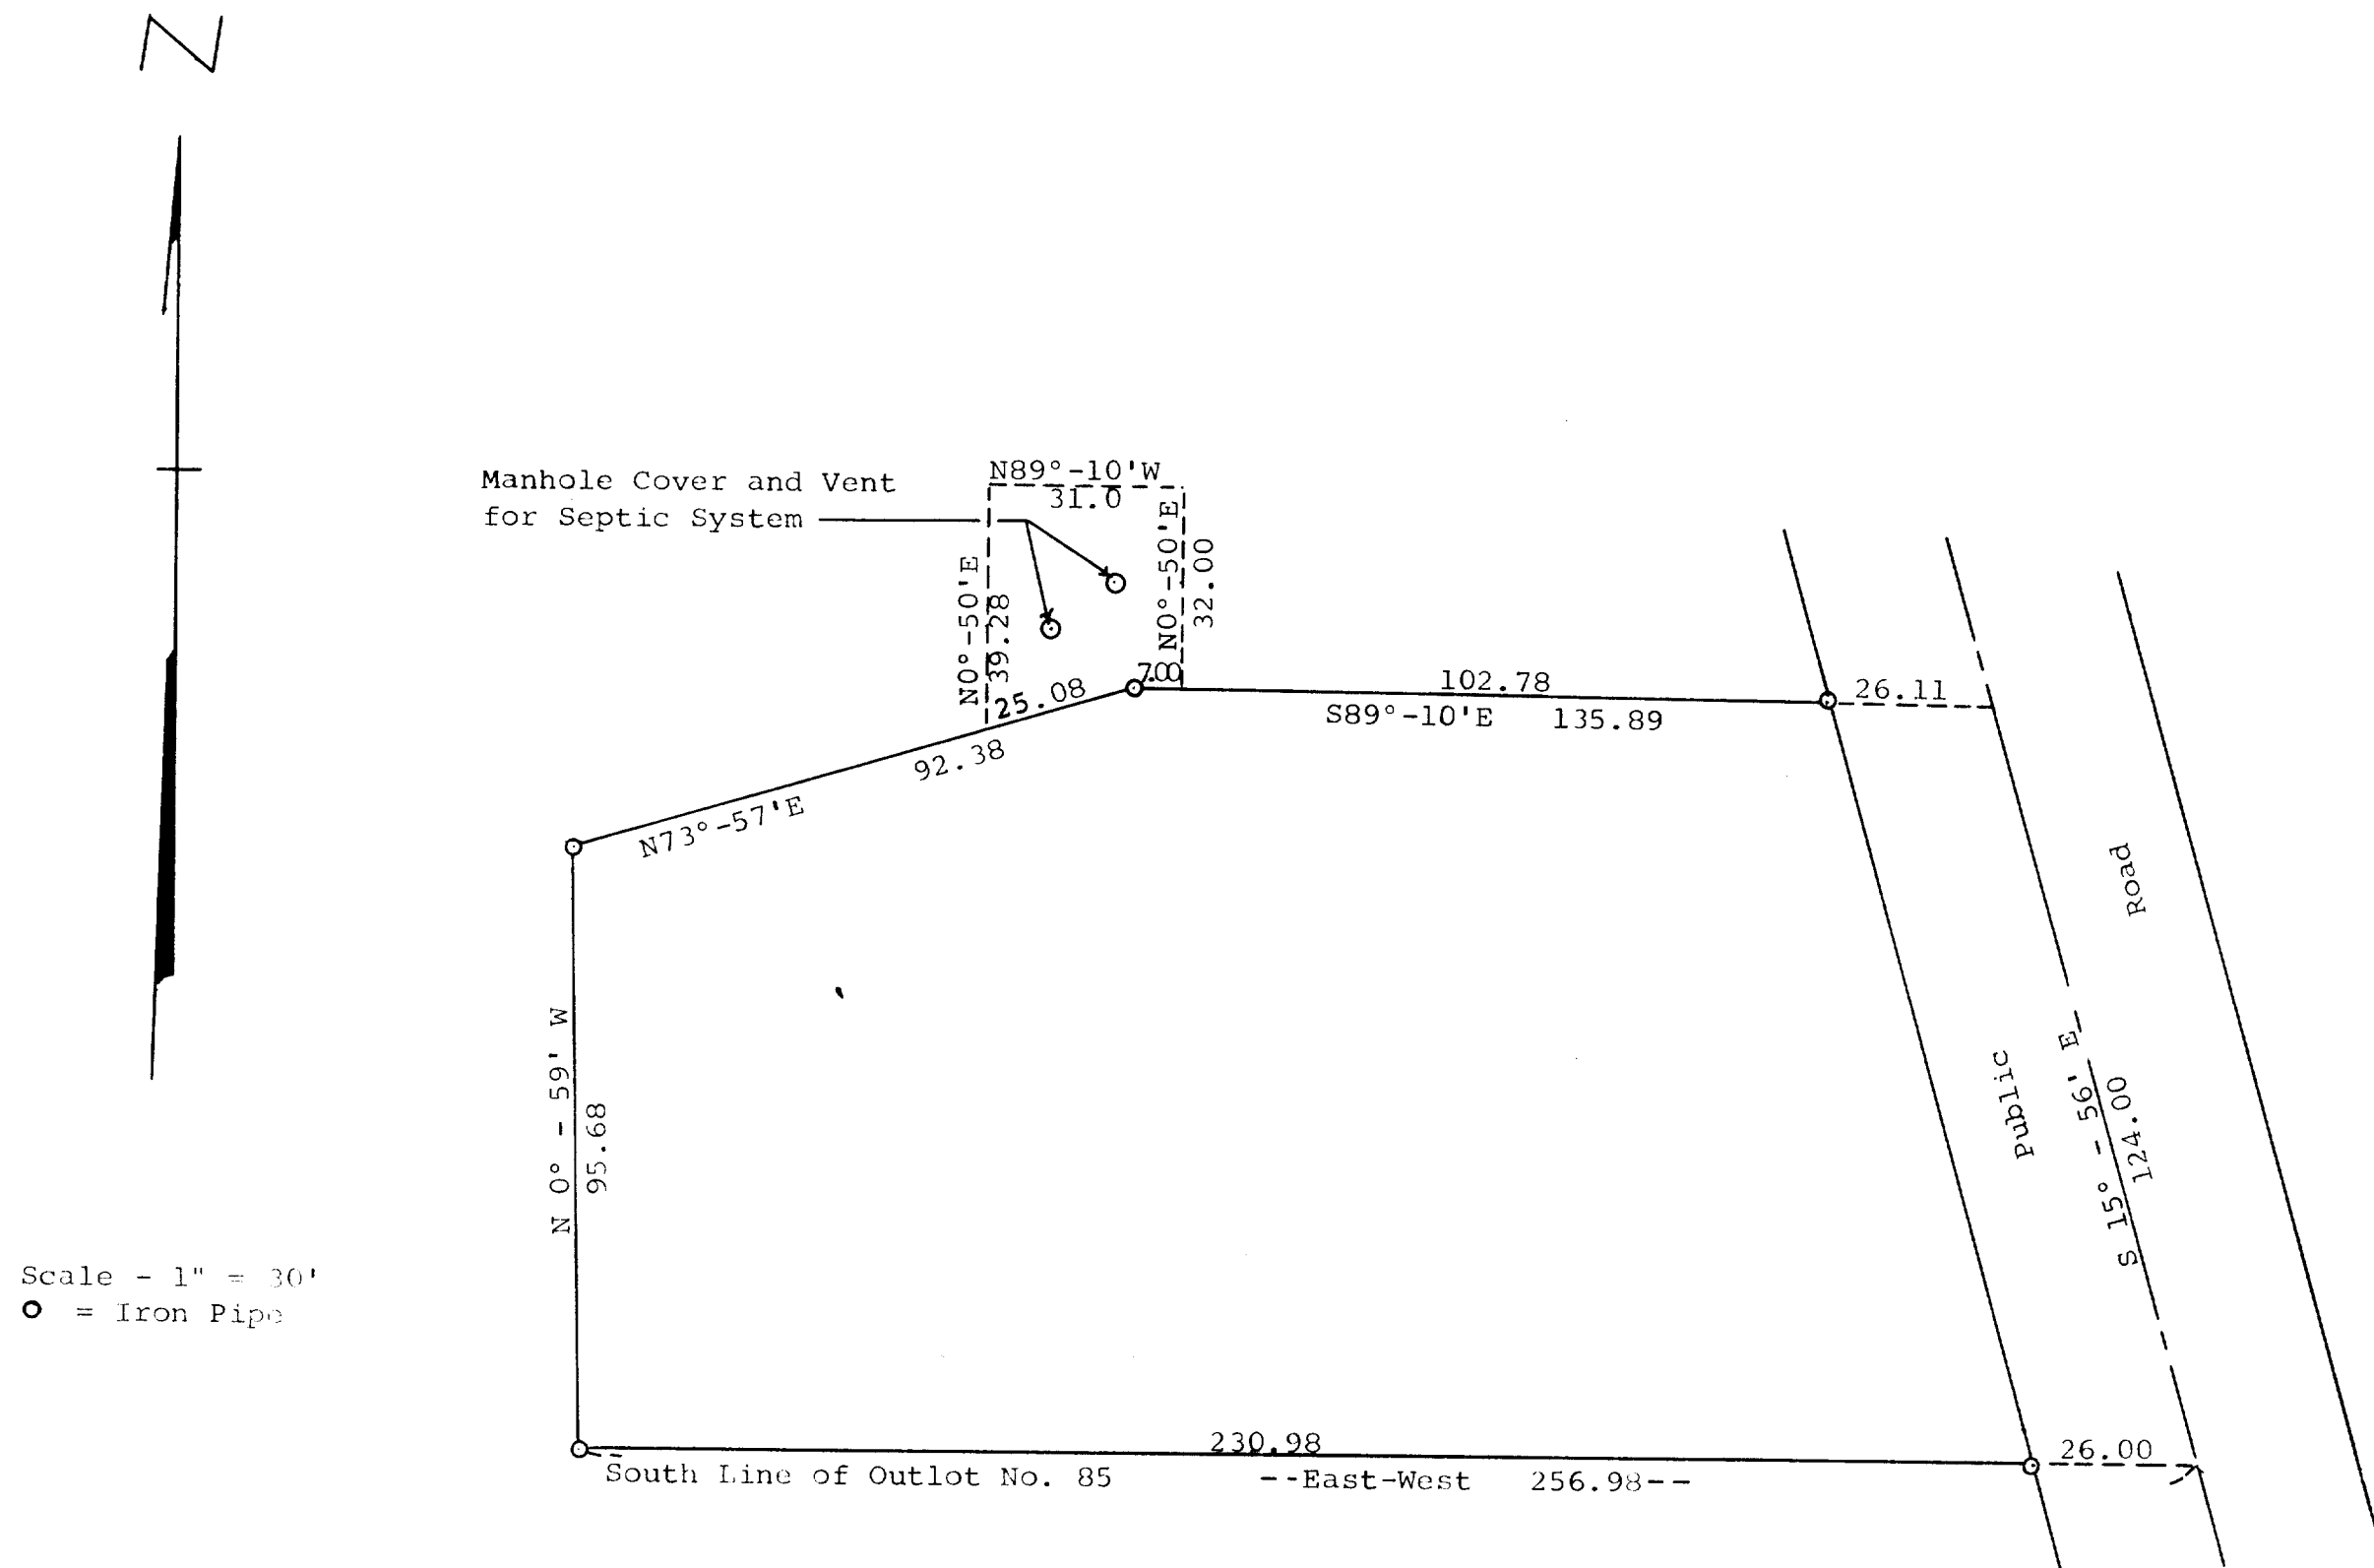

Plat of survey of a parcel of land located in Outlot 85
of the Fontana-on-Geneva Lake Assessors Plat, Village of
Fontana, Walworth County, Wisconsin.
June 14, 1968

George T. Dunham
George T. Dunham, Surveyor 5-110

STFV-131A