





LEGEND

Ø-IRON PIPE FOUND
O-IRON PIPE SET
()-AS RECORDED

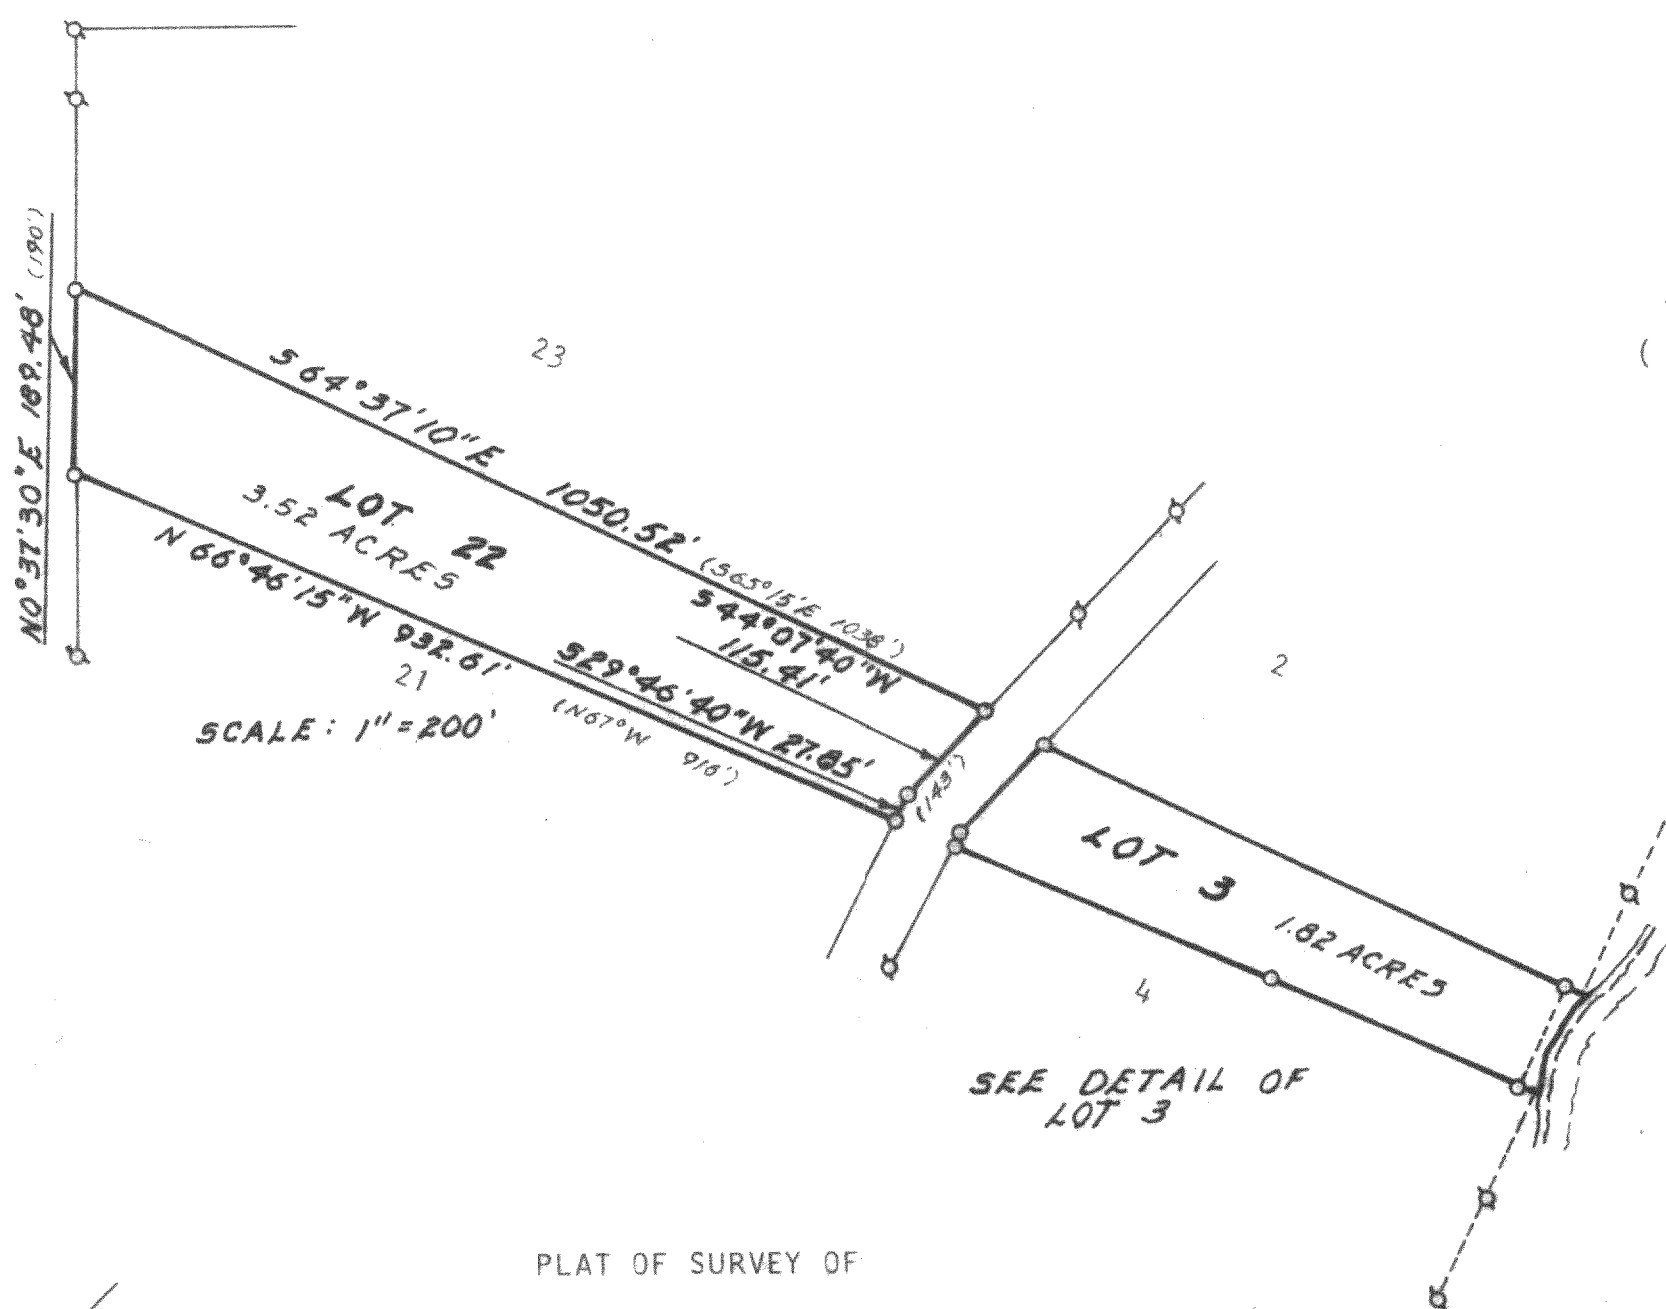

PLAT OF SURVEY OF


LOTS 3 AND 22 OF STEARNS AND GEROLDS SUBDIVISION
LOCATED IN THE VILLAGE OF FONTANA ON GENEVA LAKE,
WALWORTH COUNTY, WISCONSIN.

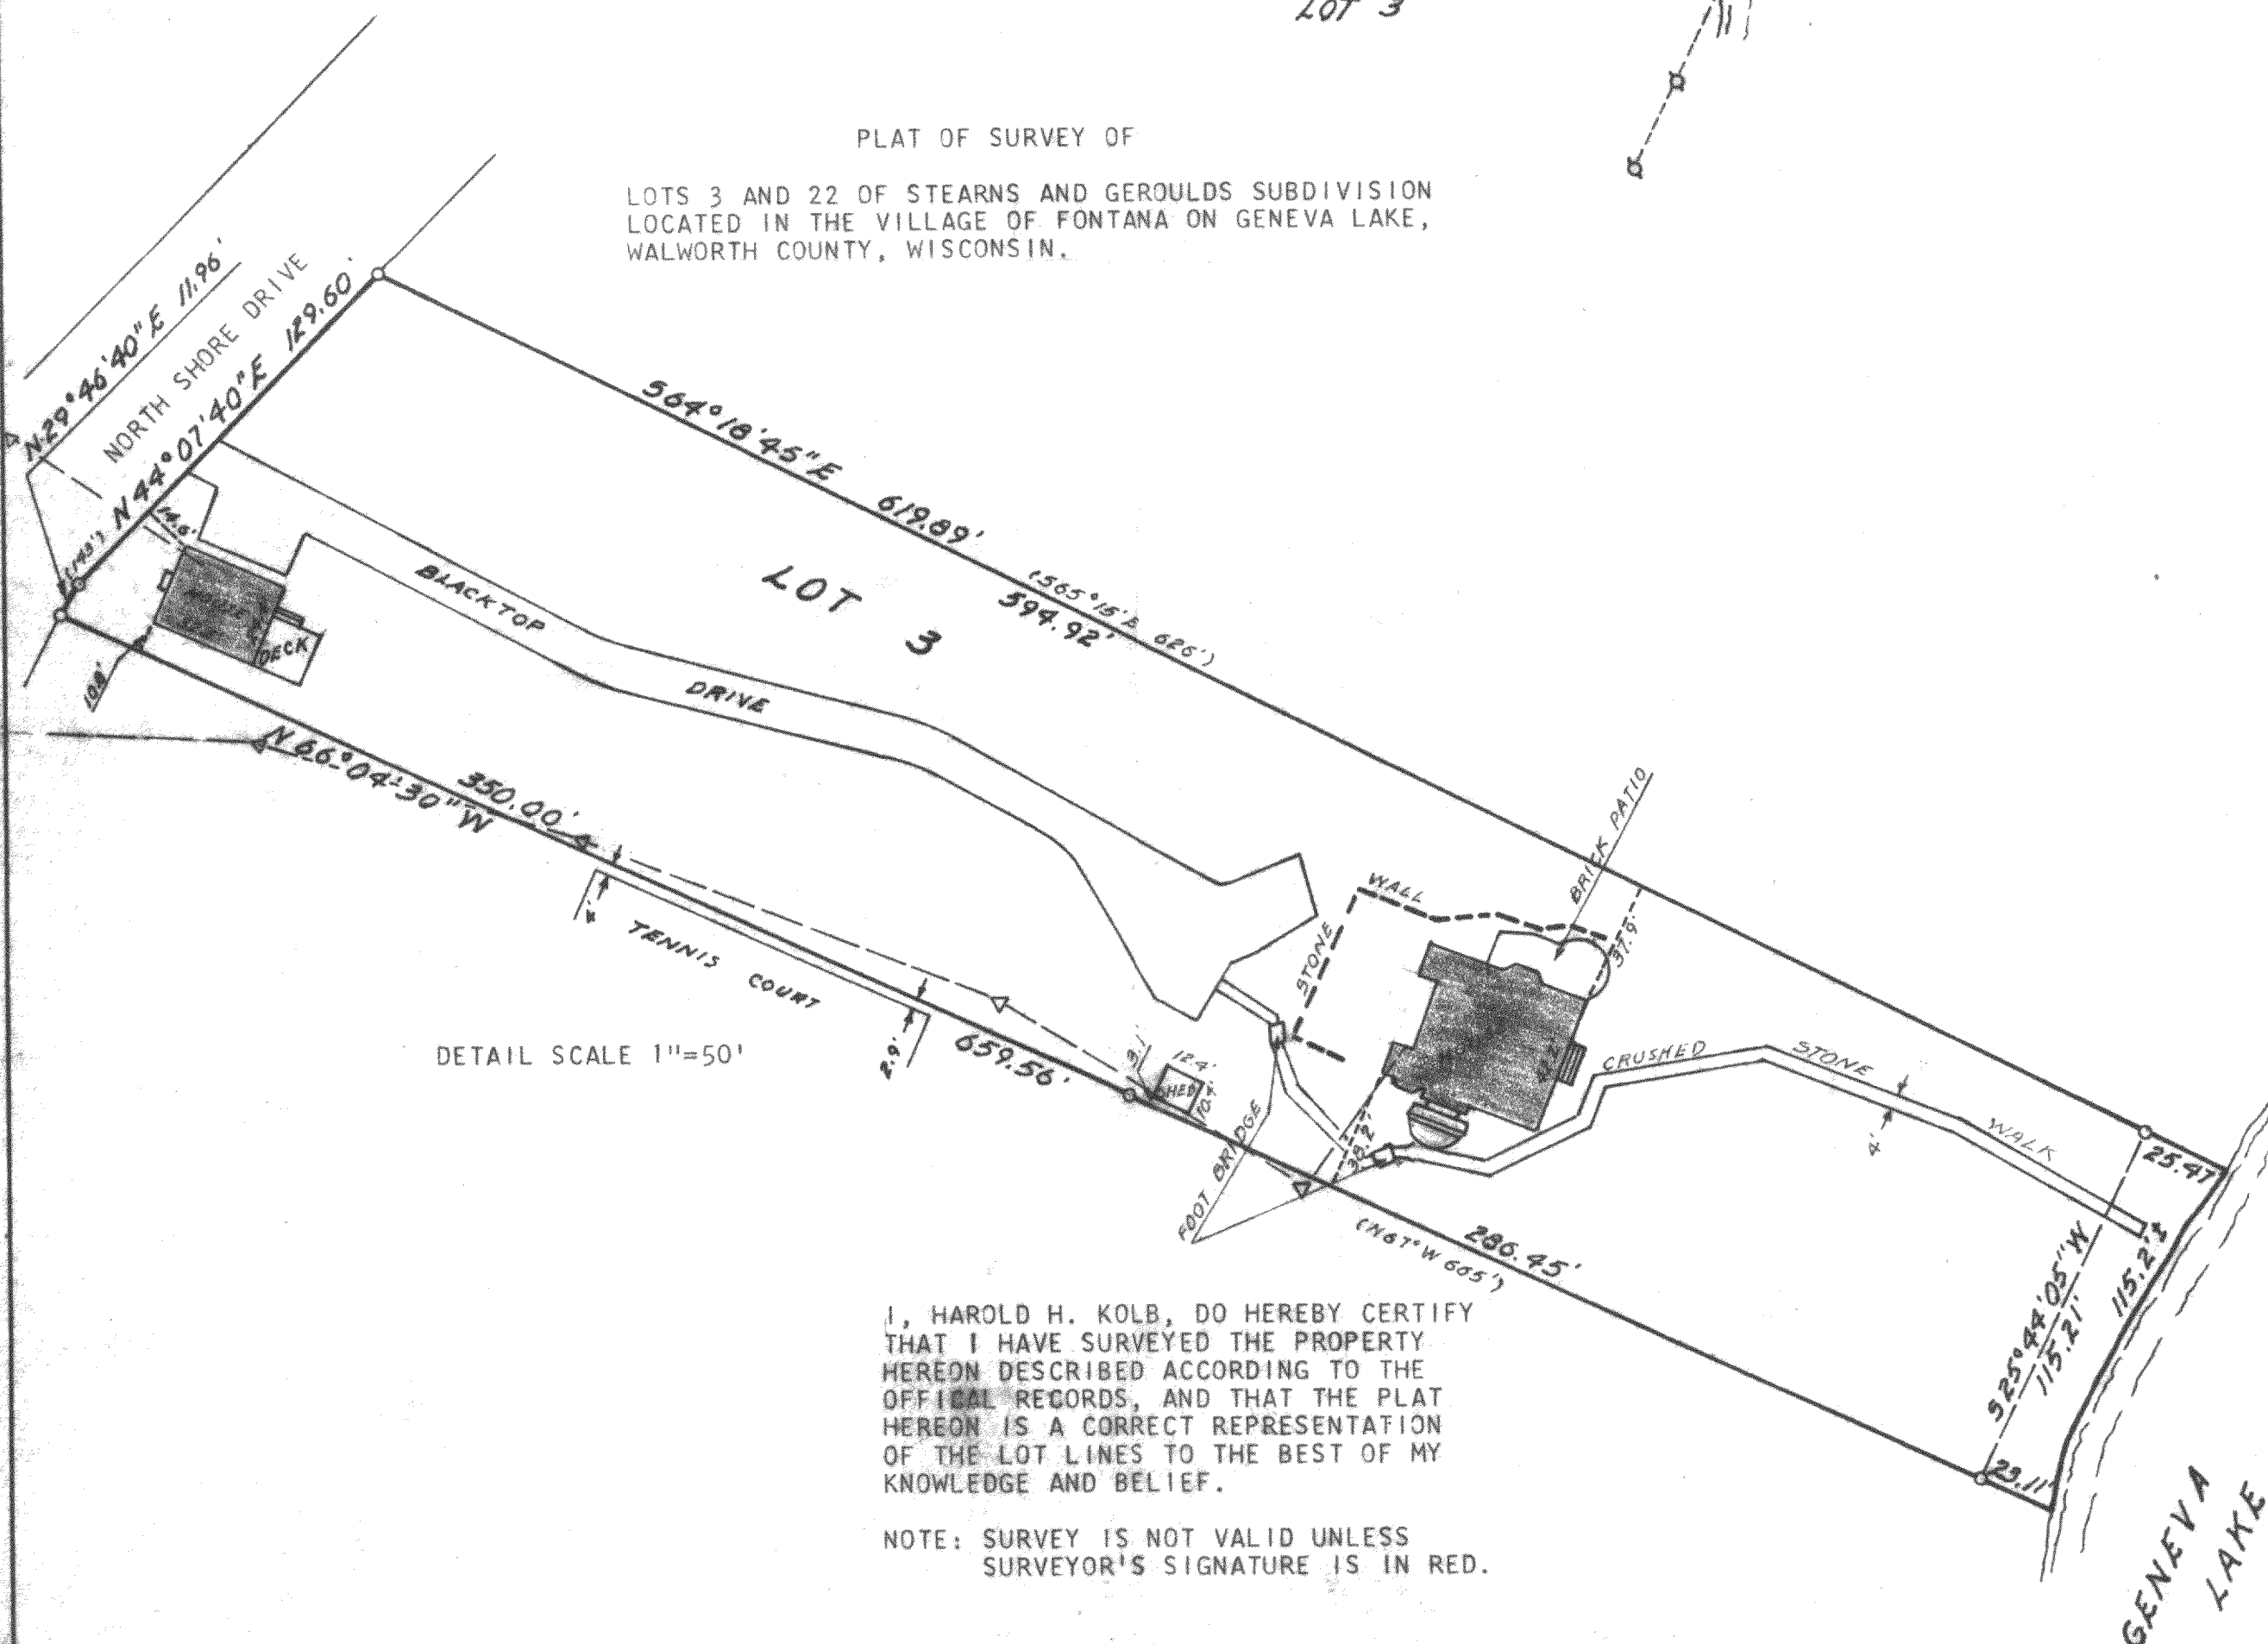

I, HAROLD H. KOLB, DO HEREBY CERTIFY
THAT I HAVE SURVEYED THE PROPERTY
HEREON DESCRIBED ACCORDING TO THE
OFFICIAL RECORDS, AND THAT THE PLAT
HEREON IS A CORRECT REPRESENTATION
OF THE LOT LINES TO THE BEST OF MY
KNOWLEDGE AND BELIEF.

NOTE: SURVEY IS NOT VALID UNLESS
SURVEYOR'S SIGNATURE IS IN RED.

HAROLD H. KOLB
WISCONSIN REGISTERED LAND SURVEYOR, S-187
DATE MAY 18, 1990

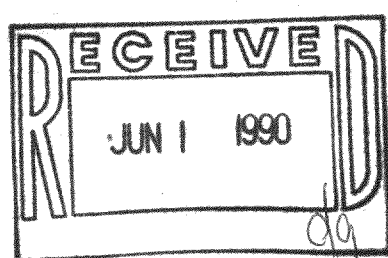

SS40 00002
SS40 00015

005-1102