


PLAT OF SURVEY

LOTS 18 AND 19 OF BLOCK 4 OF
INDIAN HILLS FIRST ADDITION,
LOCATED IN THE VILLAGE OF
FONTANA, WALWORTH COUNTY,
WISCONSIN.

OWNERS: JOHN AND CHERYL MICK
RT. 1 BOX 281C
FONTANA, WI. 53125

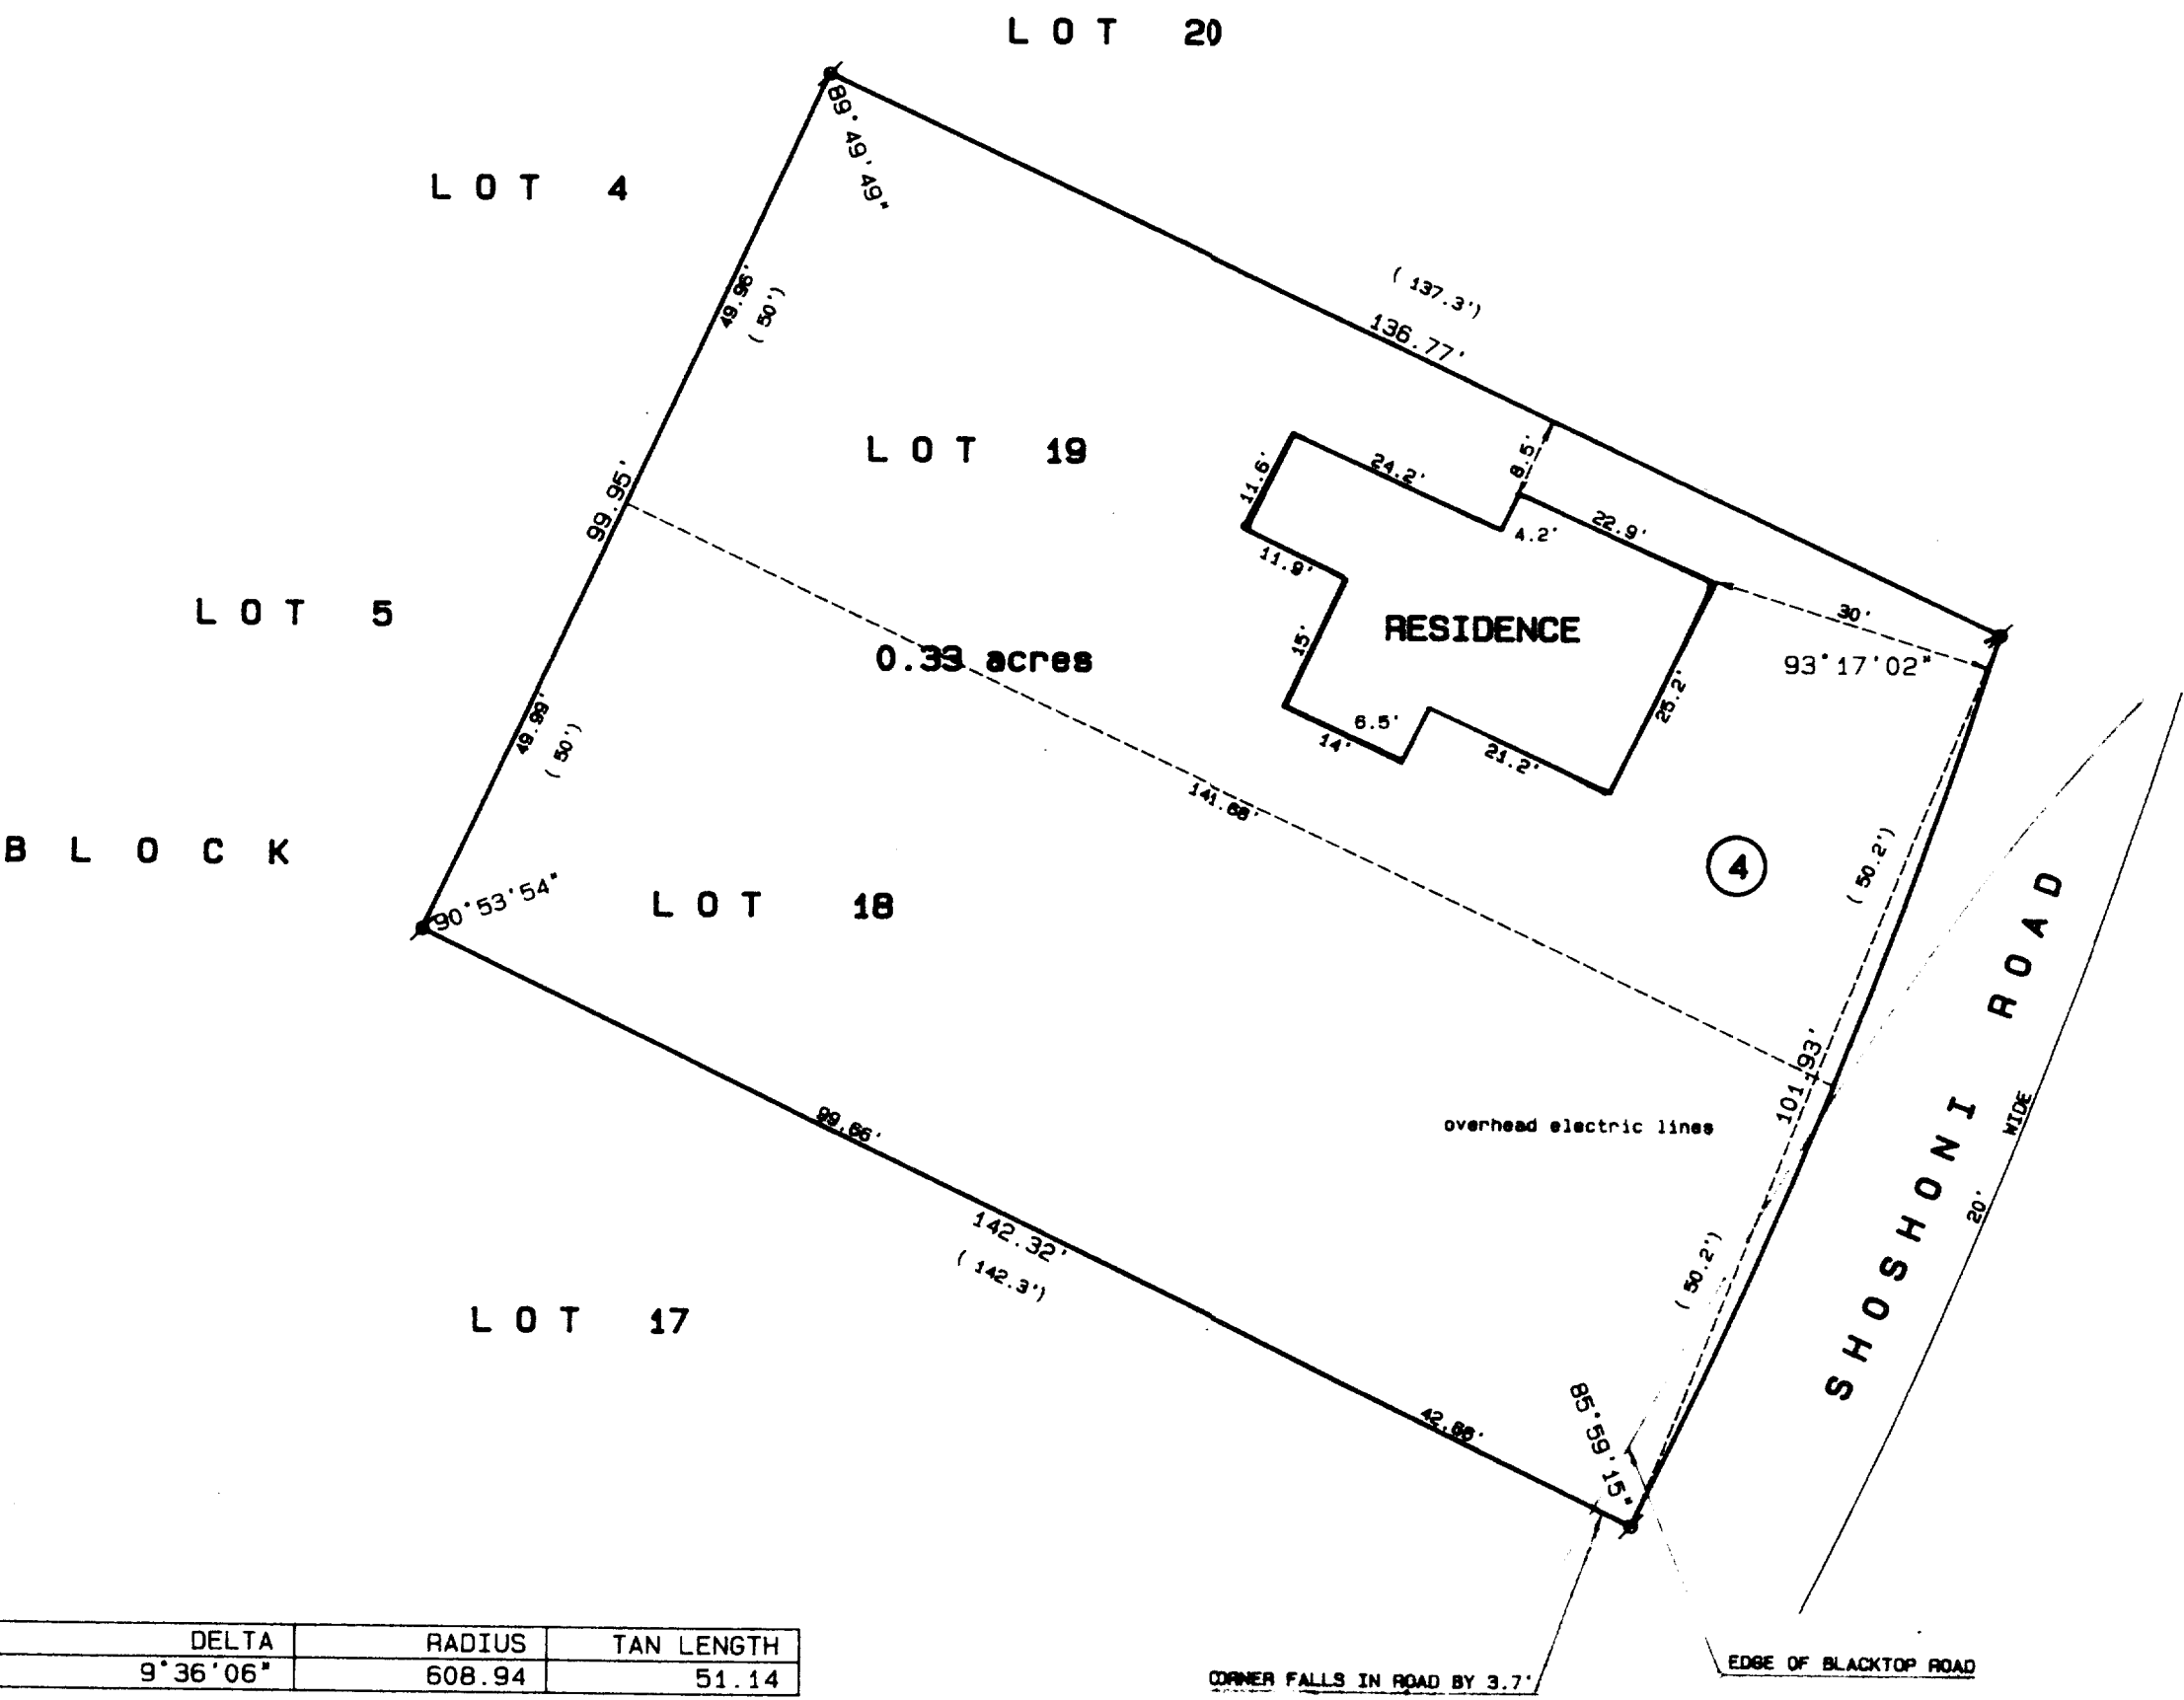

CURVE	ARC	DELTA	RADIUS	TAN LENGTH
C1	102.05	9°36'06"	608.94	51.14

I hereby certify that I have surveyed the above described property and that the above map is a true representation thereof and shows the size and location of the property, its exterior boundaries, the location of all visible structures and dimensions of all principal buildings thereon, boundary fences, apparent easements, roadways and visible encroachments, if any.

This survey is made for the use of the present owners of the property, and also those who purchase, mortgage, or guarantee the title thereto within one year from date hereof.

Kenneth B. Abernathy Jr.
KENNETH B. ABERNATHY, JR.
WISCONSIN REGISTERED LAND SURVEYOR,
S-1594
Date: 7/16/91 Job No. 91.704

SIHF 00039
SE 45 444114