


ABELL
SURVEYING & MAPPING
 DELAVAN, WISCONSIN 53115
 414-728-6737


PLAT OF SURVEY OF

LOT 21 OF COUNTRY CLUB ESTATES UNIT
 NO. 1, VILLAGE OF FONTANA-ON-GENEVA
 LAKE, WALWORTH COUNTY, WISCONSIN.

ORDERED BY: FRANK WIERCIOCH
 3115 38th STREET
 OAK BROOK, IL. 60521

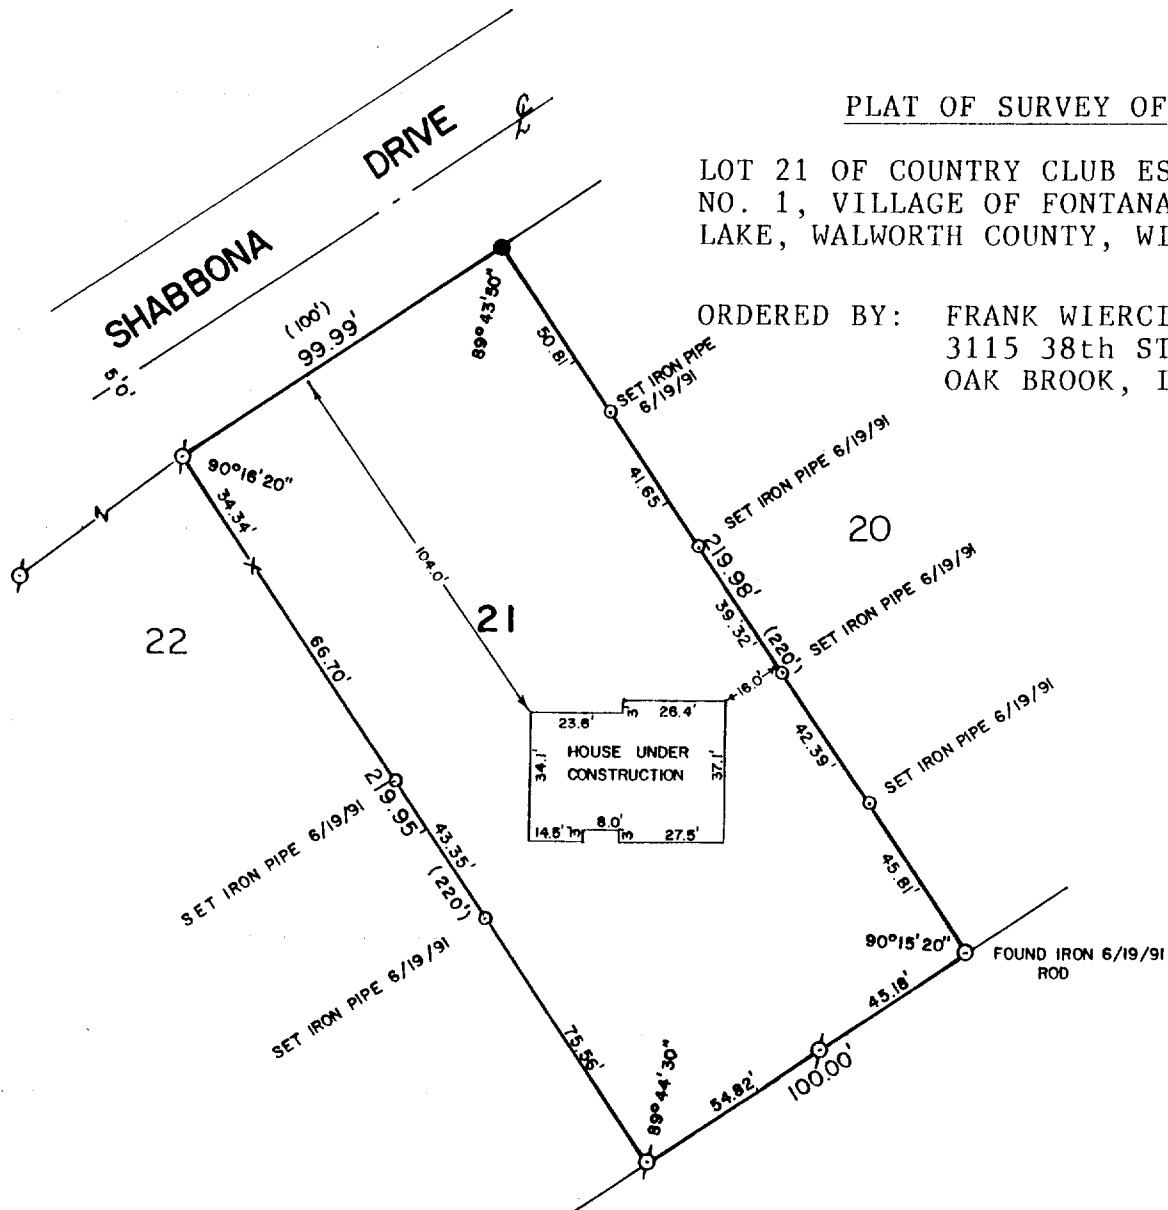

REVISED: JUNE 20, 1991
 ORDERED BY: D.R. ZACCONE
 69 BRIARWOOD CT.
 OAK BROOK, IL. 60521

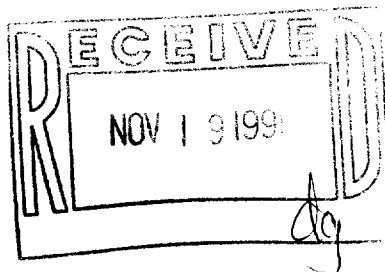

SCALE - 1"=50'

LEGEND

- ⊙ - IRON PIPE FOUND
- - IRON ROD FOUND
- - IRON ROD SET
- () - RECORDED AS
- X - 60 PENNY SPIKE SET

I, DAVID F. ABELL, DO HEREBY CERTIFY
 THAT I HAVE SURVEYED THE PROPERTY
 HEREON DESCRIBED ACCORDING TO THE
 OFFICIAL RECORDS AND THAT THE PLAT
 HEREON IS A CORRECT REPRESENTATION
 OF THE PROPERTY LINES TO THE BEST OF
 MY KNOWLEDGE AND BELIEF.

David F. Abell

DAVID F. ABELL
 WISCONSIN REGISTERED LAND SURVEYOR, S-1596

DATE *Sept. 28, 1988* JOB NUMBER - 88082

NOTE: THIS IS NOT A CERTIFIED COPY UNLESS SEALED.

REVISED: JULY 9, 1990 TO SHOW
 LOCATION OF HOUSE UNDER
 CONSTRUCTION.

005-1134

SC.0100021