


ABELL SURVEYING & MAPPING

DELAVER, WISCONSIN 53115

414-728-6737

LOT 6

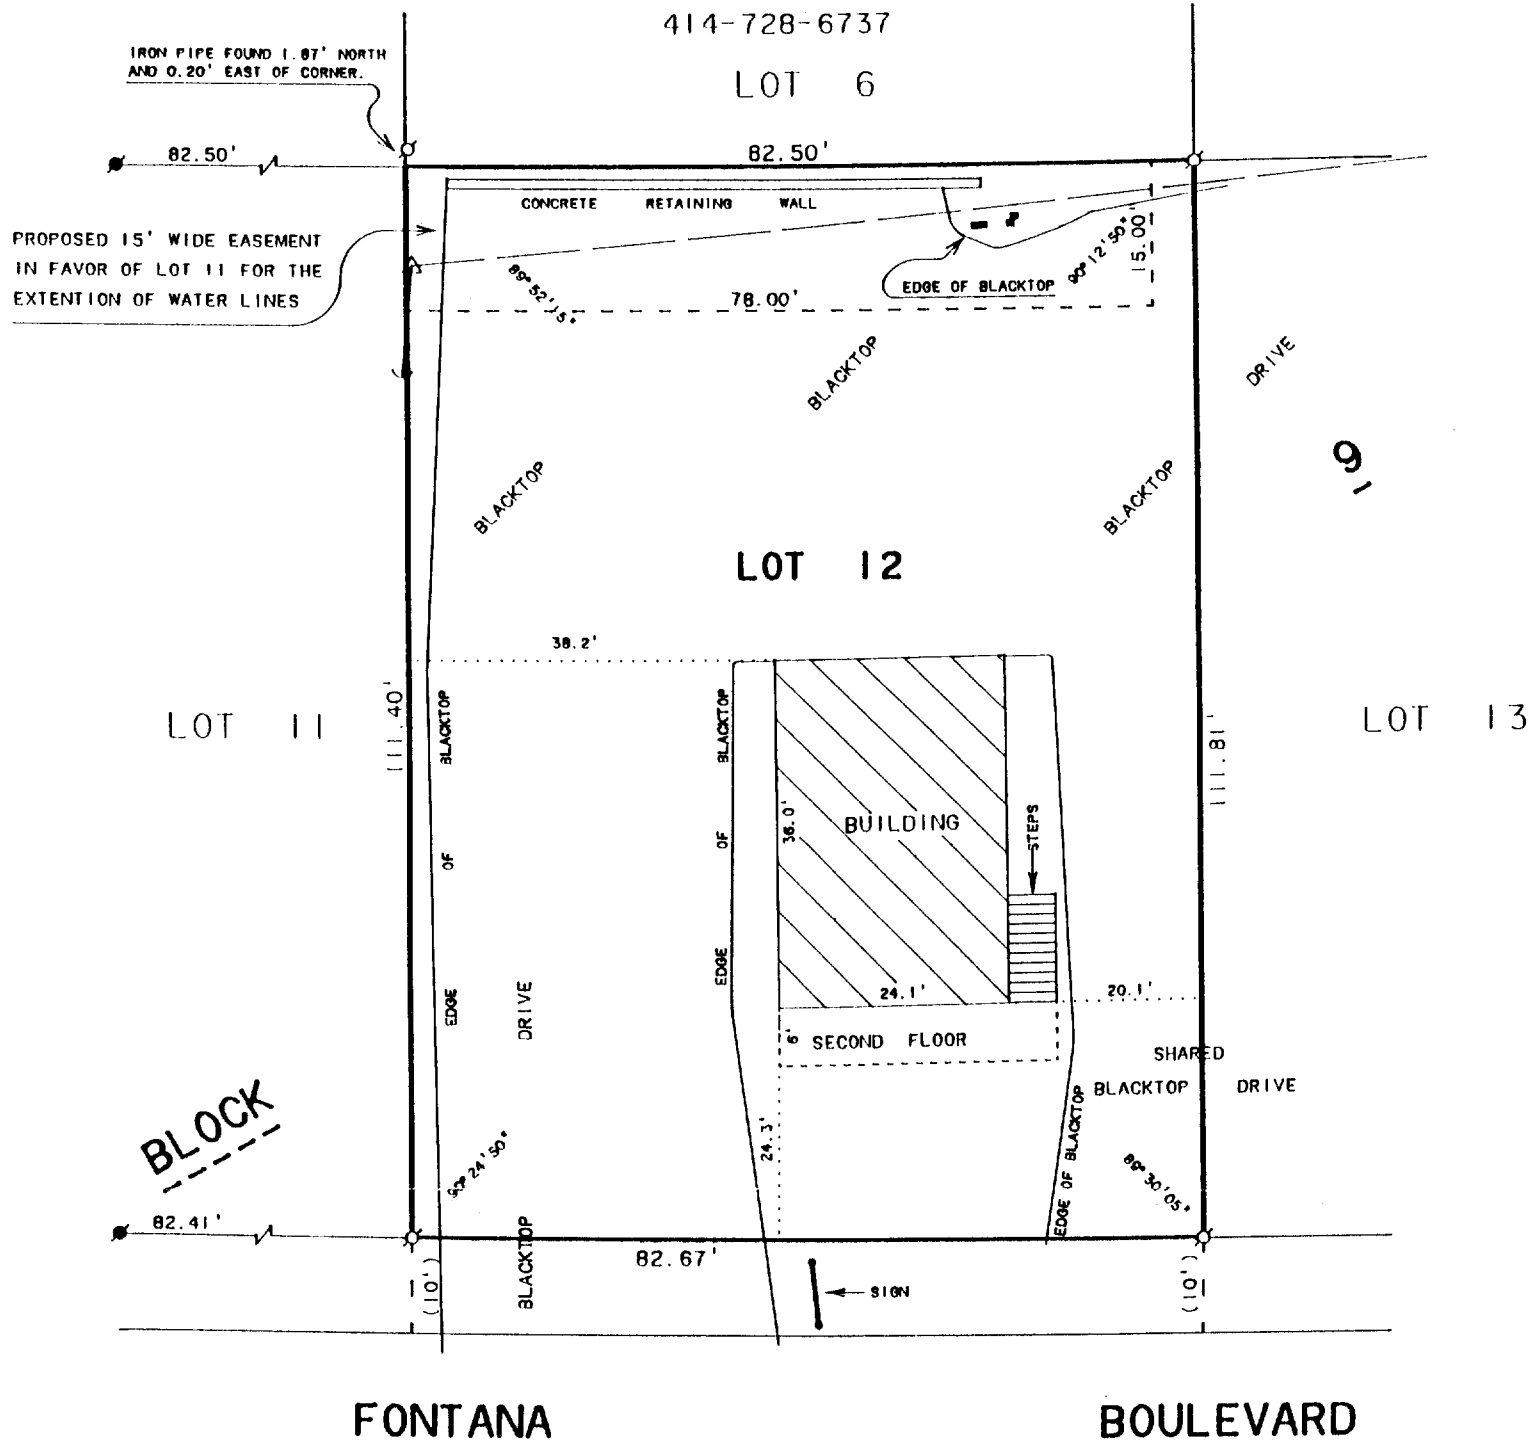


SCALE 1"=20'

LEGEND

- - IRON PIPE FOUND
- - CONCRETE MONUMENT FOUND
- △ - UTILITY POLE
- ⊙ - UTILITY POLE ANCHOR
- - OVERHEAD UTILITY LINES
- - WATER VALVE BOX
- () - RECORDED AS

ORDERED BY: DEAN HOLDEN
P. O. BOX H
FONTANA, WI. 53125

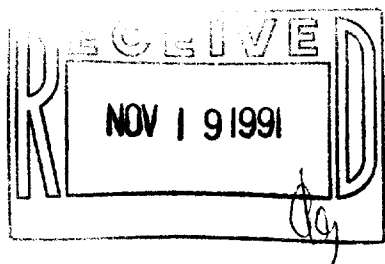

PLAT OF SURVEY OF

LOT 12, BLOCK 9 OF THE ORIGINAL PLAT OF THE VILLAGE
OF FONTANA-ON-GENEVA LAKE, WALWORTH COUNTY, WISCONSIN.
EXCEPTING THEREFROM THE SOUTH 10 FEET OF SAID LOT 12.

I HEREBY CERTIFY THAT I HAVE SURVEYED THE ABOVE DESCRIBED PROPERTY AND THAT THE ABOVE MAP IS A TRUE REPRESENTATION THEREOF AND SHOWS THE SIZE AND LOCATION OF THE PROPERTY, ITS EXTERIOR BOUNDARIES, THE LOCATION OF ALL VISIBLE STRUCTURES AND DIMENSIONS OF ALL PRINCIPAL BUILDINGS THEREON, BOUNDARY FENCES, APPARENT EASEMENTS, ROADWAYS AND VISIBLE ENCROACHMENTS, IF ANY, TO THE BEST OF MY KNOWLEDGE AND BELIEF.

THIS SURVEY IS MADE FOR THE USE OF THE PRESENT OWNERS OF THE PROPERTY, AND ALSO THOSE WHO PURCHASE, MORTGAGE, OR GUARANTEE THE TITLE THERETO WITHIN ONE (1) YEAR FROM DATE HEREOF.

David F. Abell

DAVID F. ABELL
WISCONSIN REGISTERED LAND SURVEYOR, S-1596

September 16, 1991

DATE: September 16, 1991 JOB NUMBER - 91169
NOTE: THIS IS NOT A CERTIFIED COPY UNLESS SEALED.