


**UNIT 12 OF**

**TIMBER RIDGE CONDOMINIUM**

LOCATED IN THE SW 1/4 OF SECTION 13, TOWN 1 NORTH, RANGE 16 EAST,  
VILLAGE OF FONTANA-ON-GENEVA LAKE, WALWORTH COUNTY, WISCONSIN

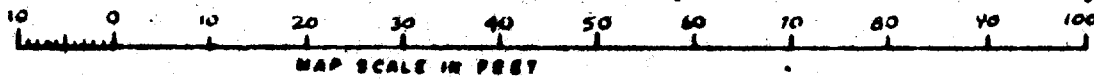

## LEGEND

(---) BOUNDARY OF DESIGNATED EXCLUSION AREA

①: IRON PIPE PLACE

Q. IRON PIPE FOUND

● CONC. NEW. POUND


• IRON AGE FOUND

(XXX) - RECORD DIMENSION

⑧ SET - 1/4" PL/AR


ORDERED BY: HANS MELGES

UNIT 13

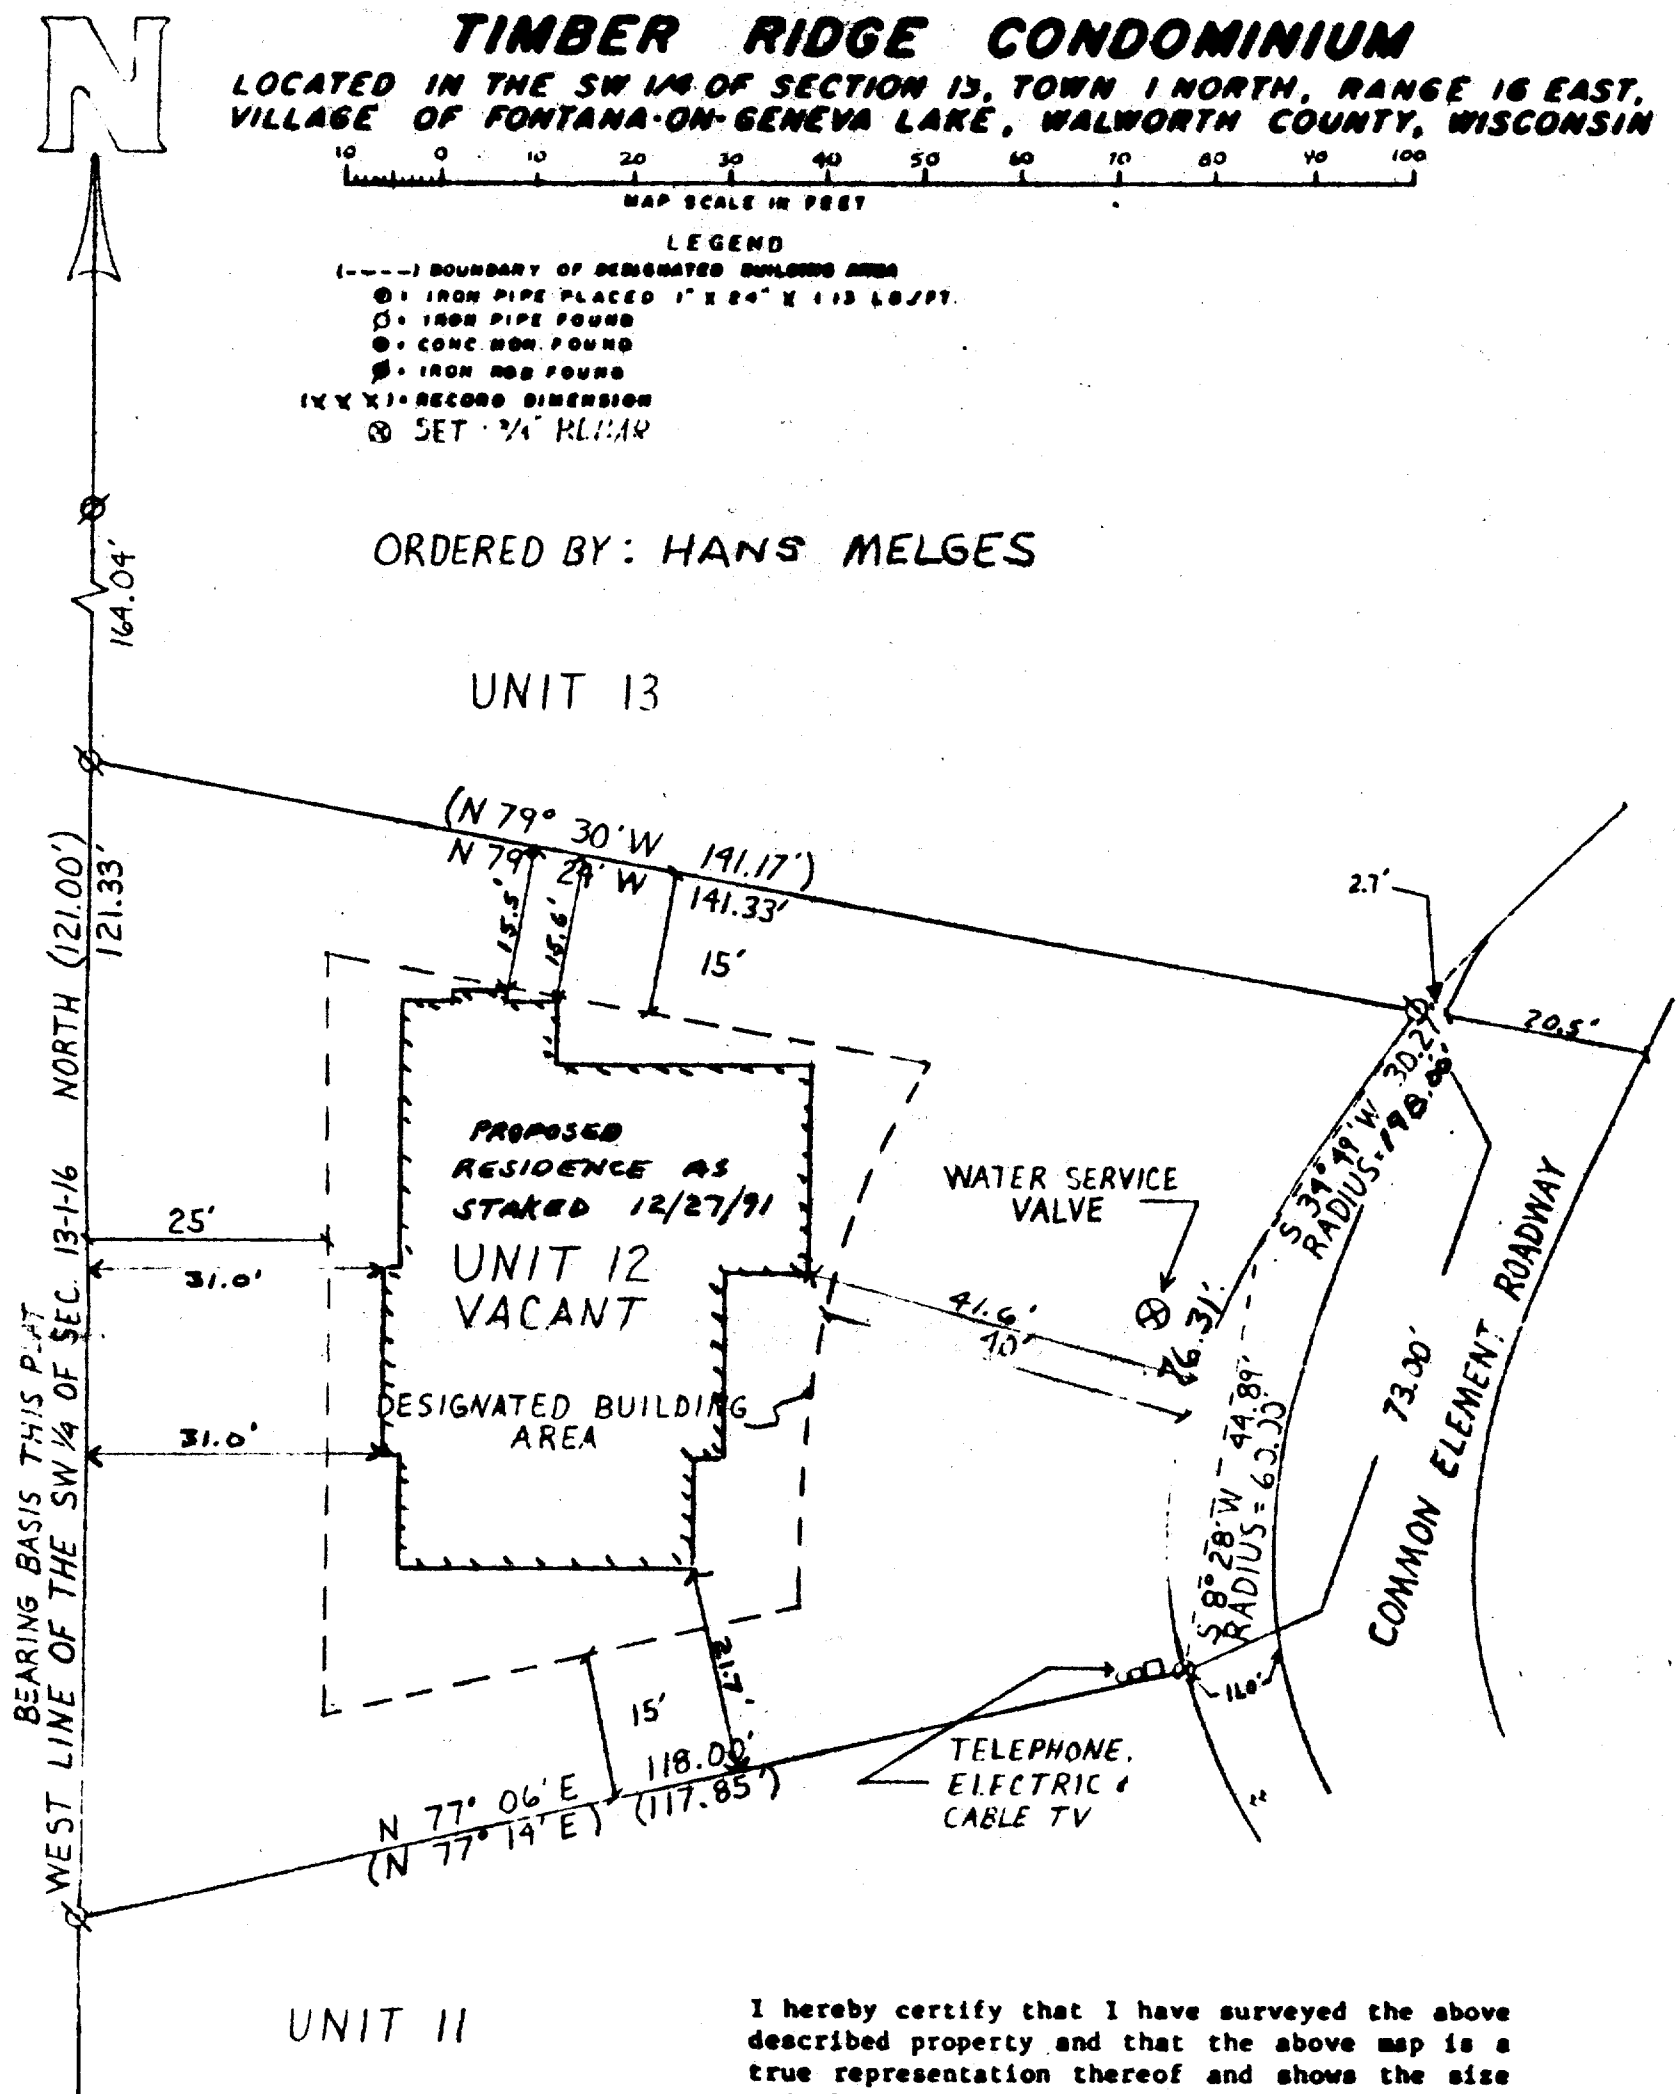

I hereby certify that I have surveyed the above described property and that the above map is a true representation thereof and shows the size and location of the property, its exterior boundaries, the location of all visible structures and dimensions of all principal buildings thereon, boundary fences, apparent easements, roadways and visible encroachments, if any.


This survey is made for the use of the present owners of the property, and also those who purchase, mortgage, or guarantee the title thereto within one (1) year from the date hereof.

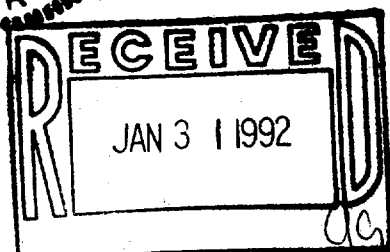

PROJECT NO. 2977-12  
FILE NO. 2210.12

*Robert A. Farris*  
ROBERT A. FARRIS RLS  
DATED: MARCH 24, 1988

Lita L. Perslow  
REVISED JAN. 08, 1992  
TO SHOW PROPOSED RES.  
AS STATED

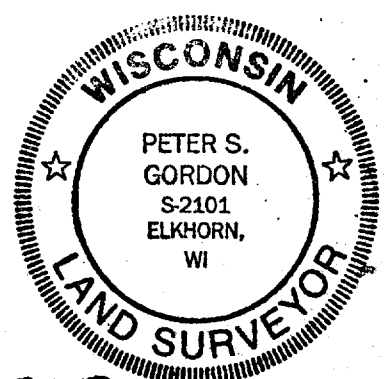

005-1144

ST-12