


DUNHAM SURVEYING, S.C.
SURVEYING & SUBDIVIDING
DELAVAN, WISCONSIN 53115

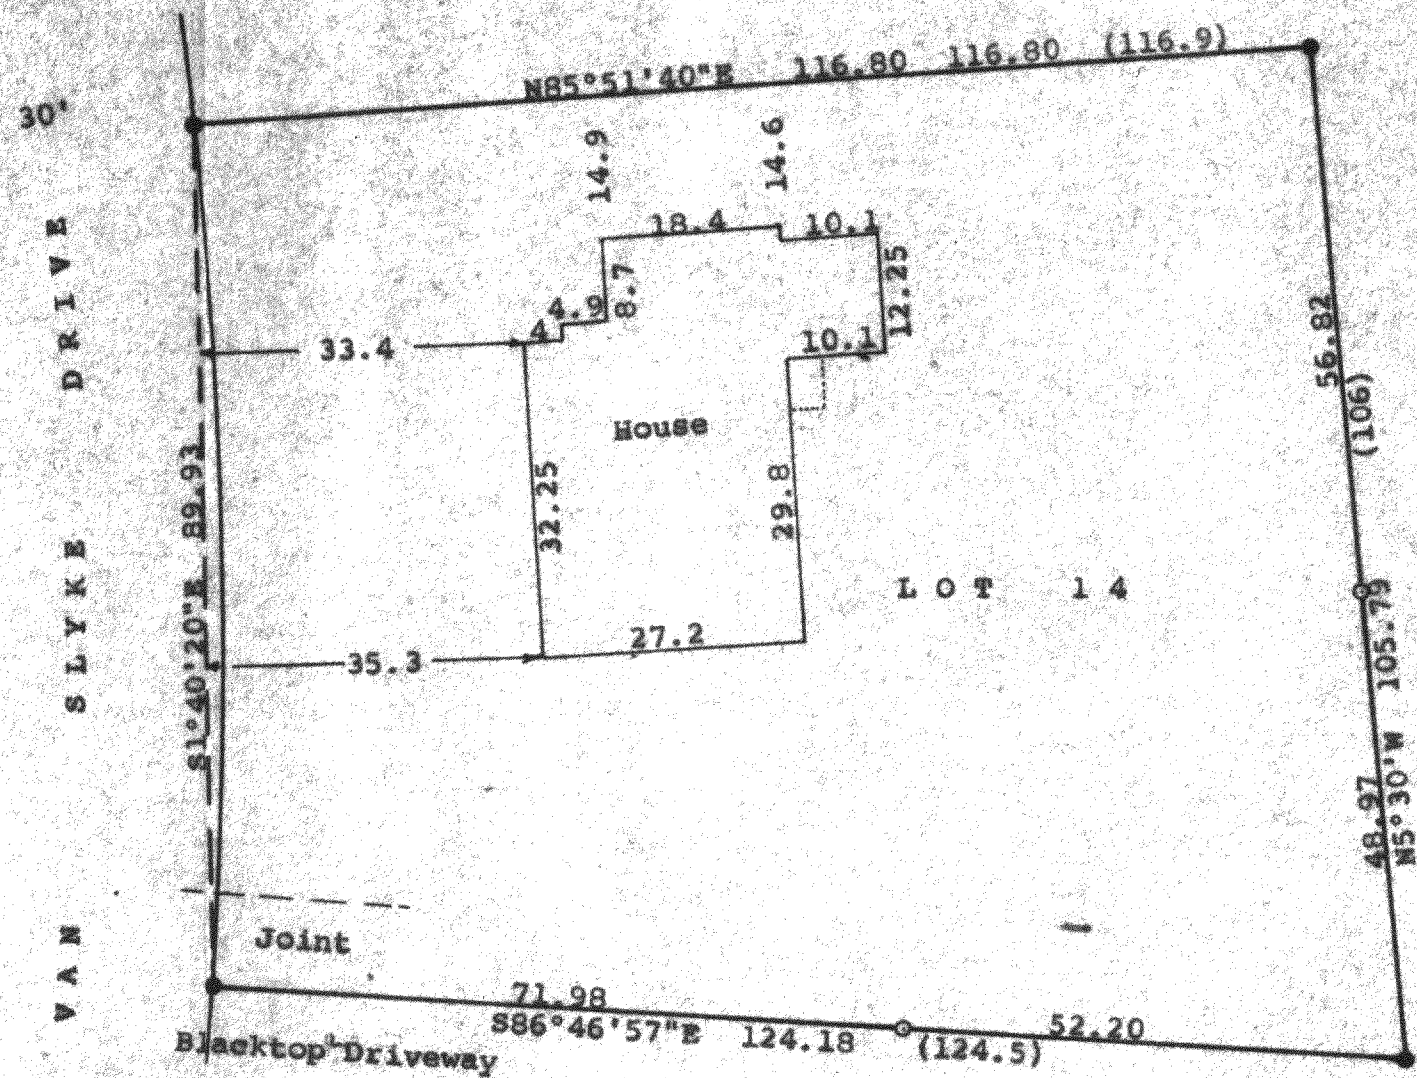

Scale - 1" = 20'
 ● = Concrete Monument Found
 ○ = 1" Iron Pipe Found
 Bearings referenced to the assumed bearing of
 N5°30'W along the easterly line of Lot 14
 Survey ordered by:
 James D. Rich
 839 Van Slyke Drive
 Country Club Estates
 Fontana, WI 53125
 (0.00) = recorded distance



STATE OF WISCONSIN) SS
 COUNTY OF WALWORTH)

I, George T. Dunham, Surveyor, certify that I have surveyed the property described as follows:
 Lot 14 in Block "E", Country Club Estates Unit No. 3, located in the Village of Fontana-on-Geneva Lake, Walworth County, Wisconsin, and that the plat shown hereon is a correct representation thereof and shows the size and location of the property, its exterior boundaries, the location of all visible structures and dimensions of all principal buildings thereon, boundary fences, apparent easements, roadways and visible encroachments, if any, and that I have surveyed the property hereon described, according to the official records, to the best of my knowledge and belief.
 September 9, 1991

George T. Dunham
 George T. Dunham, Surveyor

