


DUNHAM SURVEYING, S.C.
SURVEYING & SUBDIVIDING
DELAVER, WISCONSIN 53115

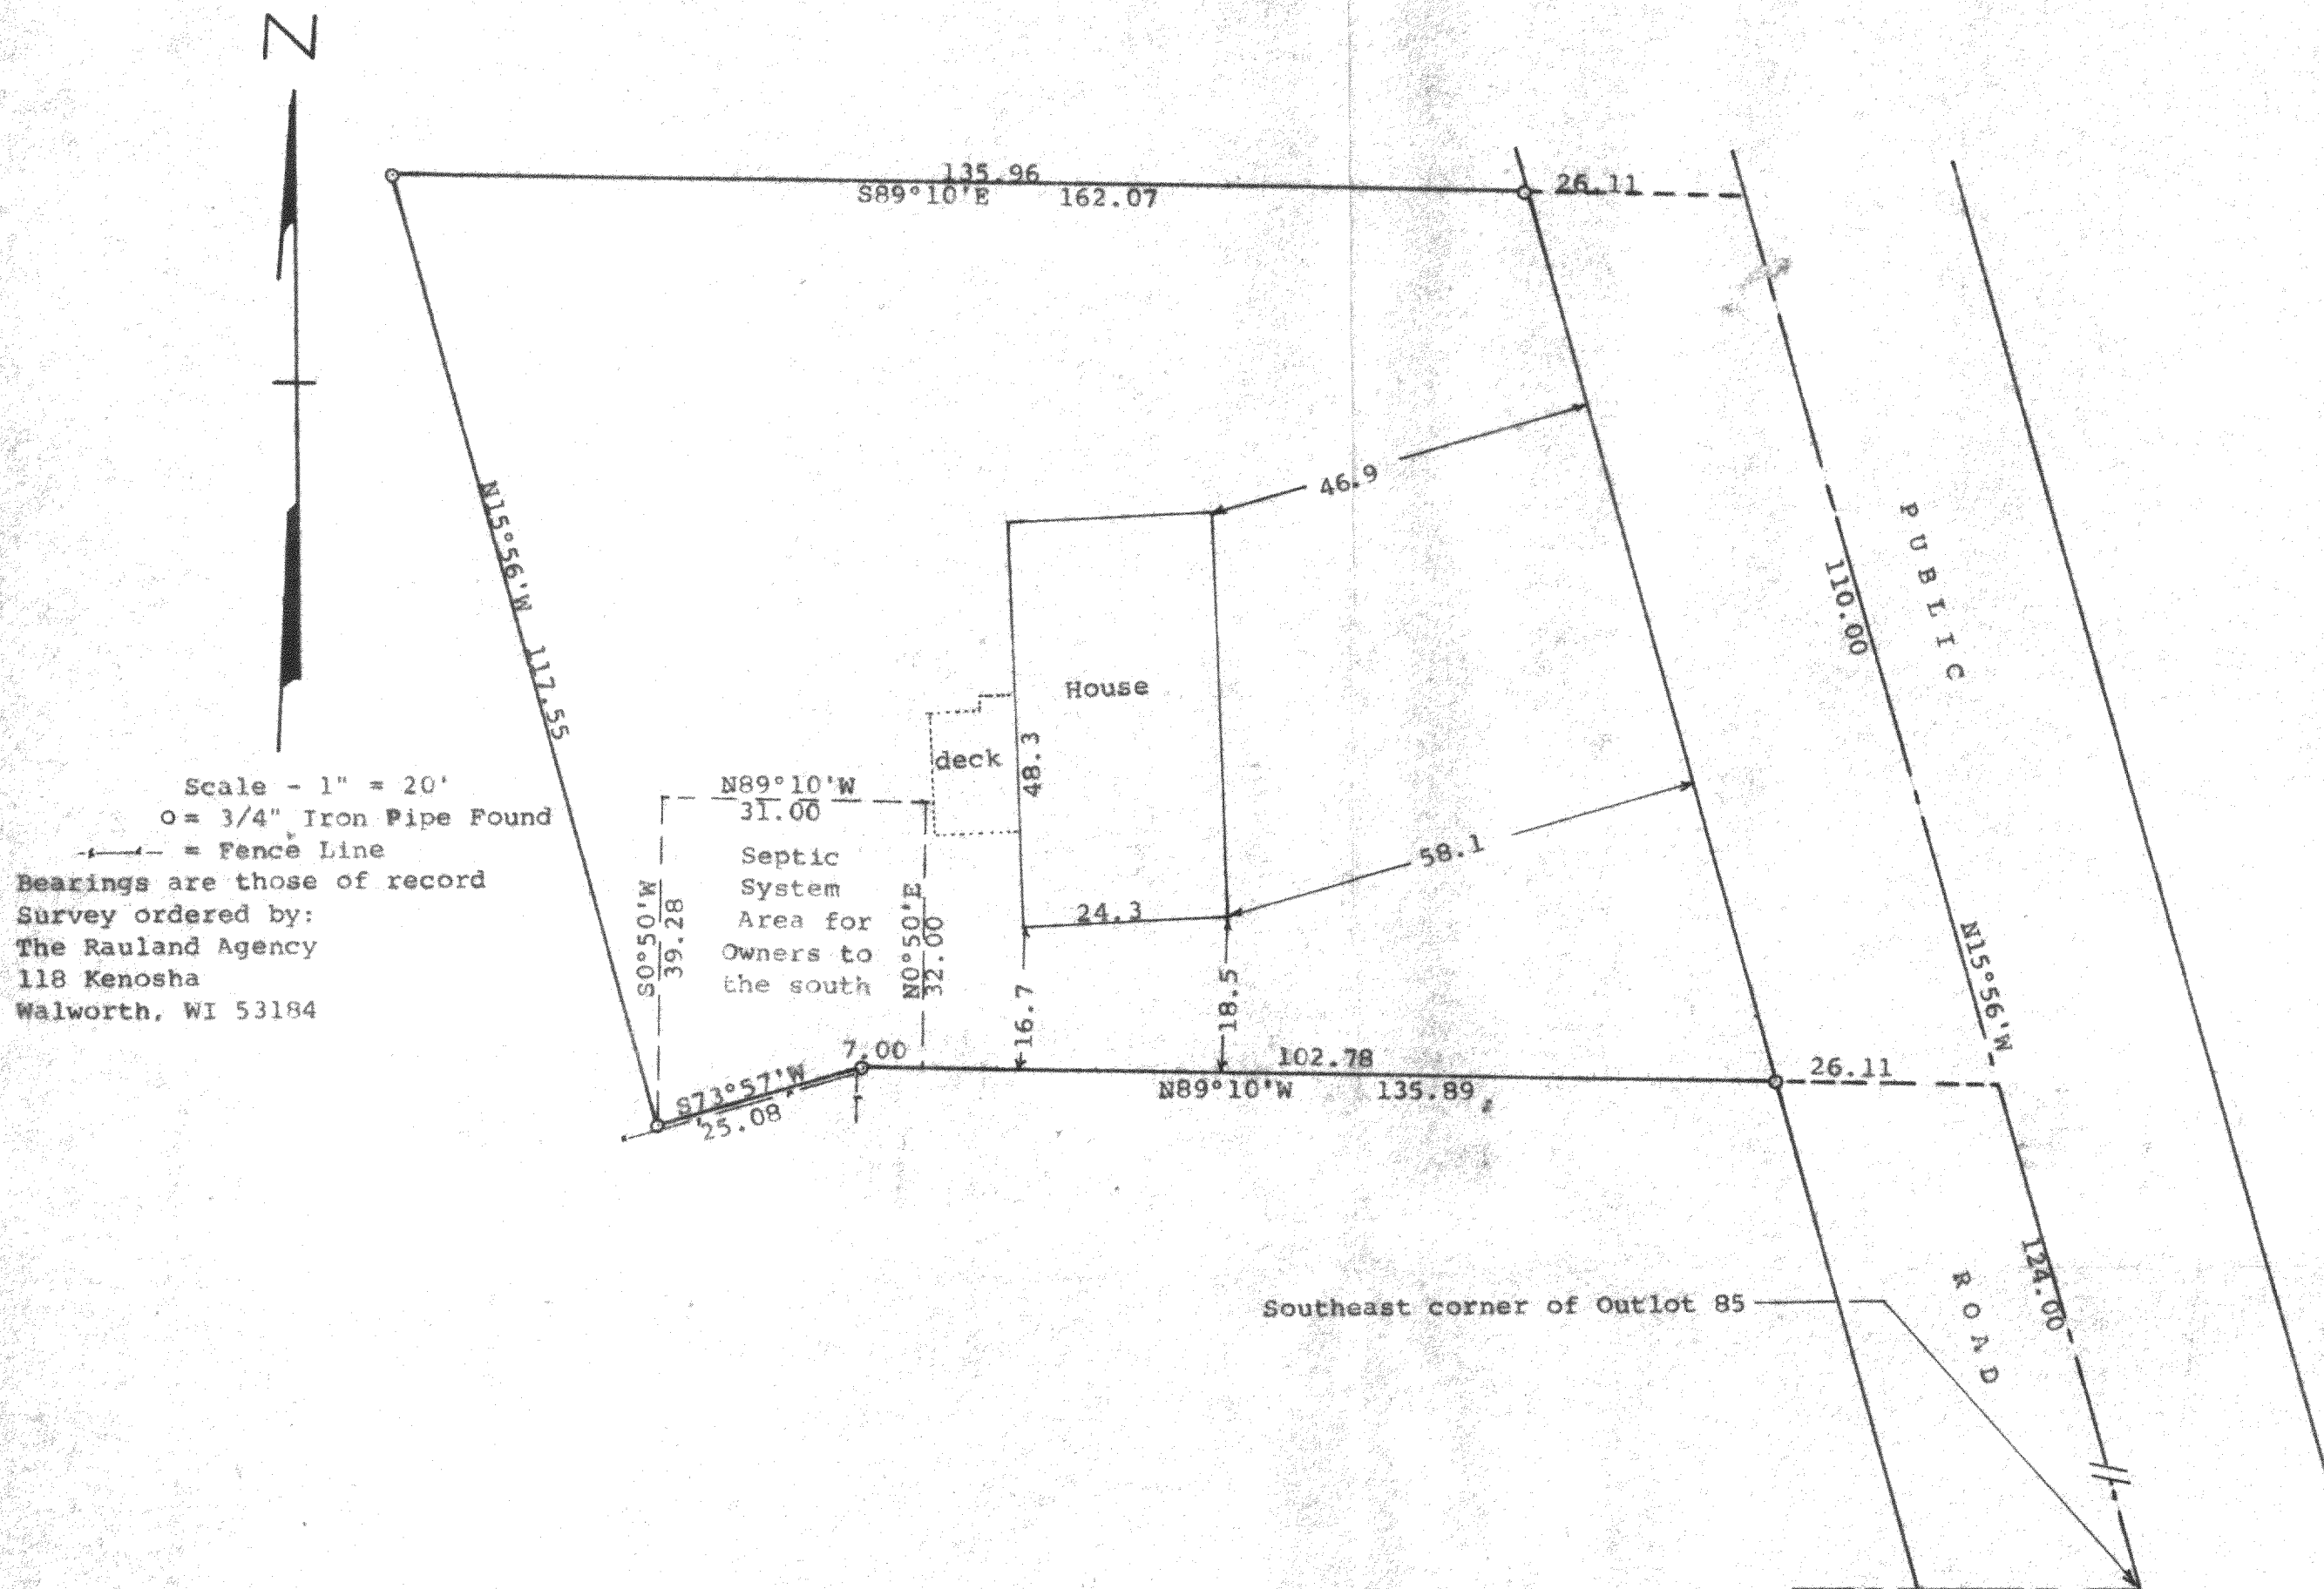

STATE OF WISCONSIN) SS
COUNTY OF WALWORTH)

I, George T. Dunham, Surveyor, certify that I have surveyed the property described as follows:

A parcel of land located in Outlot No. 85 of the Fontana-on-Geneva Lake Assessors Plat, Village of Fontana, Walworth County Wisconsin, described as follows: Commencing at the southeast corner of said Outlot 85 in the centerline of the public road; thence N15°56'W along the centerline of said road 124.00 feet to the place of beginning; thence N89°10'W 135.89 feet; thence S73°57'W 25.08 feet; thence N15°56'W 117.55 feet; thence S89°10'E 162.07 feet to the centerline of the public road; thence S15°56'E along said centerline 110.00 feet to the place of beginning, SUBJECT TO: The Owners and their Assigns of the parcel of land lying adjacent to and south of the above described parcel of land, are granted the use and the right to maintain the septic system located on that part of the above described parcel of land that is described as follows: Commencing at the southeast corner of said Outlot 85 in the centerline of the public road; thence N15°56'W along the centerline of said road, 124.00 feet; thence N89°10'W 128.89 feet to the place of beginning; thence N0°50'E 32.00 feet; thence N89°10'W 31.00 feet; thence S0°50'W 39.28 feet; thence N73°57'W 25.08 feet; thence S89°10'E 7.00 feet to the place of beginning.

and that the plat shown hereon is a correct representation thereof and shows the size and location of the property, its exterior boundaries, the location of all visible structures and dimensions of all principal buildings thereon, boundary fences, apparent easements, roadways and visible encroachments, if any, and that I have surveyed the property hereon described, according to the official records, to the best of my knowledge and belief.

November 7, 1991

George T. Dunham
George T. Dunham, Surveyor

