

ABERNATHY and ASSOCIATES

Kenneth B. Abernathy Jr.

Wisconsin Registered Land Surveyor S-1594



Rt. 3, Box 273  
Elkhorn, Wisconsin 53121  
Phone: (414) 723-4260 (office)  
(414) 723-4813 (residence)

## PLAT OF SURVEY

LOT 39 OF BUENA VISTA SUBDIVISION, A SUBDIVISION  
LOCATED IN SECTIONS 11 AND 14, TOWN 1 NORTH, RANGE 16  
EAST, VILLAGE OF FONTANA, WALWORTH COUNTY, WISCONSIN.

OWNERS: ROBERT C. CHANSON  
SONETTE C. SALTER  
C/O MOORE BUSINESS FORMS  
615 N. LONGWOOD ST  
SUITE 200  
ROCKFORD, ILL. 61107-4249

ORDERED BY: HOME DESIGN MFG. CORP  
HMY 67 NORTH  
FONTANA, WI. 53125

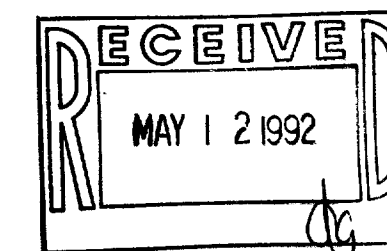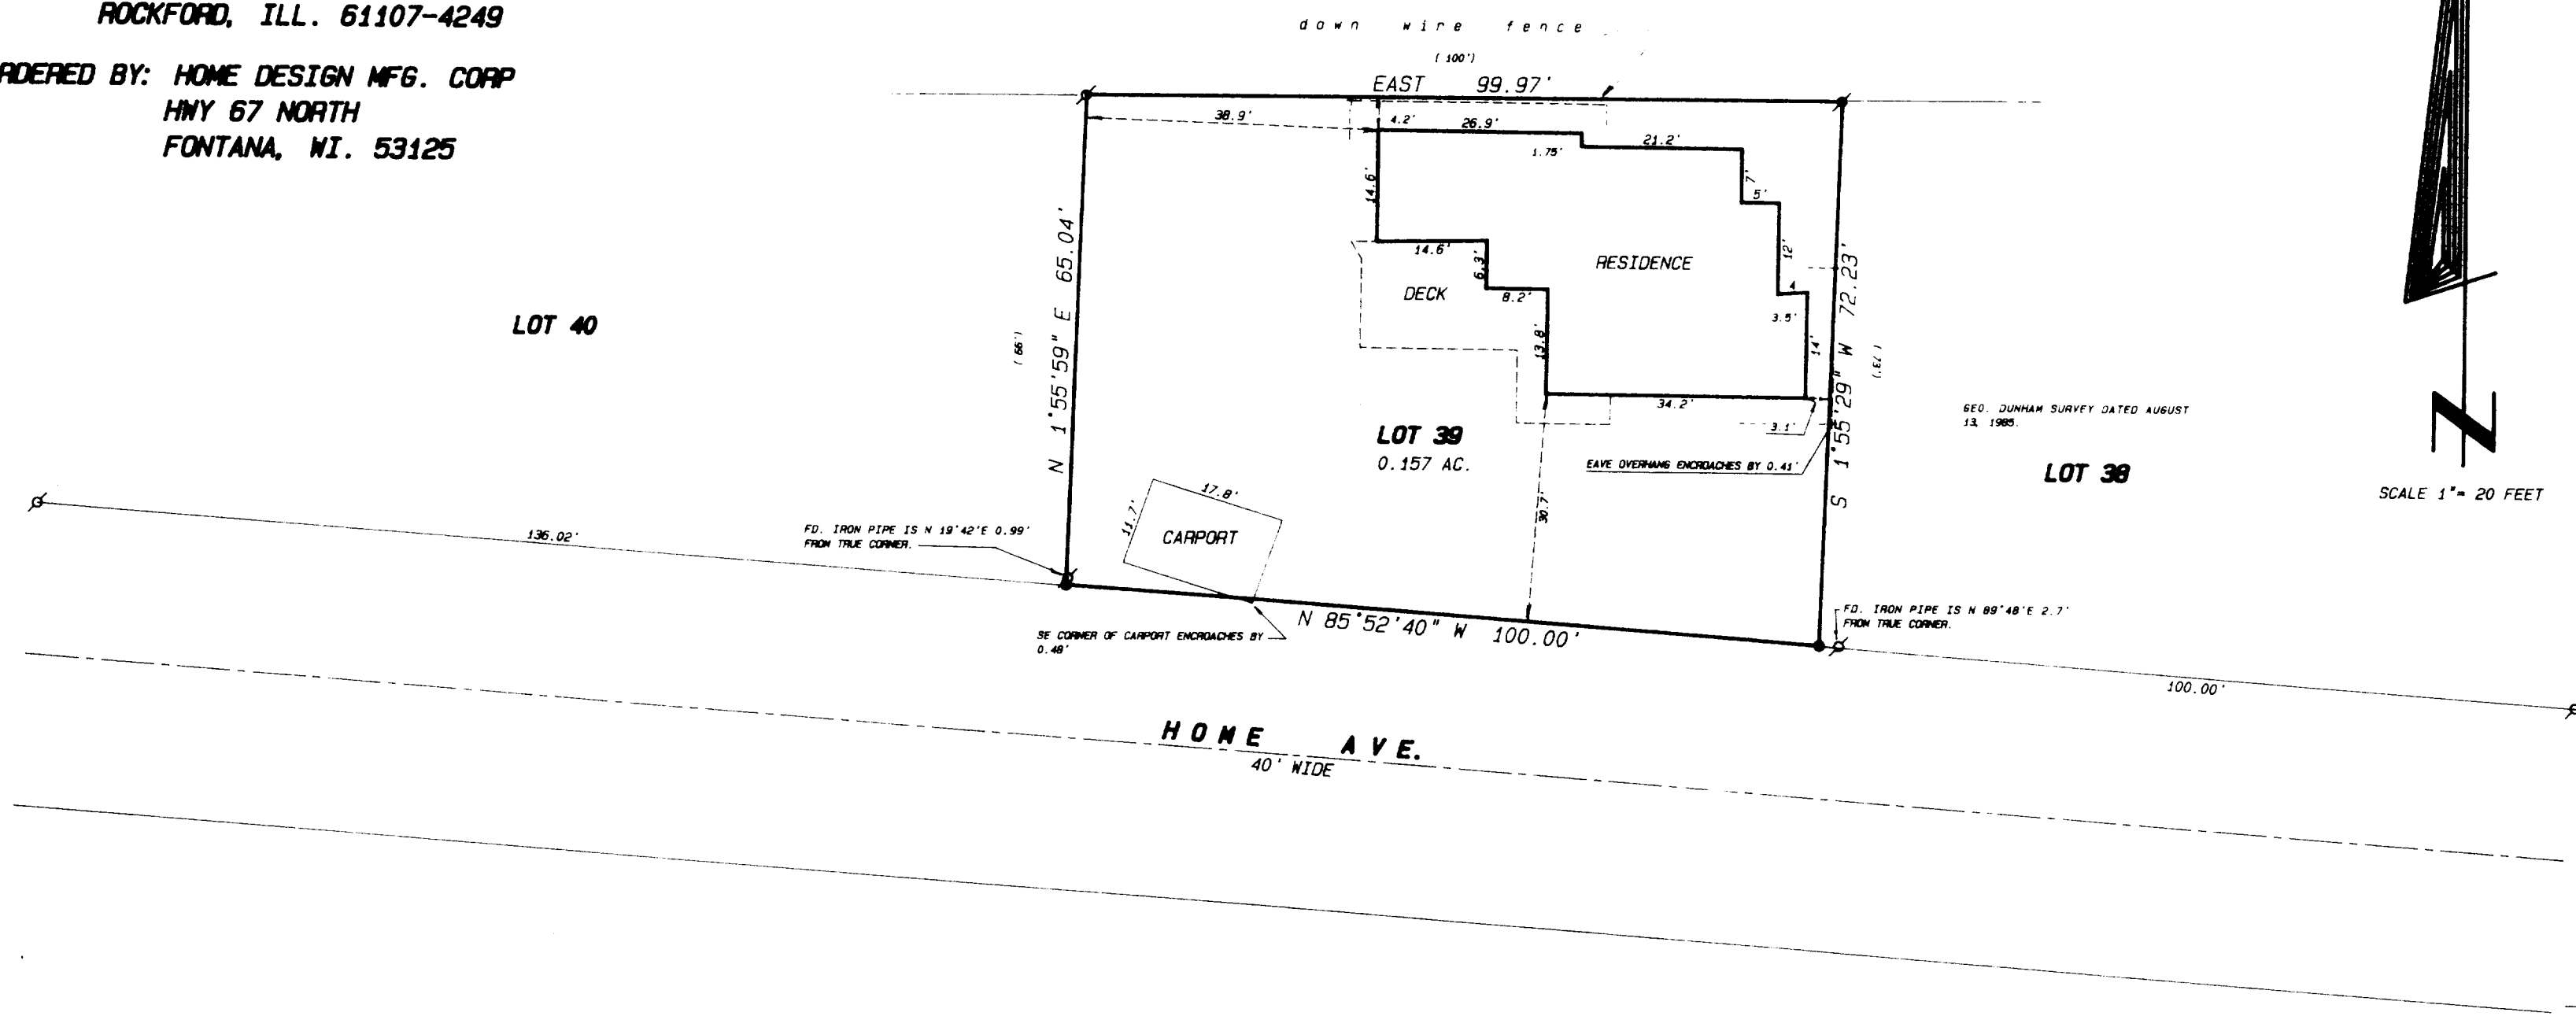

SCALE: 1" = 20 FEET

I hereby certify that I have surveyed the above described property and that the above map is a true representation thereof and shows the size and location of the property, its exterior boundaries, the location of all visible structures and dimensions of all principal buildings thereon, boundary fences, apparent easements, roadways and visible encroachments, if any.

This survey is made for the use of the present owners of the property, and also those who purchase, mortgage, or guarantee the title thereto within one year from date hereof.

*Kenneth B. Abernathy Jr.*  
KENNETH B. ABERNATHY, JR.  
WISCONSIN REGISTERED LAND SURVEYOR,  
S-1594

Date: 3/4/92 Job No. 92 302

