


KOLB LAND CONSULTING, INC.
LAND SURVEYING • SUBDIVIDING • LAND PLANNING

LAKE GENEVA, WISCONSIN 53147

WHITEWATER, WISCONSIN 53190

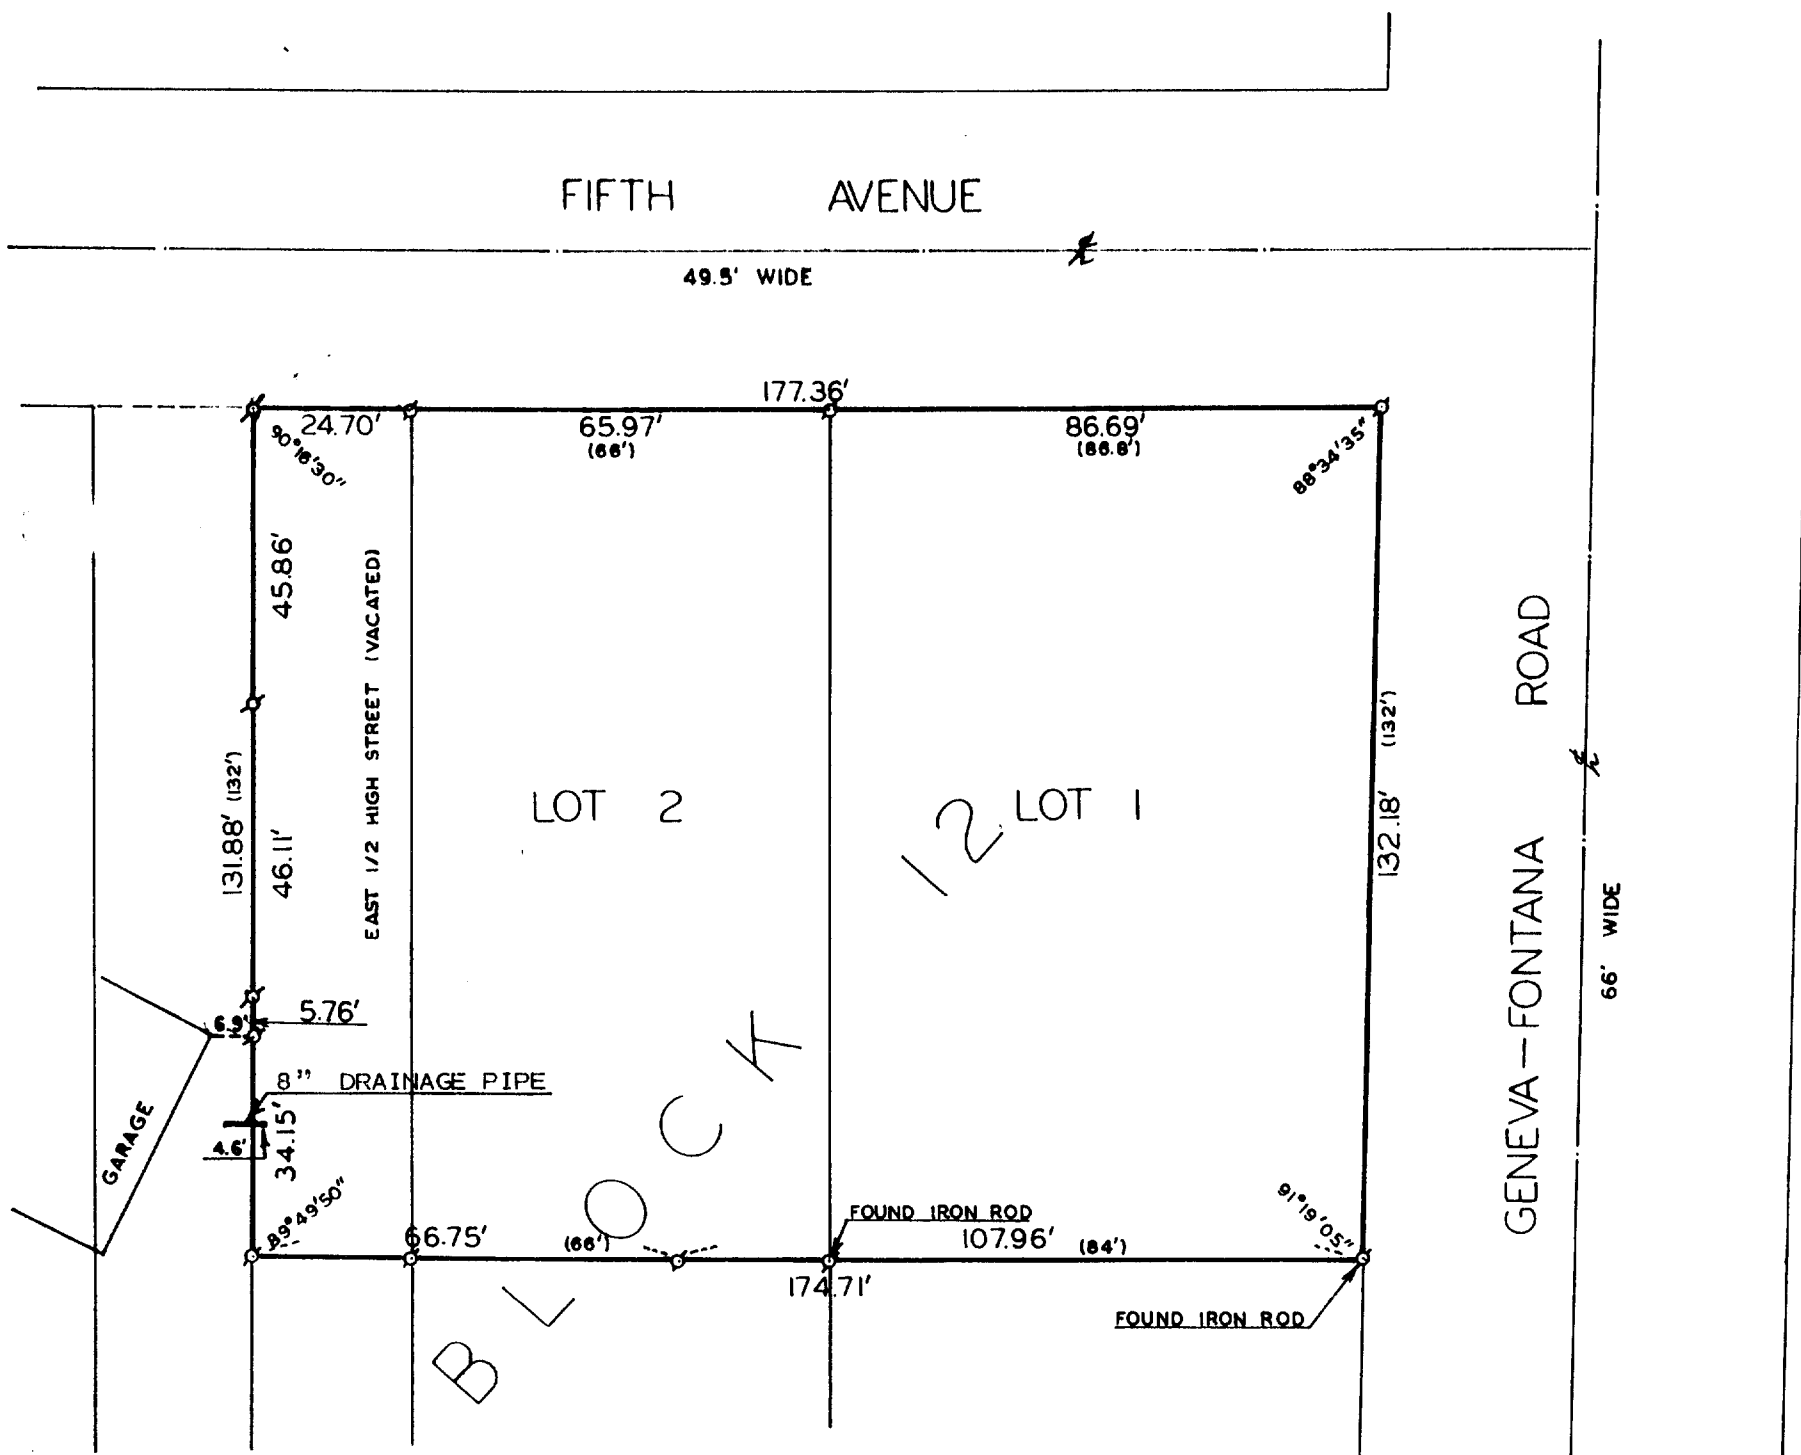

NOTE: ALL PROPERTY CORNERS RELOCATED
8/21/91.

ORDERED BY: MRS. FREDRICK HELDRING
BOX 570 N. SHORE DR.
FONTANA, WI. 53125

PLAT OF SURVEY OF


LOTS 1 AND 2, BLOCK 12, AND THE NORTH 1/2 OF THE
EAST 1/2 OF VACATED HIGH STREET, ORIGINAL PLAT
OF THE VILLAGE OF FONTANA-ON-GENEVA LAKE,
WALWORTH COUNTY, WISCONSIN.

ORDERED BY: MRS. FREDRICK HELDRING
365 CONESTOGA
WAYNE, PA. 19087



SCALE: 1"=30'

o - IRON PIPE FOUND OR AS NOTED
o - IRON PIPE PLACED
o - RECORDED AS

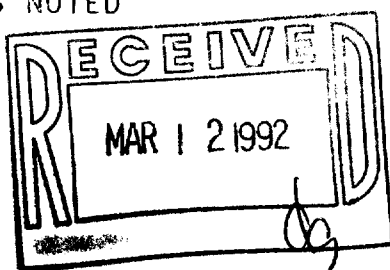

I, HAROLD H. KOLB, DO HEREBY CERTIFY
THAT I HAVE SURVEYED THE PROPERTY
HEREON DESCRIBED ACCORDING TO THE
OFFICIAL RECORDS, AND THAT THE PLAT
HEREON IS A CORRECT REPRESENTATION
OF THE LOT LINES TO THE BEST OF MY
KNOWLEDGE AND BELIEF.

Harold H. Kolb

HAROLD H. KOLB
WISCONSIN REGISTERED LAND SURVEYOR, S-187

DATE Aug. 21, 1990

REVISED AUGUST 21, 1991