


GEORGE T. DUNHAM
SURVEYING & SUBDIVIDING
DELAVAN, WISCONSIN

N



Scale - 1" = 20'
○ = Iron Pipe
● = Concrete Monument

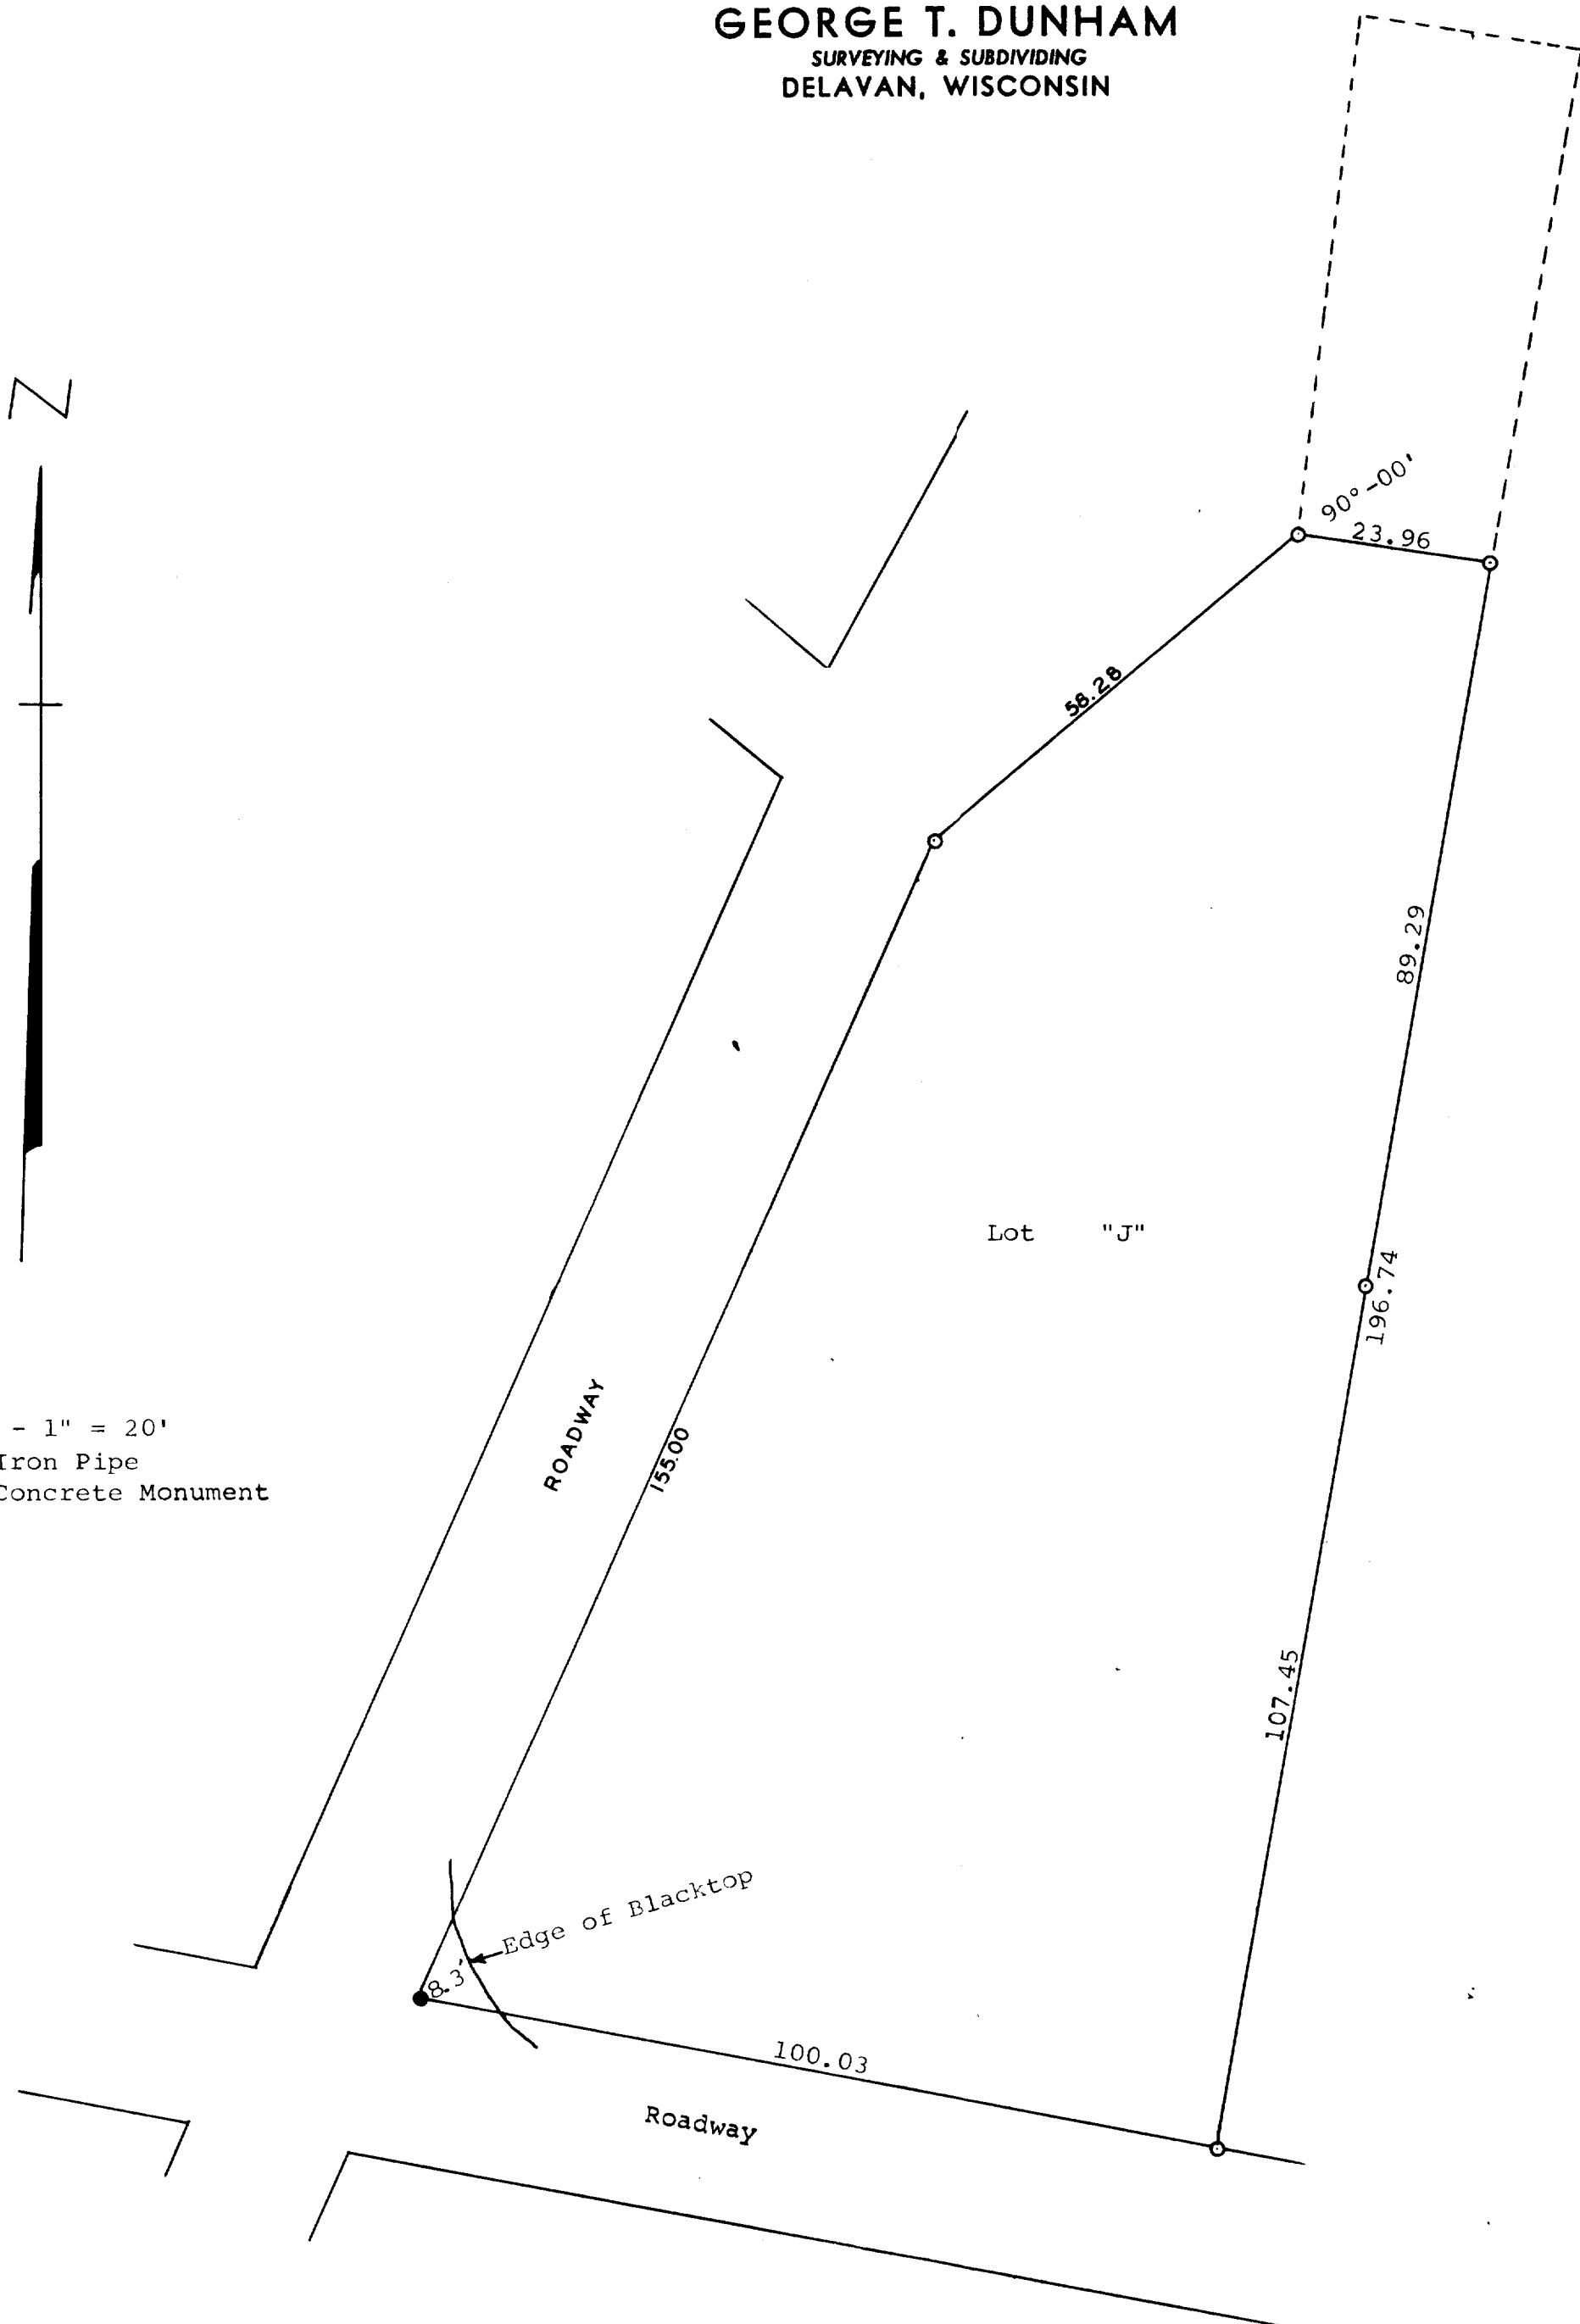

Plat of survey of part of Lot "J" located in
The Gardens Subdivision No. 2, Village of
Fontana, Walworth County, Wisconsin.
November 21, 1968

George T. Dunham
George T. Dunham, Surveyor