

KOLB LAND CONSULTING, INC.
LAND SURVEYING · SUBDIVIDING · LAND PLANNING

929 WILLIAMS STREET LAKE GENEVA, WISCONSIN 53147 414-248-3697



SCALE 1"=30'

LEGEND


- - IRON PIPE FOUND
- - IRON ROD FOUND
- ⊙ - BUOY

→ RIPARIAN LIGHTS LINES BY
KNITTER METHOD →

GENEVA

LAKE

ORDERED BY:
ROGER STEDRONSKY
493 STRADFORD AVE.
ELMHURST, IL 60126

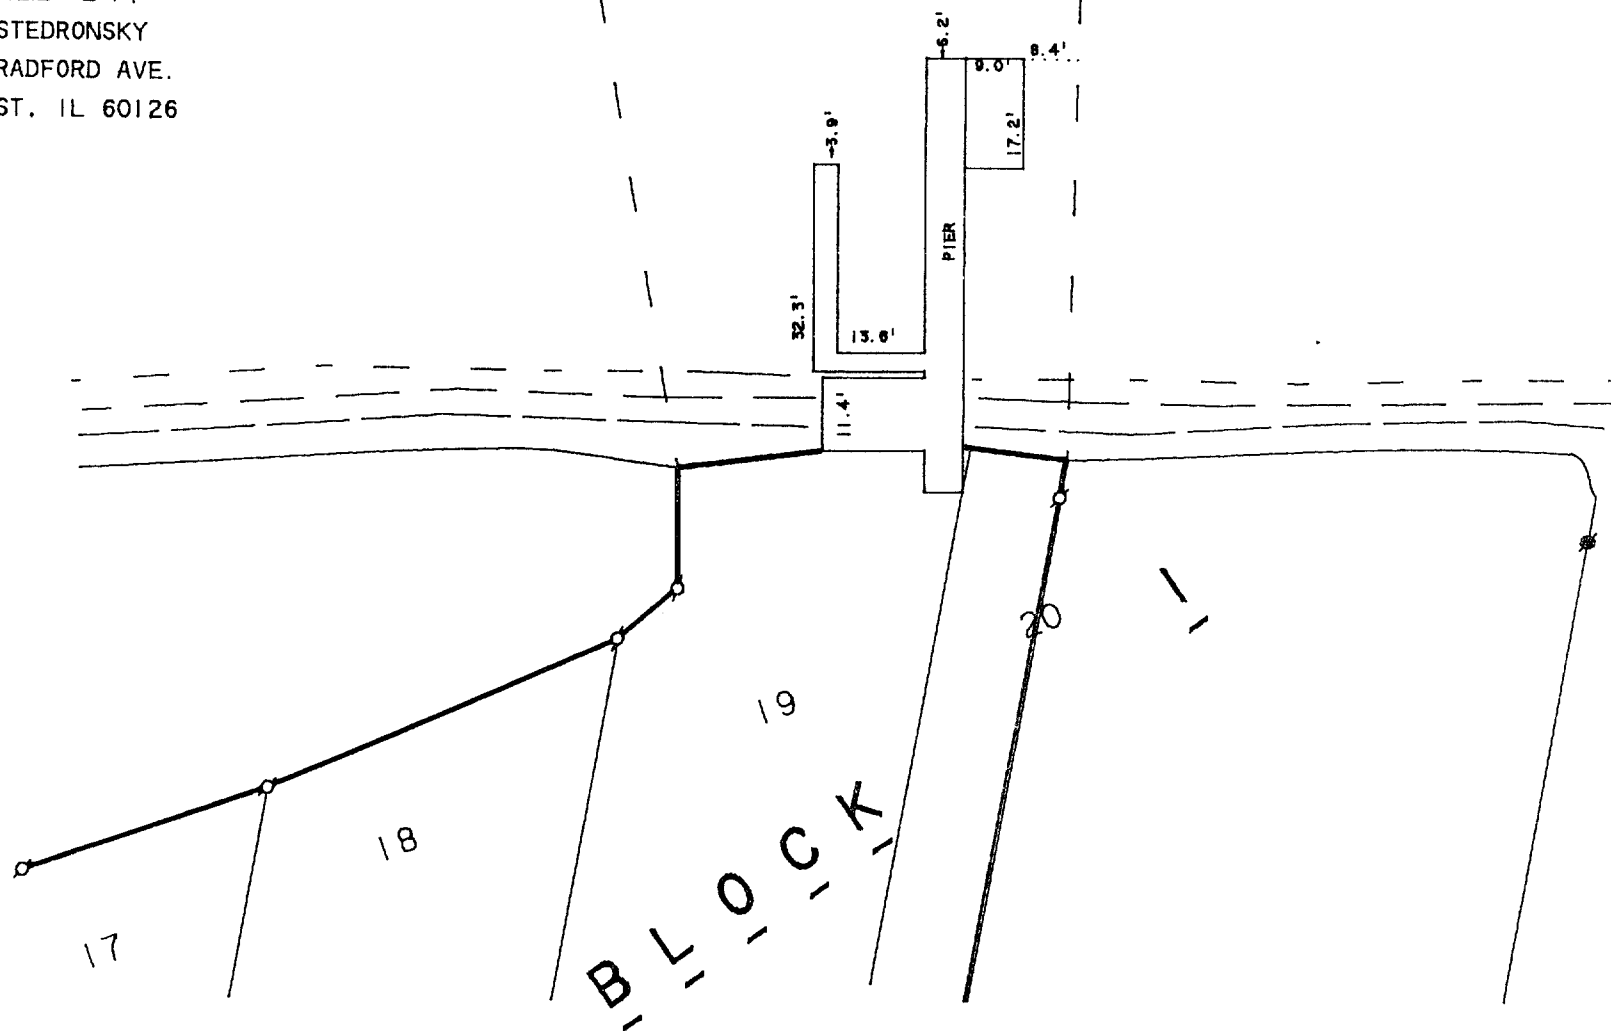


RIPARIAN RIGHTS SURVEY OF

LOTS 17, 18, 19 AND THE WEST 15' OF LOT 20, INDIAN HILLS
SUBDIVISION, VILLAGE OF FONTANA-ON-GENEVA LAKE, WALWORTH
COUNTY, WISCONSIN.

I, HAROLD H. KOLB, DO HEREBY CERTIFY THAT
I HAVE SURVEYED THE PROPERTY HEREON DES-
CRIBED ACCORDING TO THE OFFICAL RECORDS,
AND THAT THE PLAT HEREON IS A CORRECT REP-
RESENTATION OF THE LOT LINES TO THE BEST
OF MY KNOWLEDGE AND BELIEF.

NOTE: SURVEY IS NOT VALID UNLESS SURVEYOR'S
SIGNATURE IS IN RED.

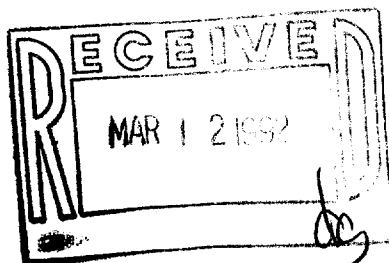

HAROLD H. KOLB

WISCONSIN REGISTERED LAND SURVEYOR, S-187

DATE OCTOBER 19, 1990

REVISED

005-1193

FON-141

SIH-18