


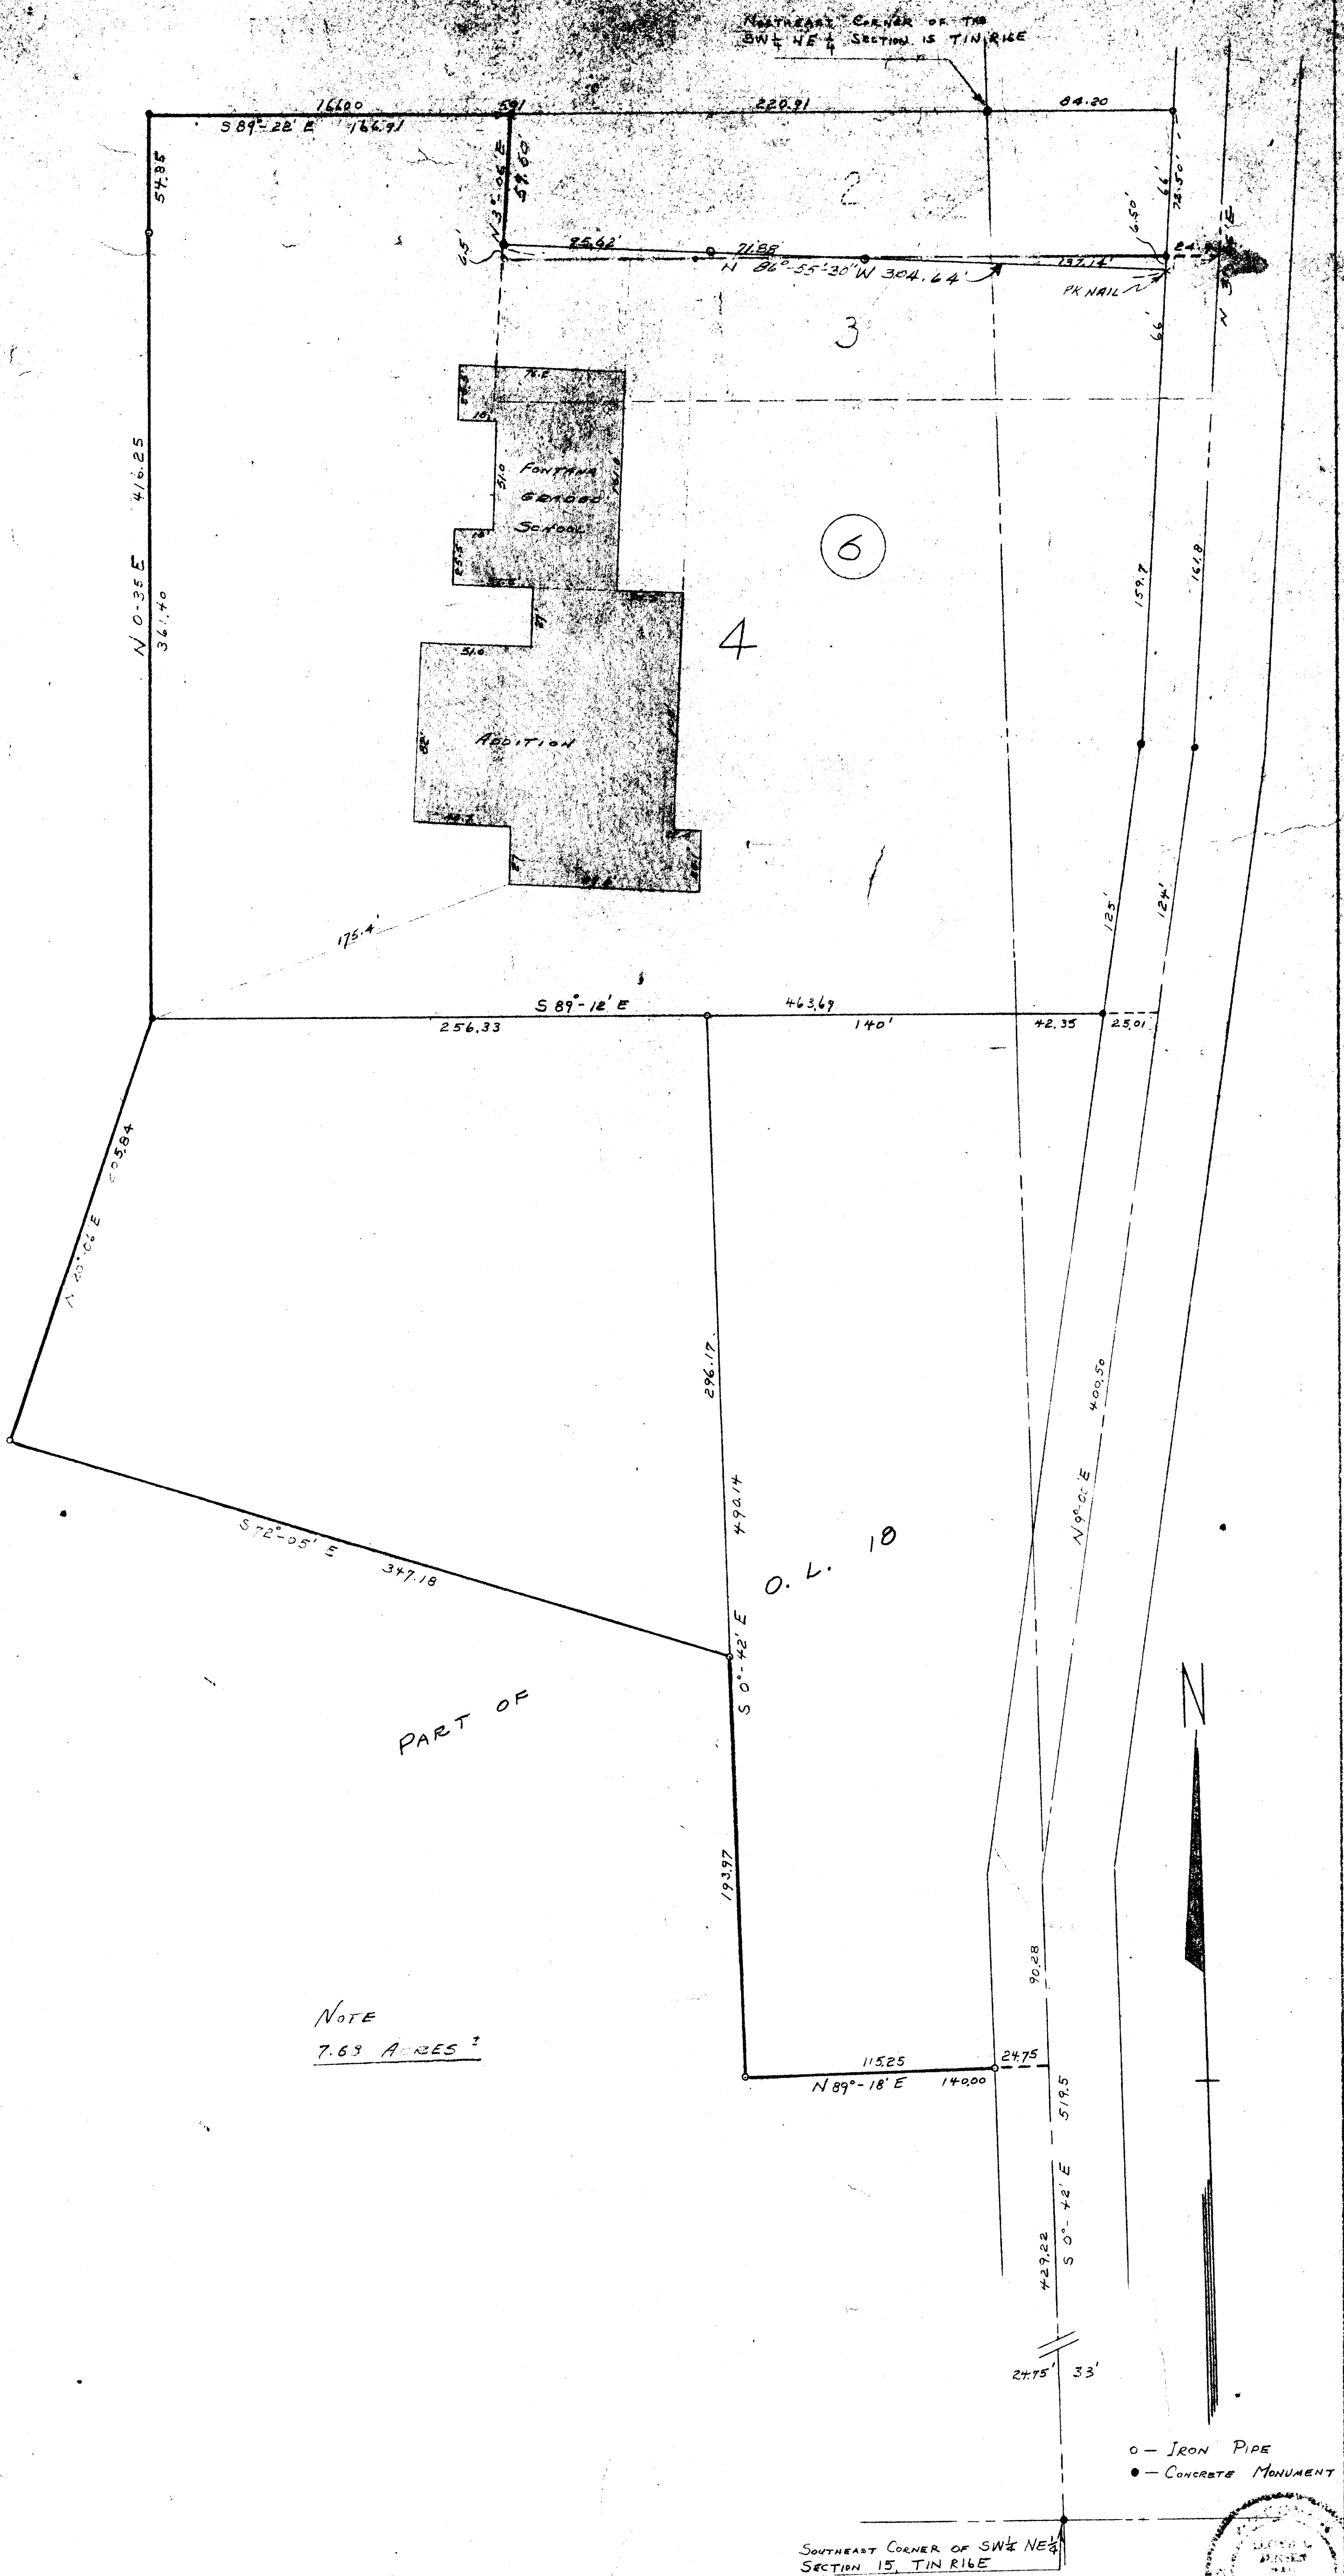

PLAT OF SURVEY
OF
LOTS 2, 3 & 4; BLOCK 6 OF C. L. DOUGLASS ADD.
AND
PART OF O. L. 18 OF ASSESSORS PLAT No. 1
LOCATED IN THE SW 1/4 NE 1/4 SECTION 15, T16R16E,
VILLAGE OF FONTANA - ON - GENEVA LAKE
WALWORTH COUNTY, WISCONSIN

SCALE 1" = 40'

APRIL 1955
JAN. 1965 AUG 1967

Lloyd L. Jensen
SURVEYOR

STEV-30 (part) + FV-200