


GEORGE T. DUNHAM
SURVEYING & SUBDIVIDING
DELAVER, WISCONSIN

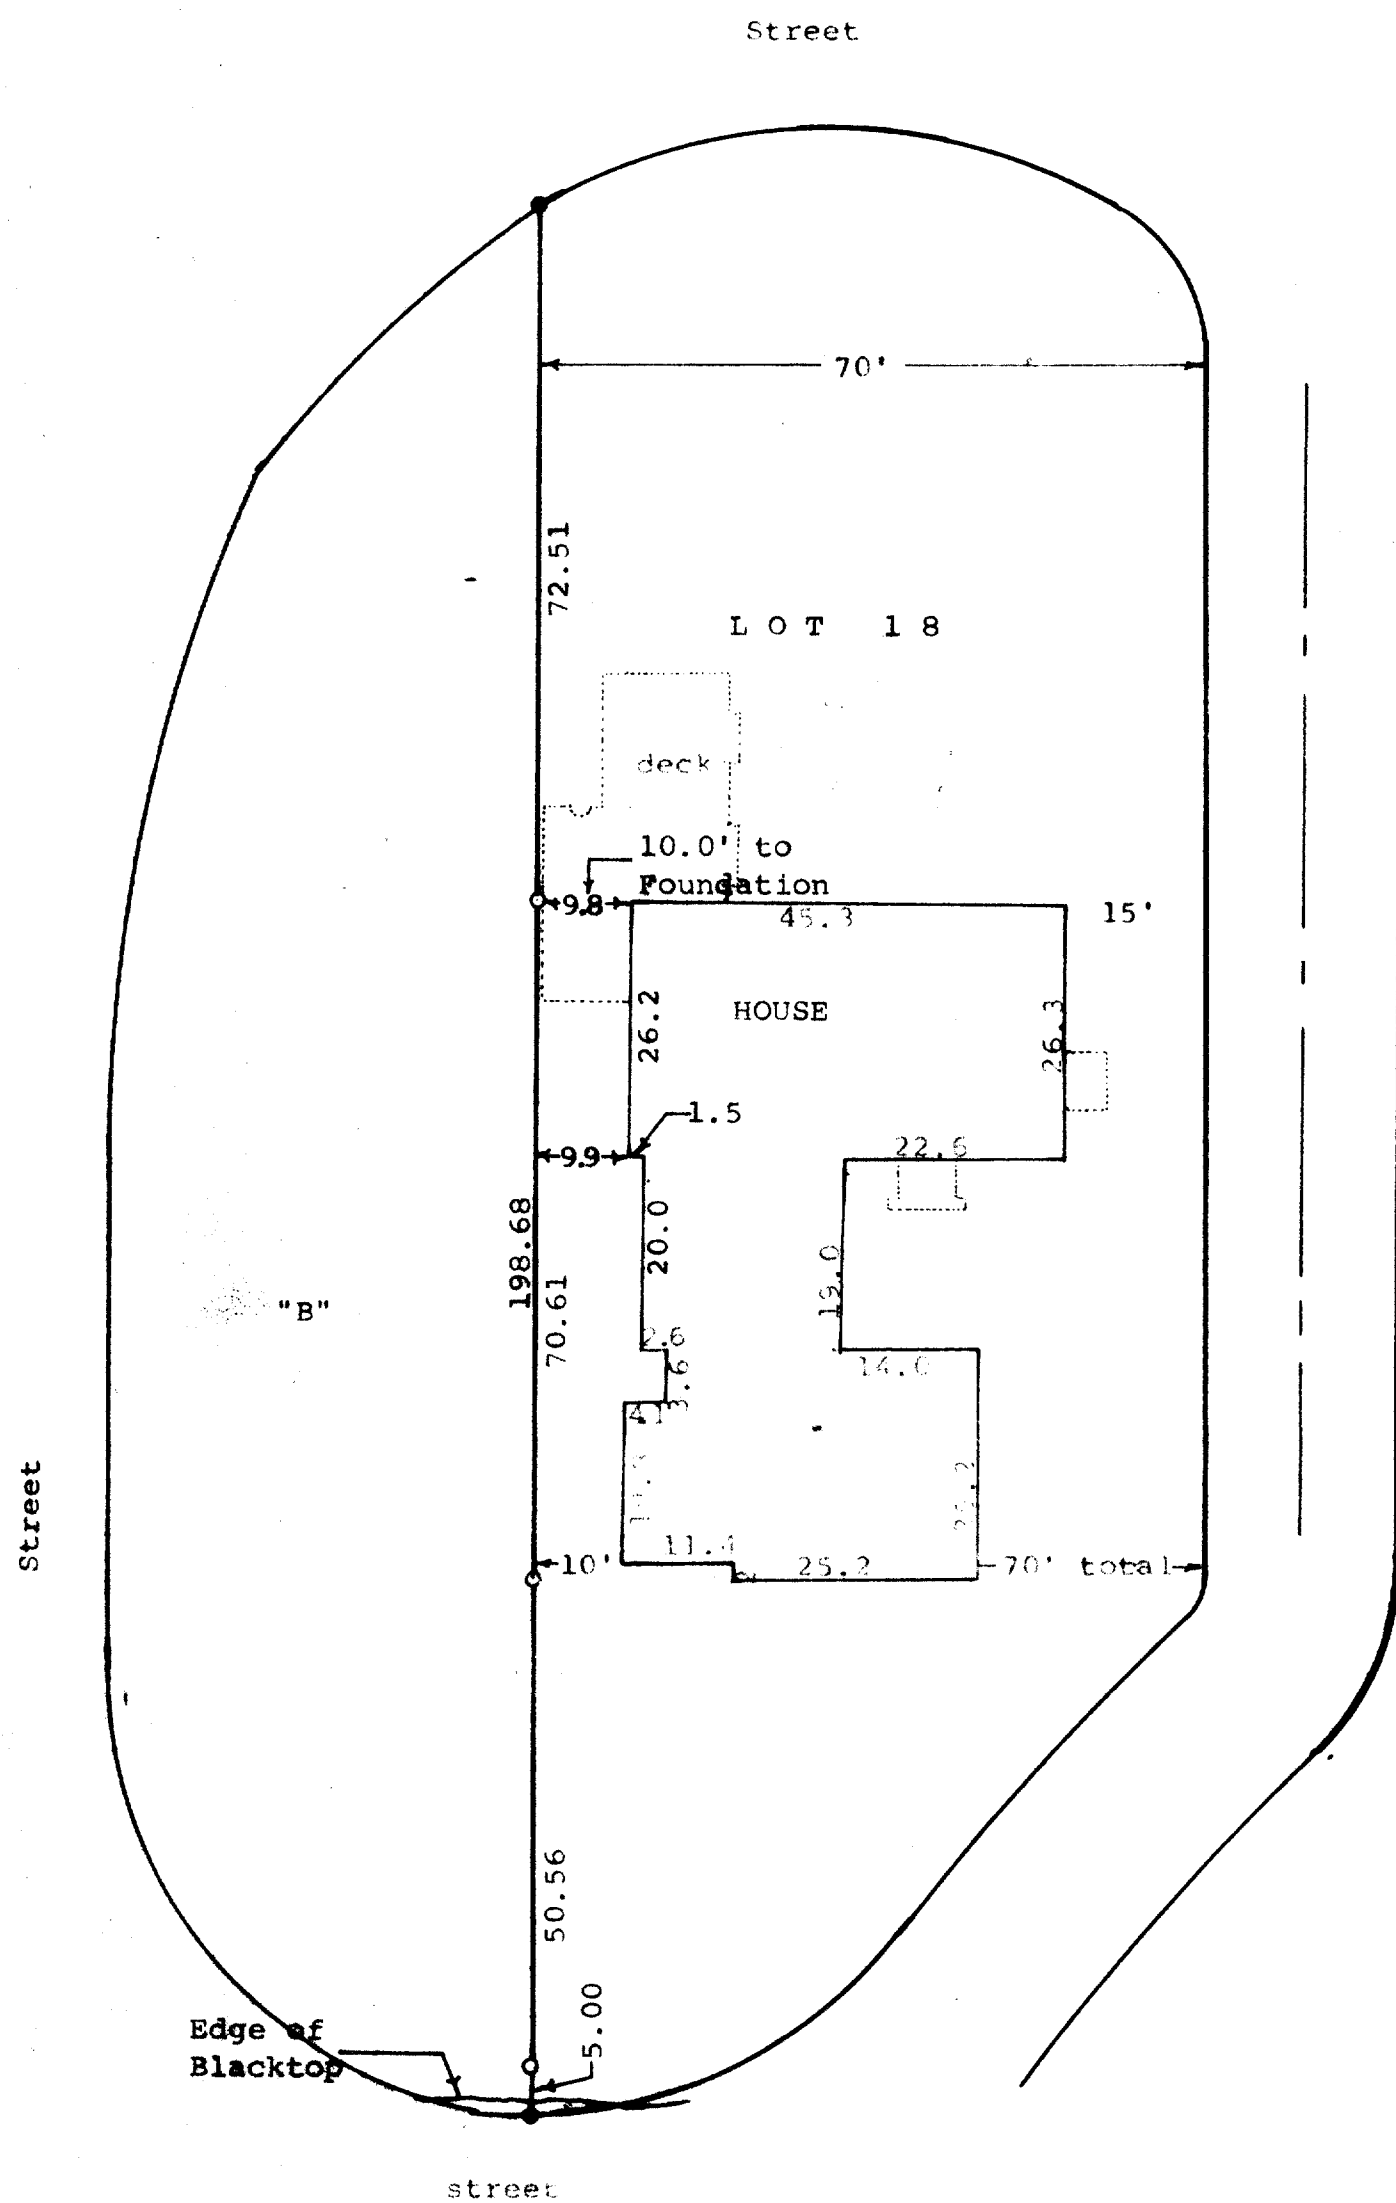

N

Scale - 1" = 20'
o = Iron Pipe
● = Concrete Monument

Plat of survey of the West line of Lot 18 of
Club Unique, a subdivision located in the
Village of Fontana, Walworth County, Wisconsin.
June 28, 1974
Revised 1/20/93 to show building additions
George T. Dunham, Surveyor

