




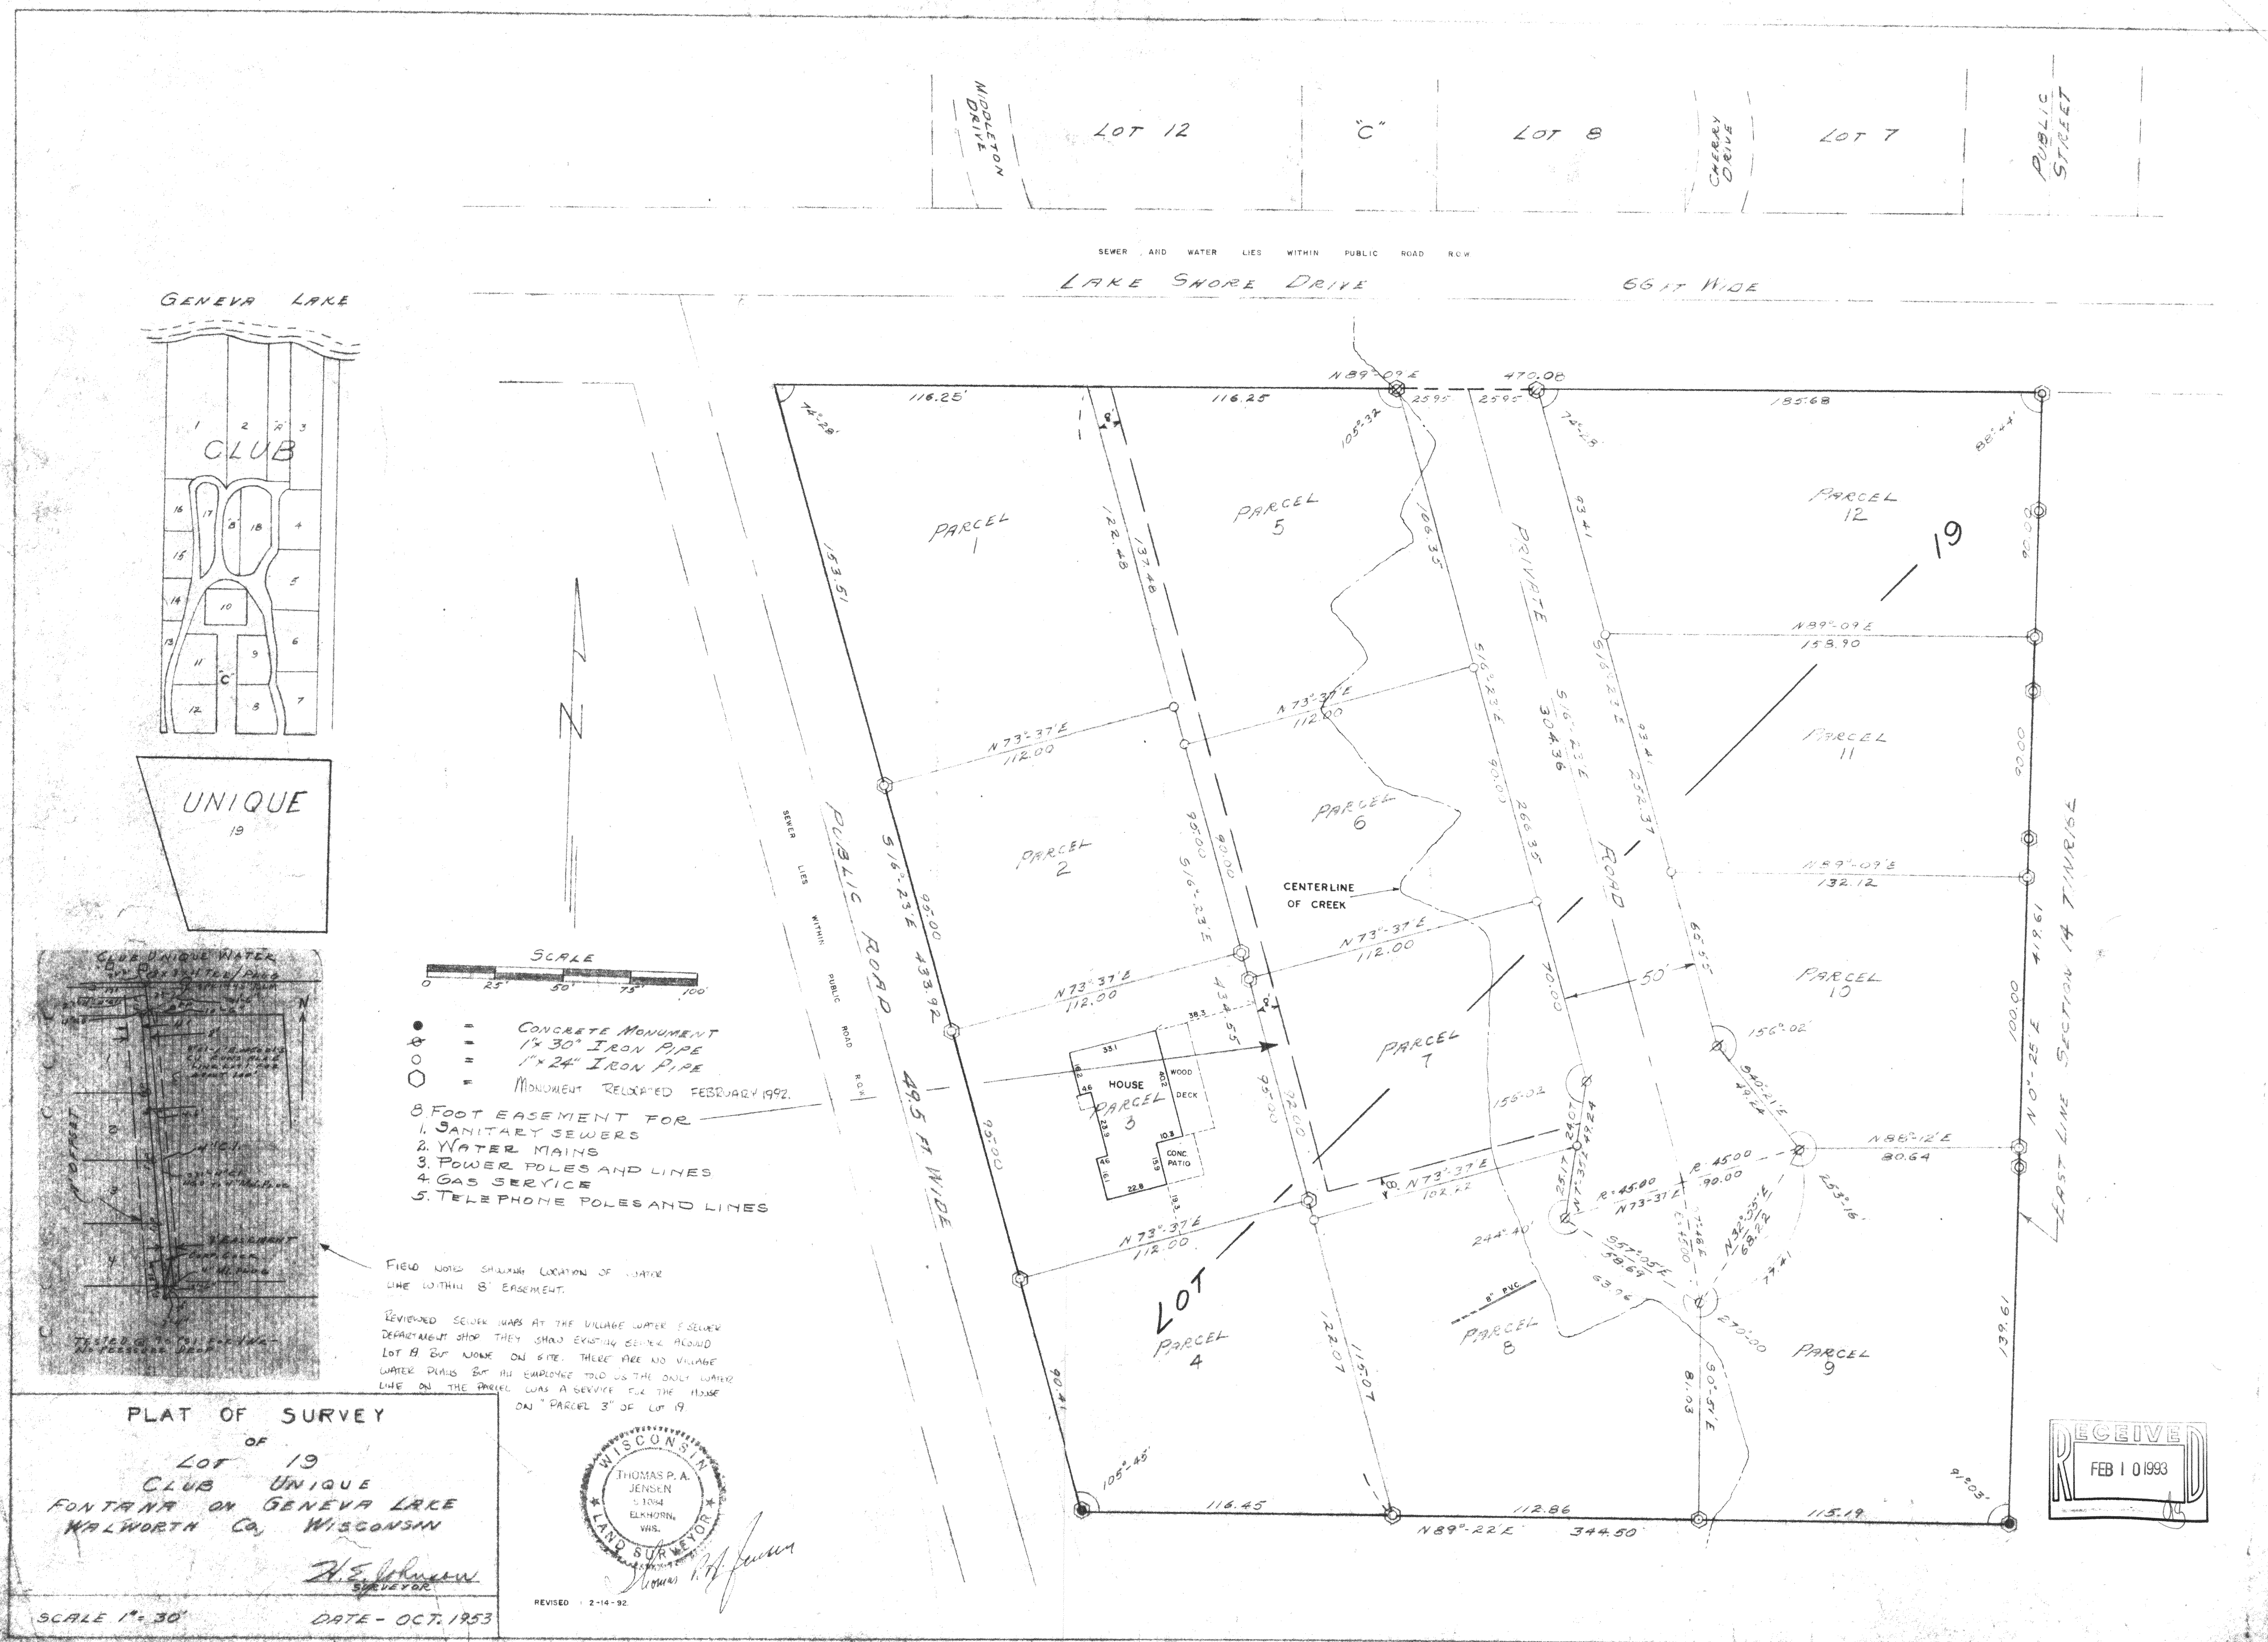

GENEVA LAKE

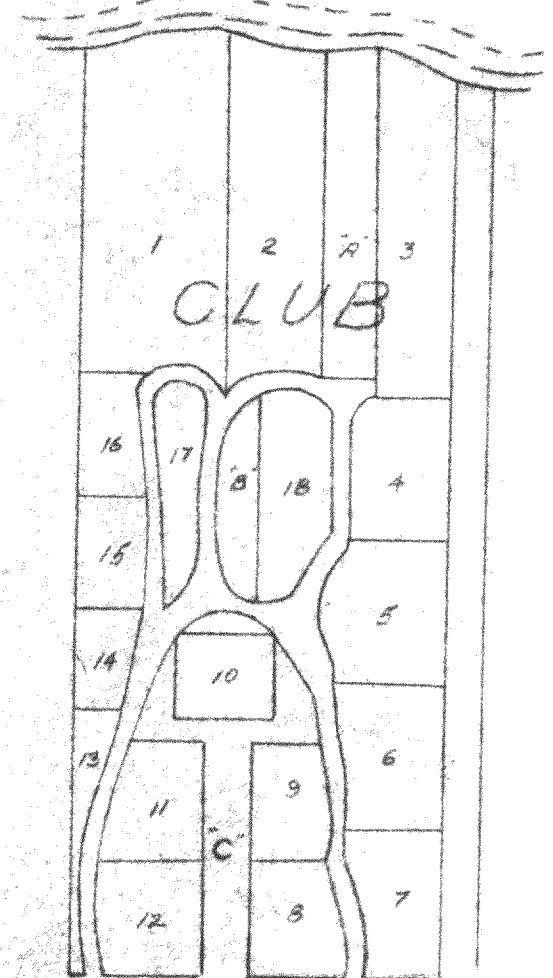

UNIQUE
19

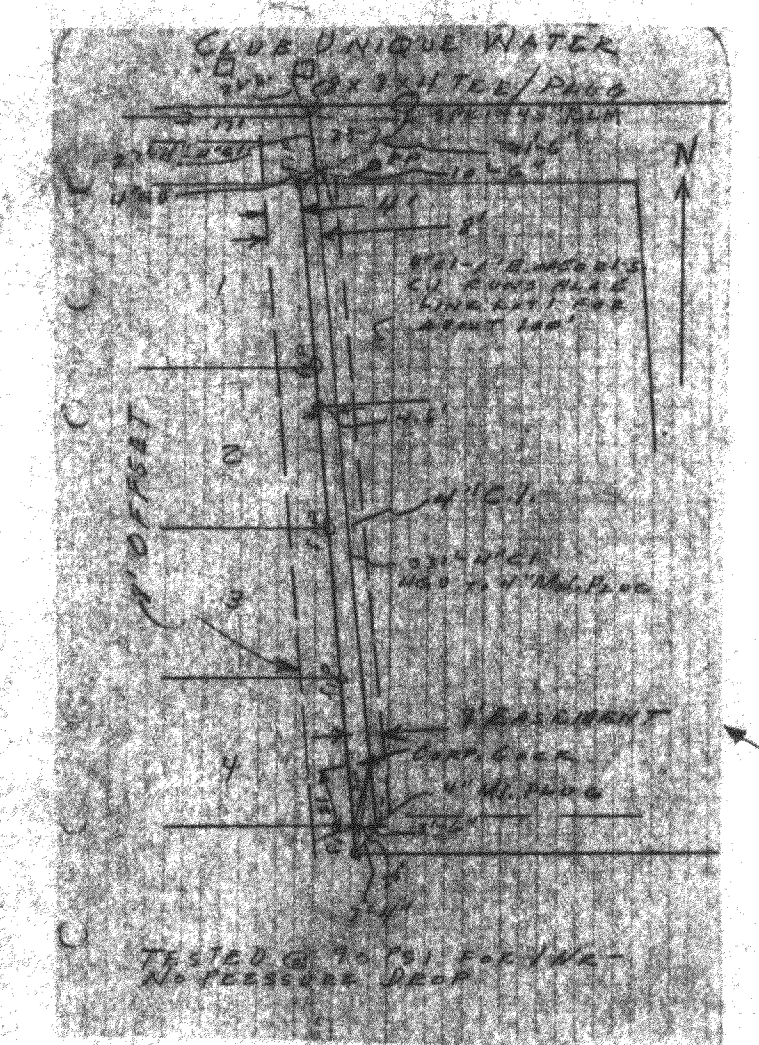

- SCALE
0 25 50 75 100
- CONCRETE MONUMENT
 - 1" 30" IRON PIPE
 - 1" 24" IRON PIPE
 - MONUMENT RELAYED FEBRUARY 1992.
- 8 FOOT EASEMENT FOR
1. SANITARY SEWERS
 2. WATER MAINS
 3. POWER POLES AND LINES
 4. GAS SERVICE
 5. TELEPHONE POLES AND LINES

FIELD NOTES SHOWING LOCATION OF WATER LINE WITHIN 8' EASEMENT.

REVIEWED SEWER MAPS AT THE VILLAGE WATER SEWER DEPARTMENT SHOP THEY SHOW EXISTING SEWER ALONG LOT B BUT NONE ON SITE. THERE ARE NO VILLAGE WATER PIPES BUT AN EMPLOYEE TOLD US THE ONLY WATER LINE ON THE PARCEL WAS A SERVICE FOR THE HOUSE ON "PARCEL 3" OF LOT 19.

PLAT OF SURVEY
OF
LOT 19
CLUB UNIQUE
FONTANA ON GENEVA LAKE
WALWORTH CO, WISCONSIN

W.E. Jensen
SURVEYOR

SCALE 1" = 30'
DATE - OCT. 1953

