


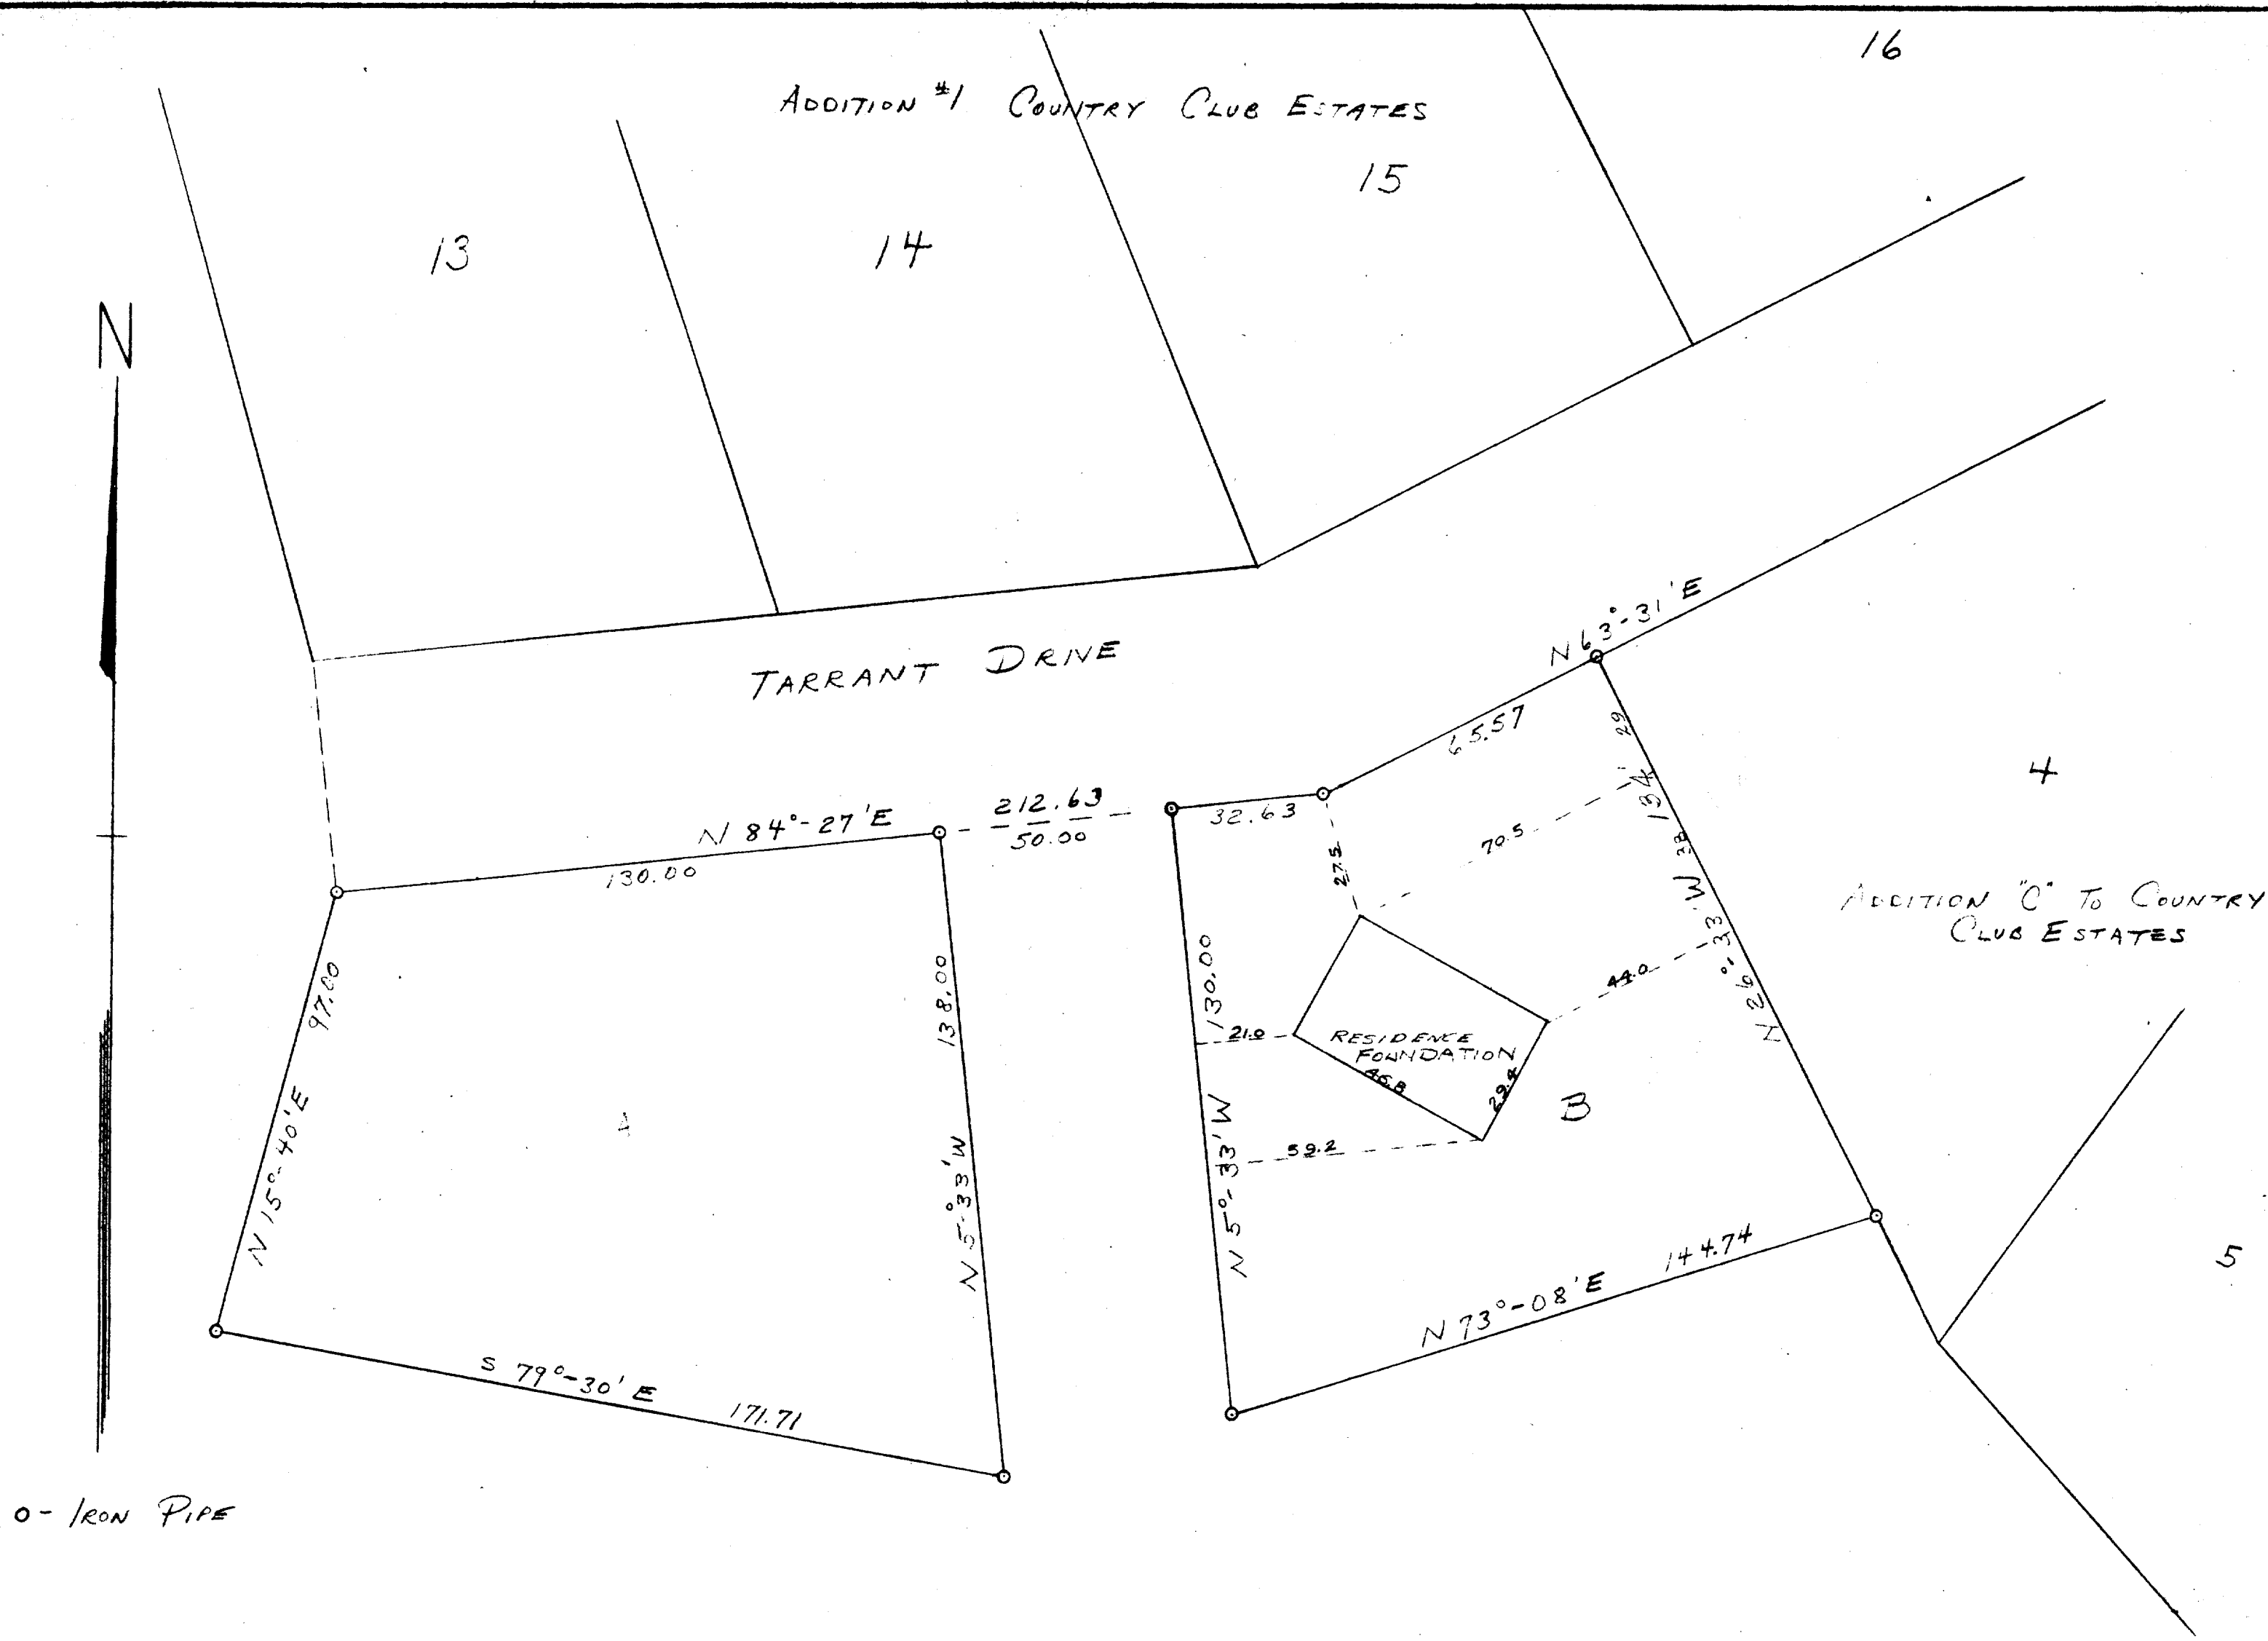

STATE OF WISCONSIN } ss
COUNTY OF WALWORTH }

I, LLOYD L. JENSEN DO HEREBY CERTIFY THAT I HAVE SURVEYED LOT B SHOWN HEREON AND THAT THE ABOVE PLAT IS A CORRECT REPRESENTATION OF THE LOT LINES AND PRINCIPAL LINES OF BUILDINGS THEREON.

Lloyd L. Jensen
(LLOYD L. JENSEN COUNTY SURVEYOR)
SEPTEMBER 13, 1957

PLAT OF SURVEY OF

LAND LOCATED IN THE SW 1/4
OF SECTION 14, T16N R16E
VILLAGE OF FONTANA-ON-GENEVA
LAKE, WALWORTH COUNTY, WISCONSIN

Lloyd L. Jensen
SURVEYOR

SCALE 1" = 30'

DATE Nov. 1956