


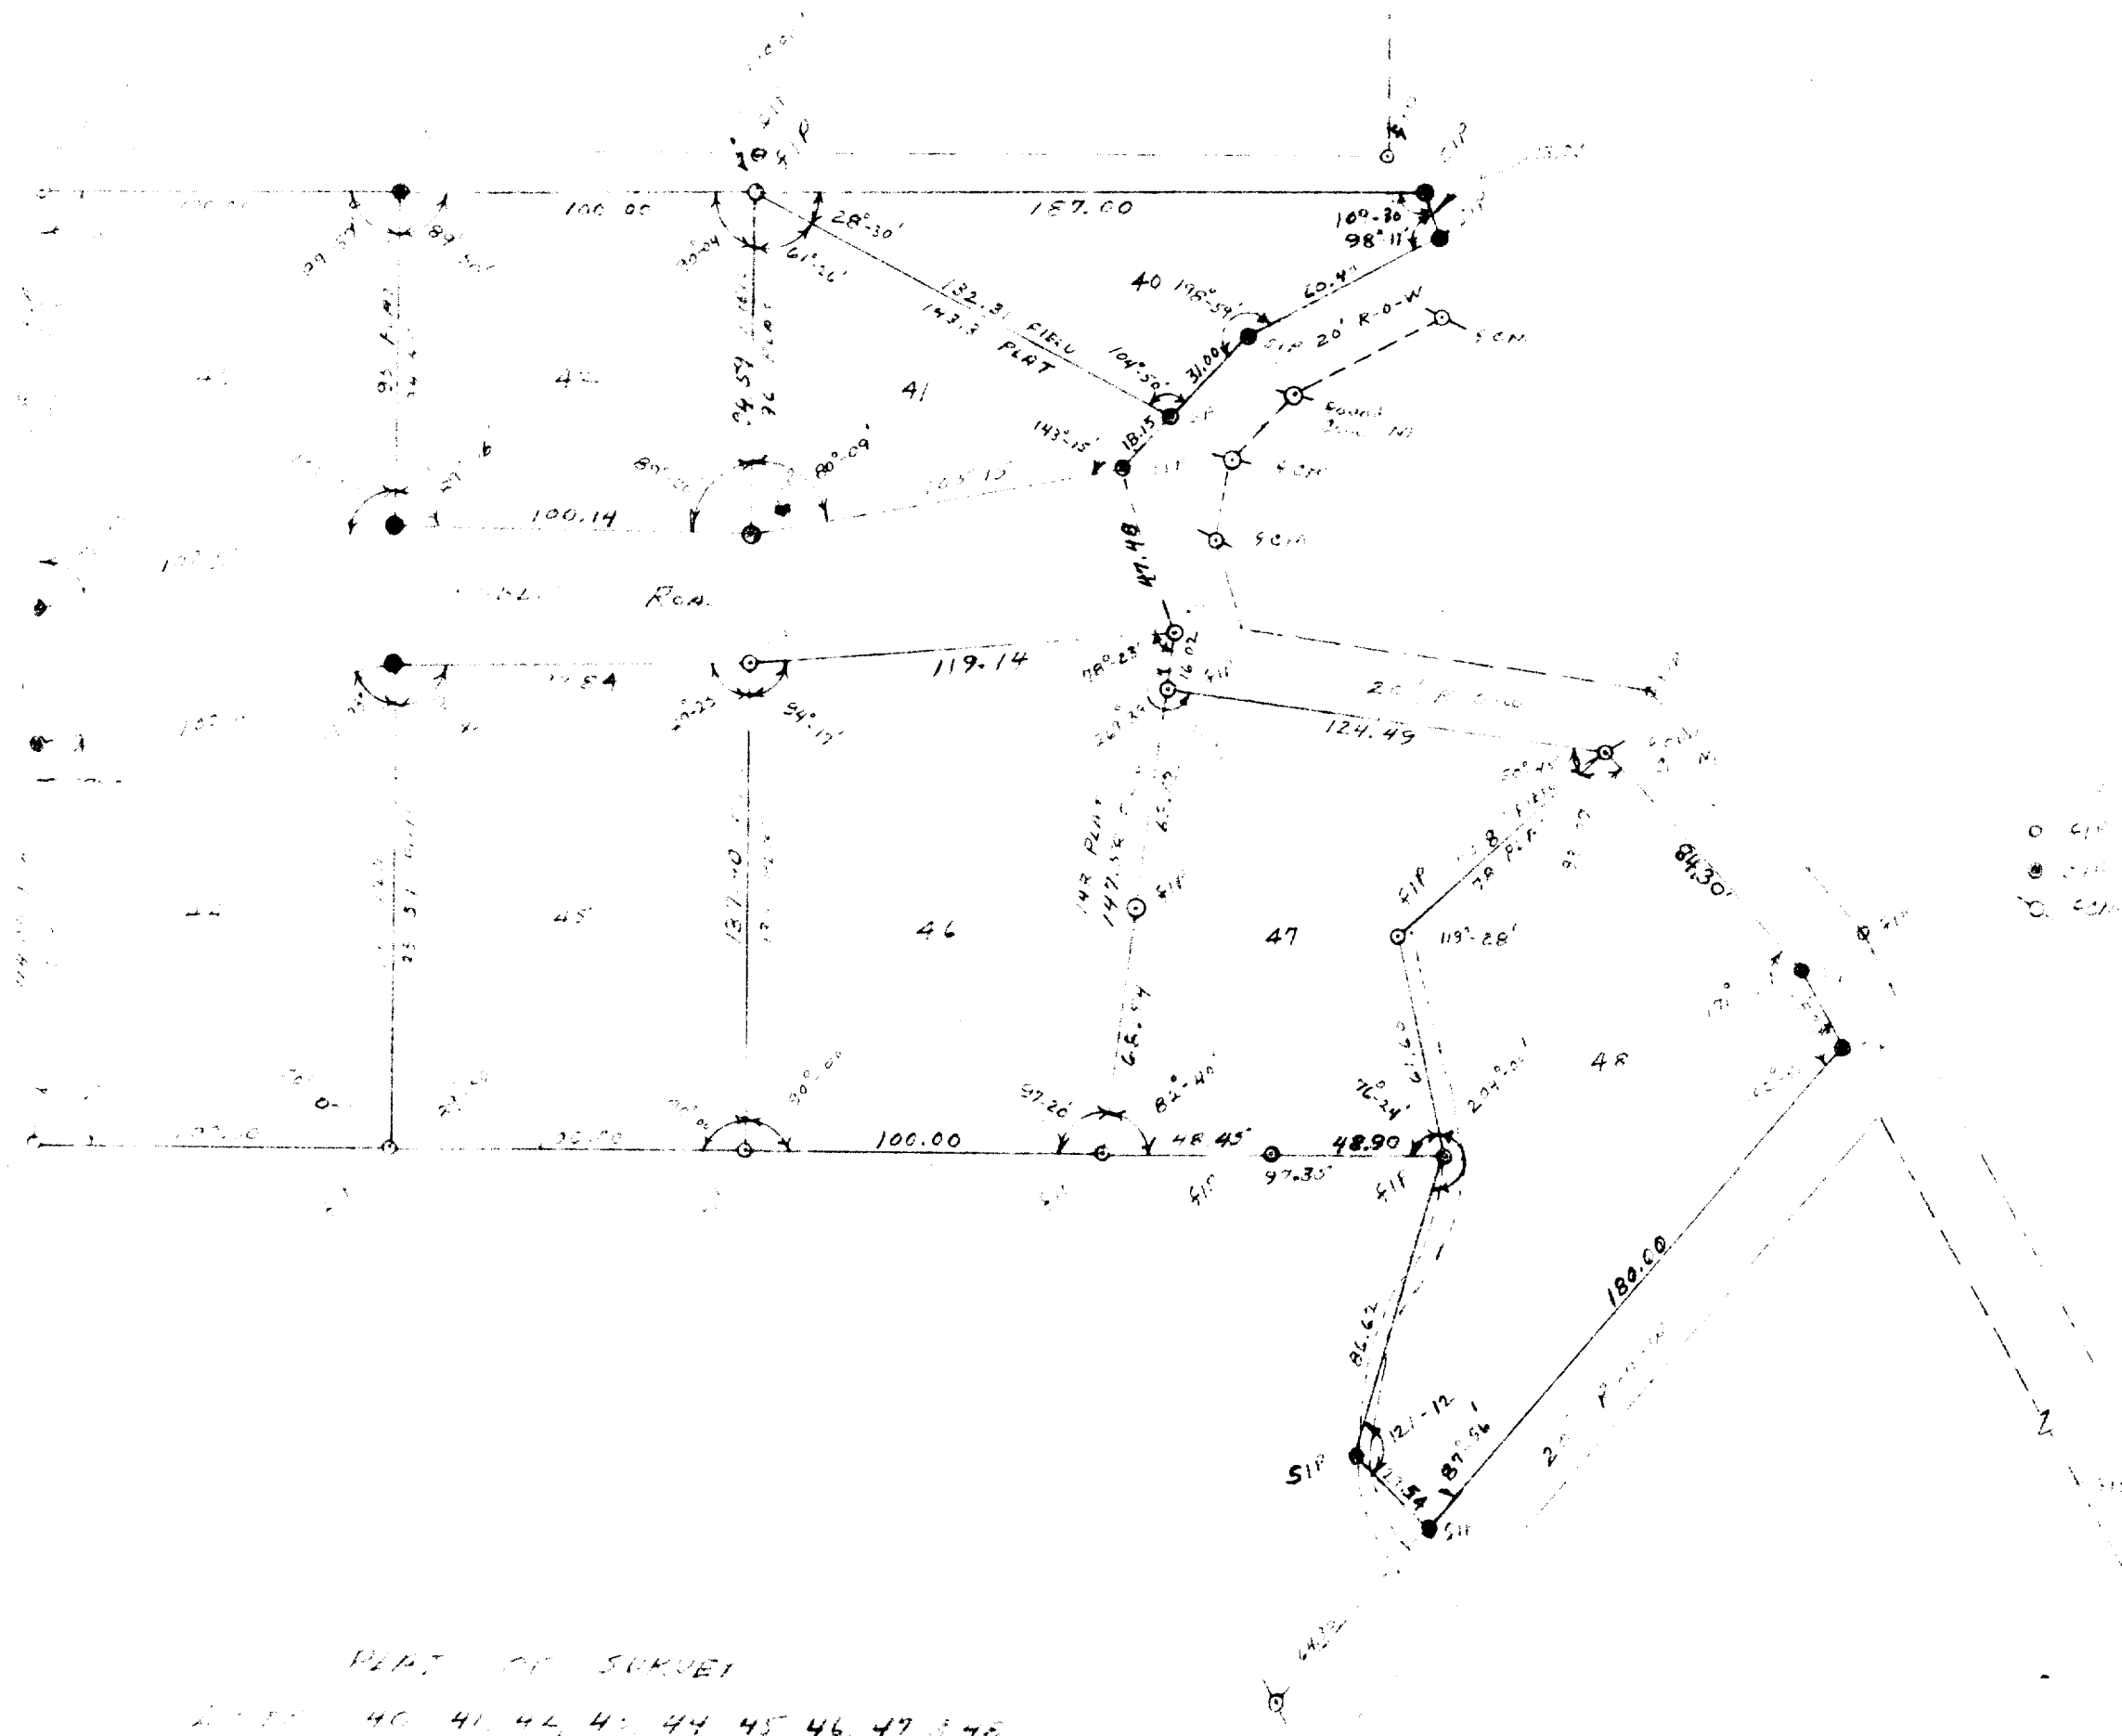

1" = 50'
 O CIP FOUND 2nd P.M.
 • CIP 1ST IRON PINE
 O CIP FOUND CORNER = MAIN

PART OF SURVEY
 LOTS 40, 41, 44, 45, 46, 47, 48
 THE GALE'S SUBDIVISION
 VILLAGE OF MONTANA-ON GENEVA LAKE
 WISCONSIN

