




○-IRON PIPE
■-STONE MONU.

GENEVA LAKE

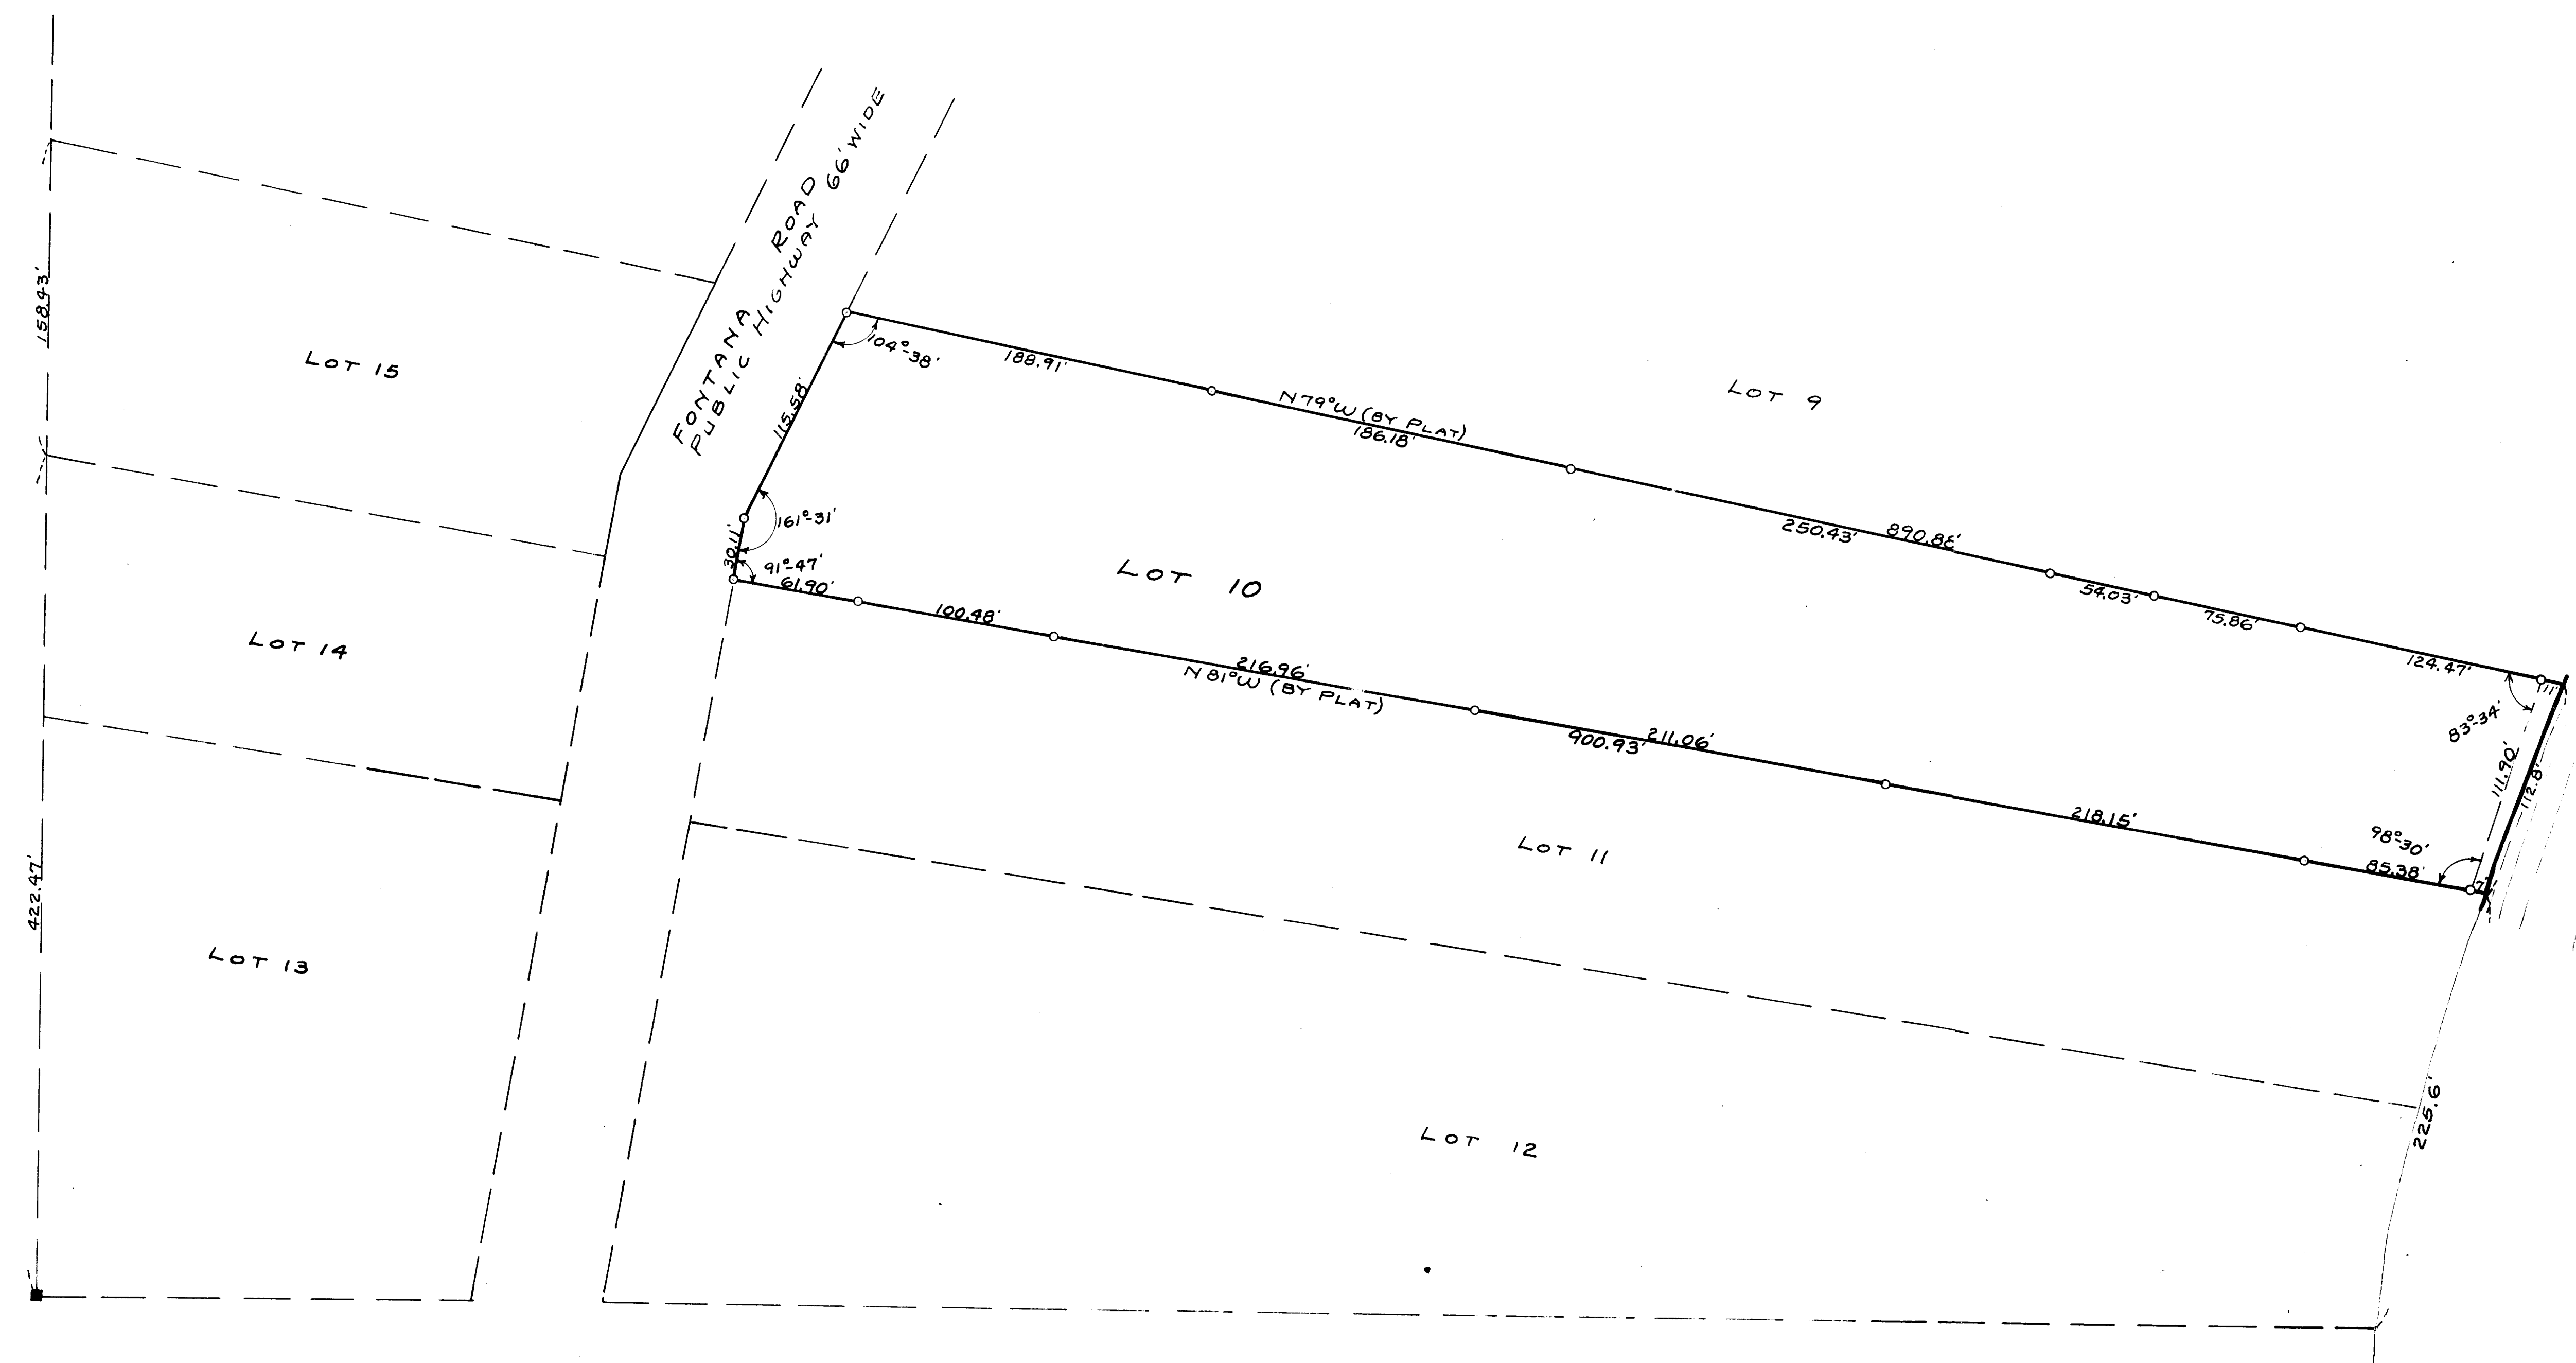

BUENA VISTA PARK SUBDIVISION

PLAT OF SURVEY OF LOT 10 OF STEARNS & GEROLDS SUBD.		
LOCATED IN FONTANA-ON-GENEVA LAKE, WISCONSIN		
DRAWN BY <i>Royd S. Jensen</i>	JENSEN & JOHNSON CIVIL ENGINEERS ELKHORN, WIS.	SCALE: 1" = 50'
CHECKED BY		REVISED
APPROVED BY	DATE DECEMBER 1955	SHEET NO. OF

594-9