


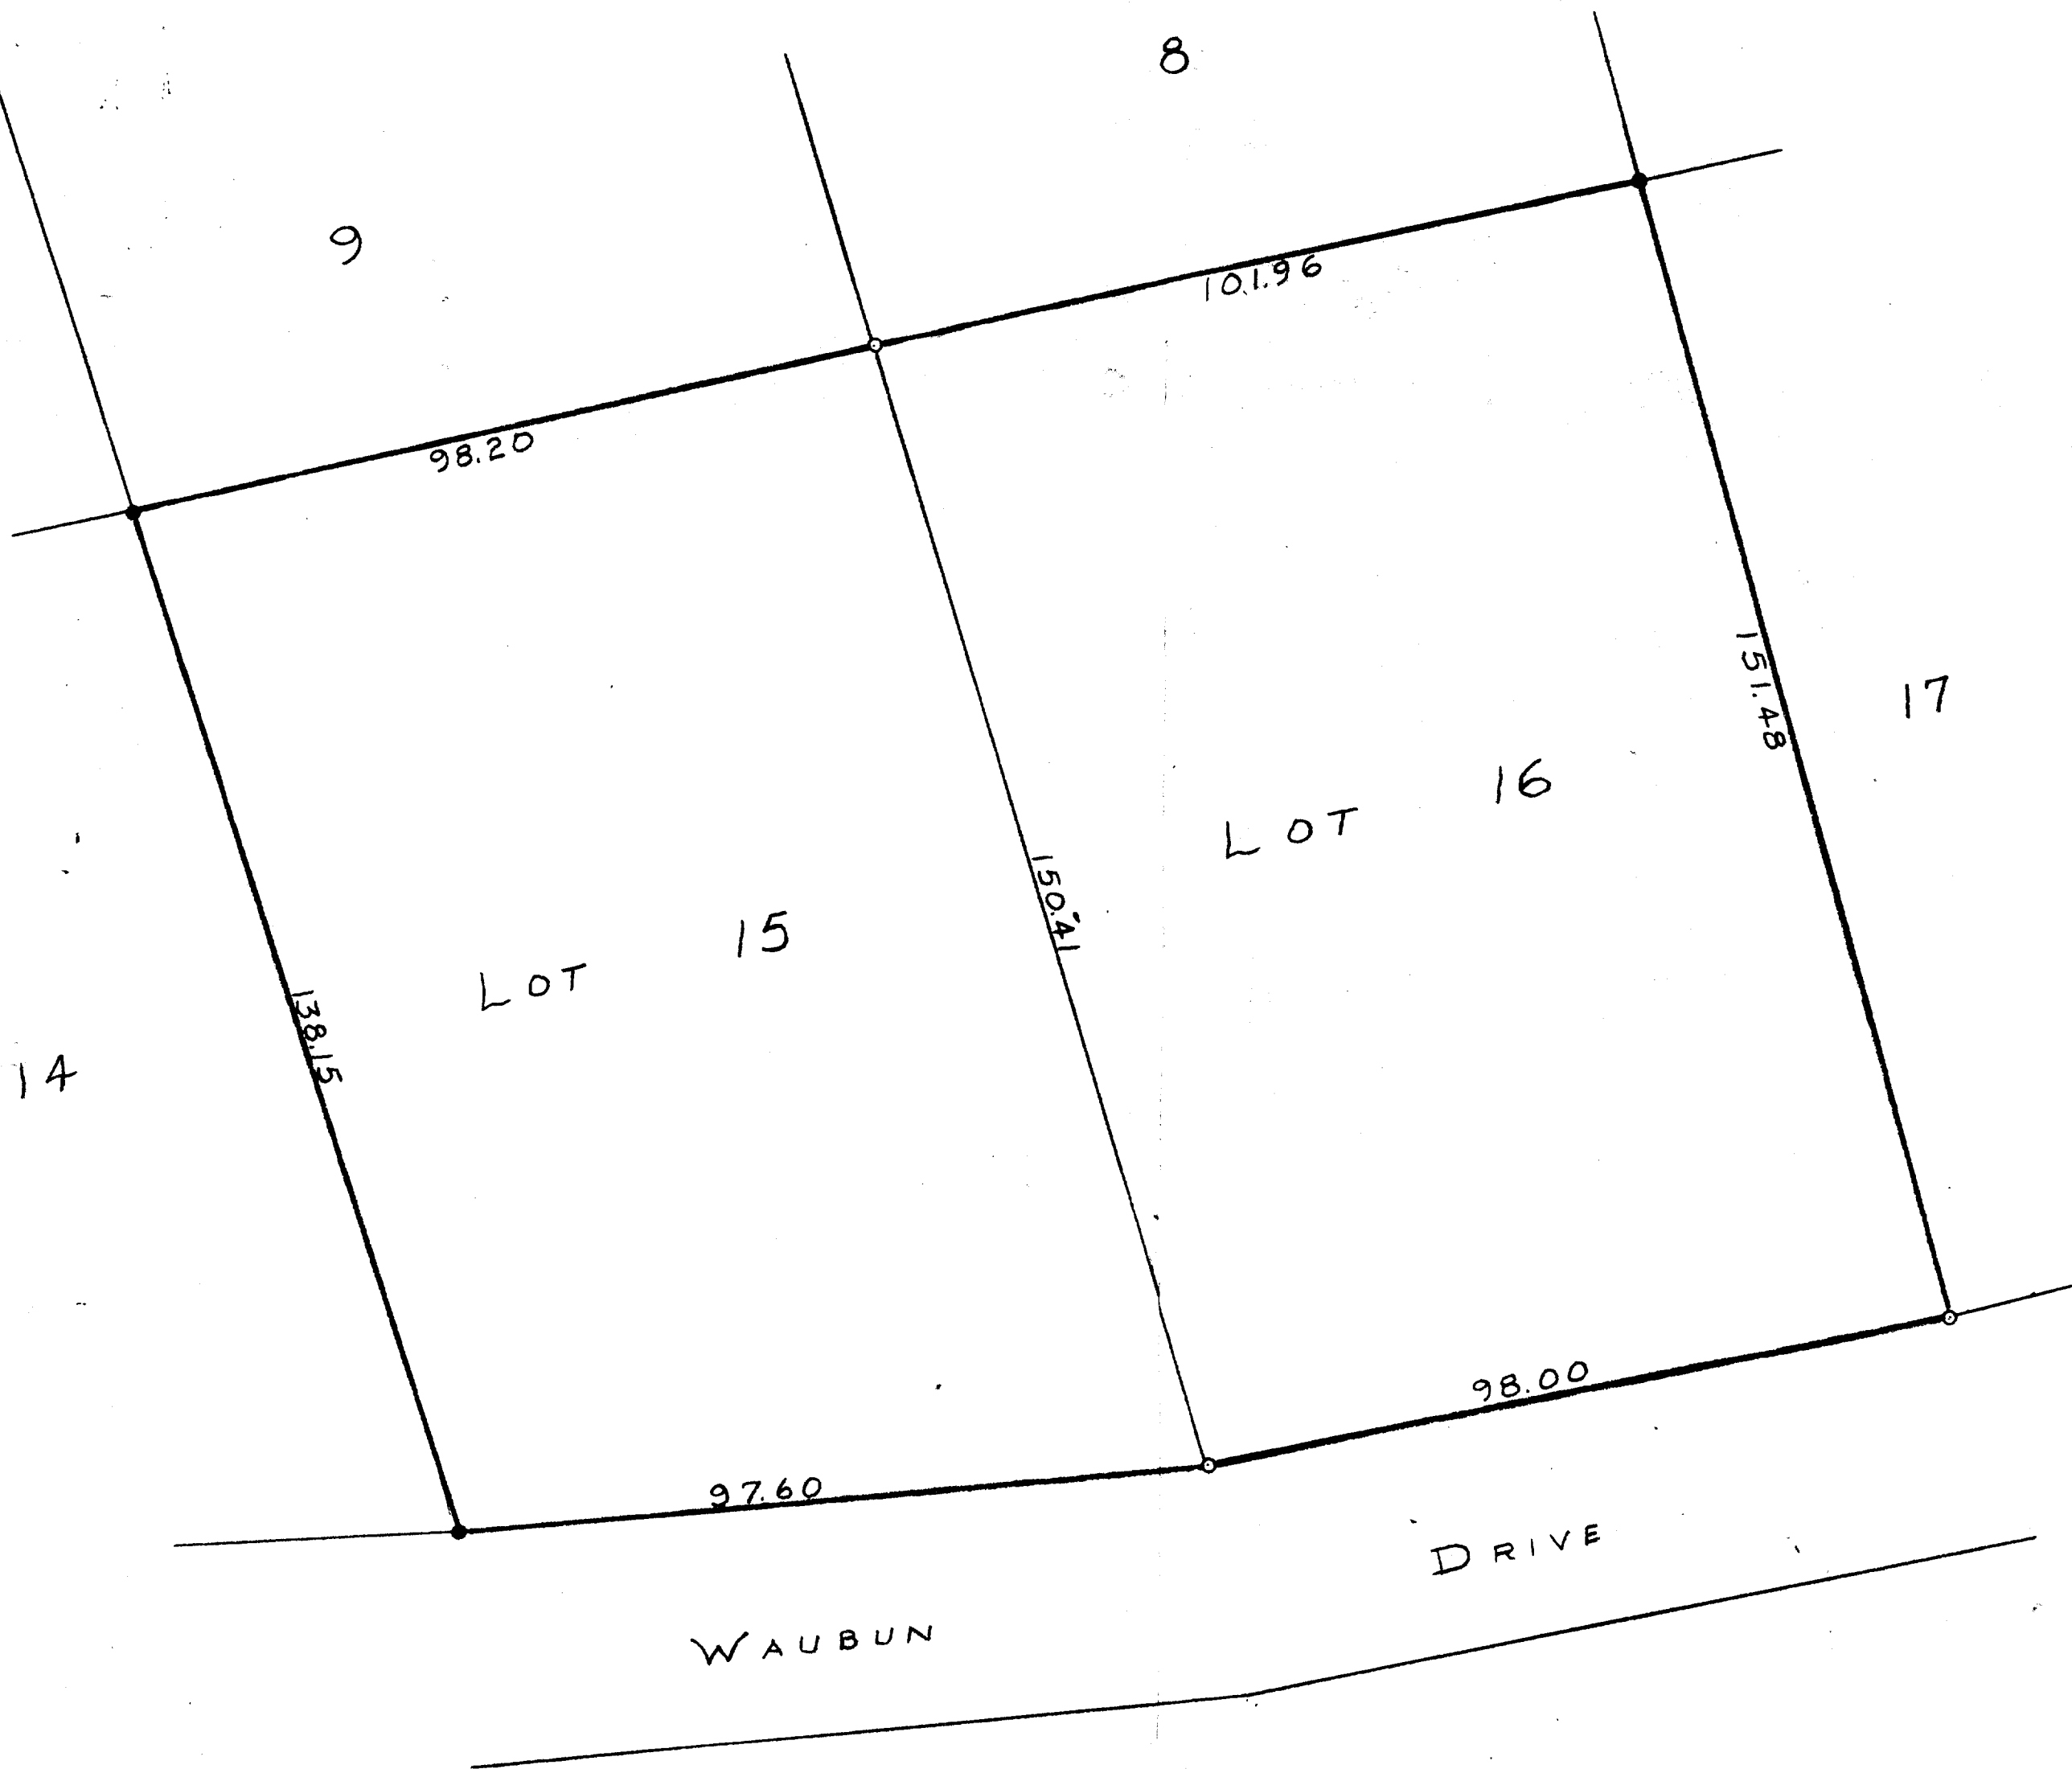

SCALE ~ 1" = 20'
 O = IRON PIPE
 ● = CONC. MONU.

PLAT OF SURVEY OF LOTS 15 AND 16, COUNTRY CLUB ESTATES
 UNIT NO. 2 OF FONTANA ON GENEVA LAKE, WALWORTH
 COUNTY, WISCONSIN
 FEBRUARY 18, 1955

George T. Dunham
 GEORGE T. DUNHAM, SURVEYOR
 DELAVAN, WISCONSIN

5002-X3

5-13