

ROBERS & FISCHER, INC.
CONSULTING ENGINEERS & LAND SURVEYORS

PHONE (414) 763-2652



116 E. CHESTNUT ST.

BURLINGTON, WIS. 53106

PLAT OF SURVEY & HOUSE LOCATION
OF

Lot 8, Block 1, Assessor's Plat # 1 of C.L. Douglass Addition, Village
of Fontana-on-Geneva Lake, Walworth County, Wisconsin.

LEGEND
 ⊙ FOUND IRON PIPE
 ● SET IRON PIPE
 ⊗ FOUND CONC. MON
 SCALE 1"=30'

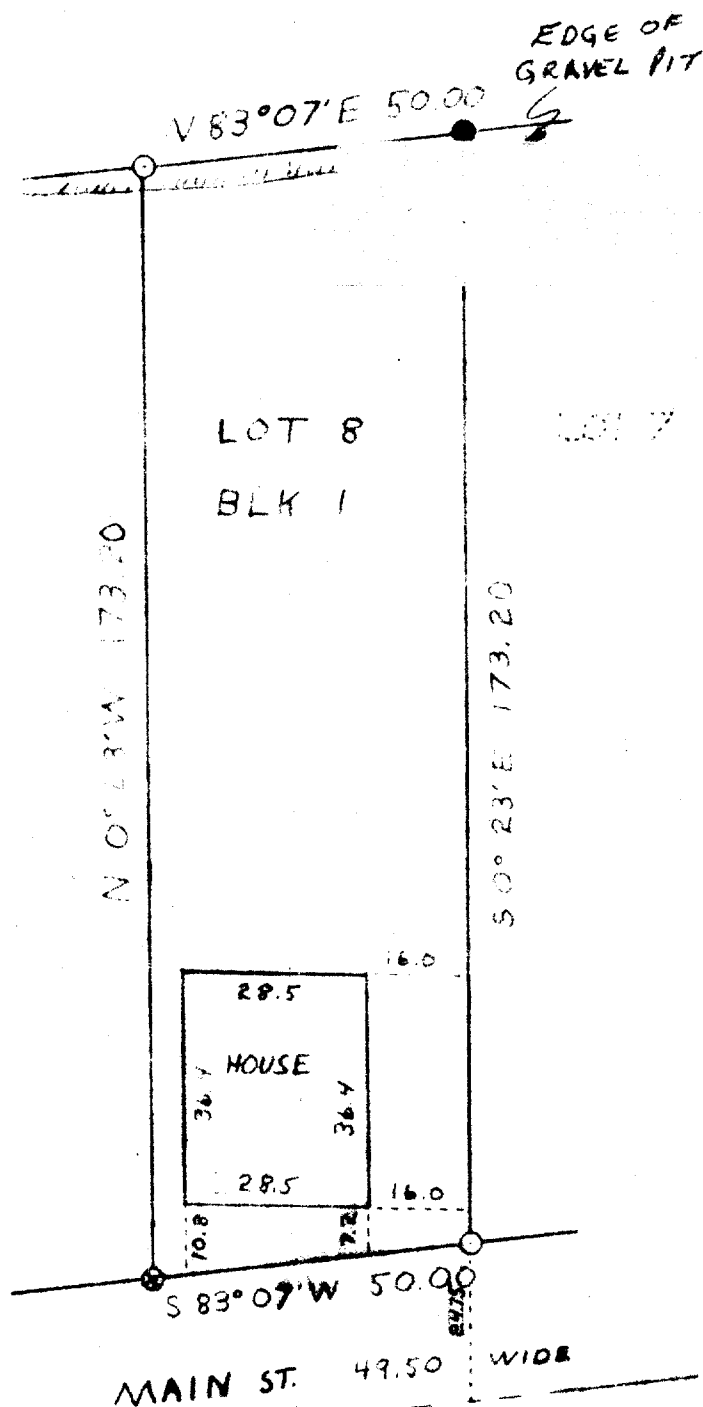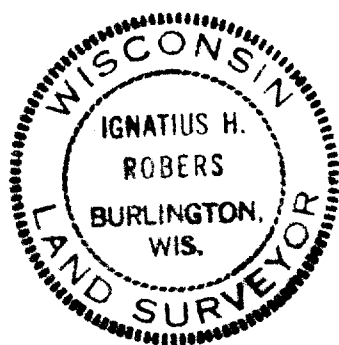

I HEREBY CERTIFY THAT WE HAVE SURVEYED THE LANDS DESCRIBED
 ABOVE ACCORDING TO OFFICIAL RECORDS AND THAT THE PLAT
 DRAWN HEREON IS A CORRECT REPRESENTATION OF SAID SURVEY.

Ignatius H. Rober
 WIS. REG. LAND SURVEYOR 500787

DATE 8-16-71

5-132

JOB NO. 71106