


NW Corner
of O.L. 87

HAROLD H. KOLB

REGISTERED PROFESSIONAL LAND SURVEYOR
LAKE GENEVA, WISCONSIN

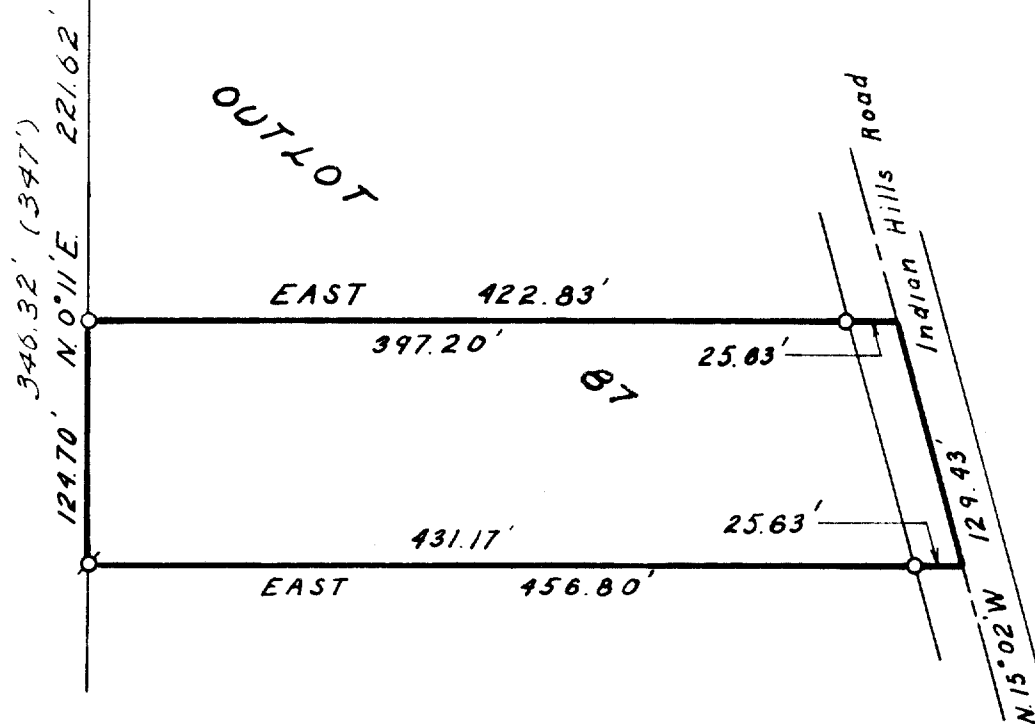


N



Scale: 1" = 100'

LEGEND

- ⊗ -- IRON PIPE FOUND
- -- IRON PIPE PLACED
- -- CONCRETE MONUMENT
- x -- SPIKE

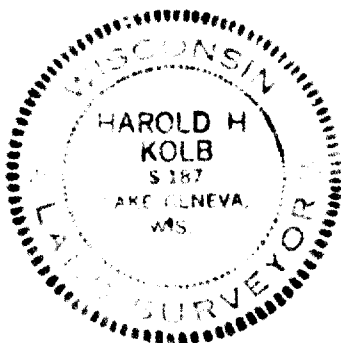

I, HAROLD H. KOLB, DO HEREBY CERTIFY THAT I HAVE
SURVEYED THE PROPERTY HEREON DESCRIBED ACCORDING
TO THE OFFICIAL RECORDS, AND THAT THE PLAT HEREON
IS A CORRECT REPRESENTATION OF THE LOT LINES.

Harold H. Kolb
HAROLD H. KOLB

WISCONSIN REGISTERED LAND SURVEYOR, S-187

DATE May 20, 1971

5-135

Lot 3 of C.A. 153