


PLAT OF SURVEY

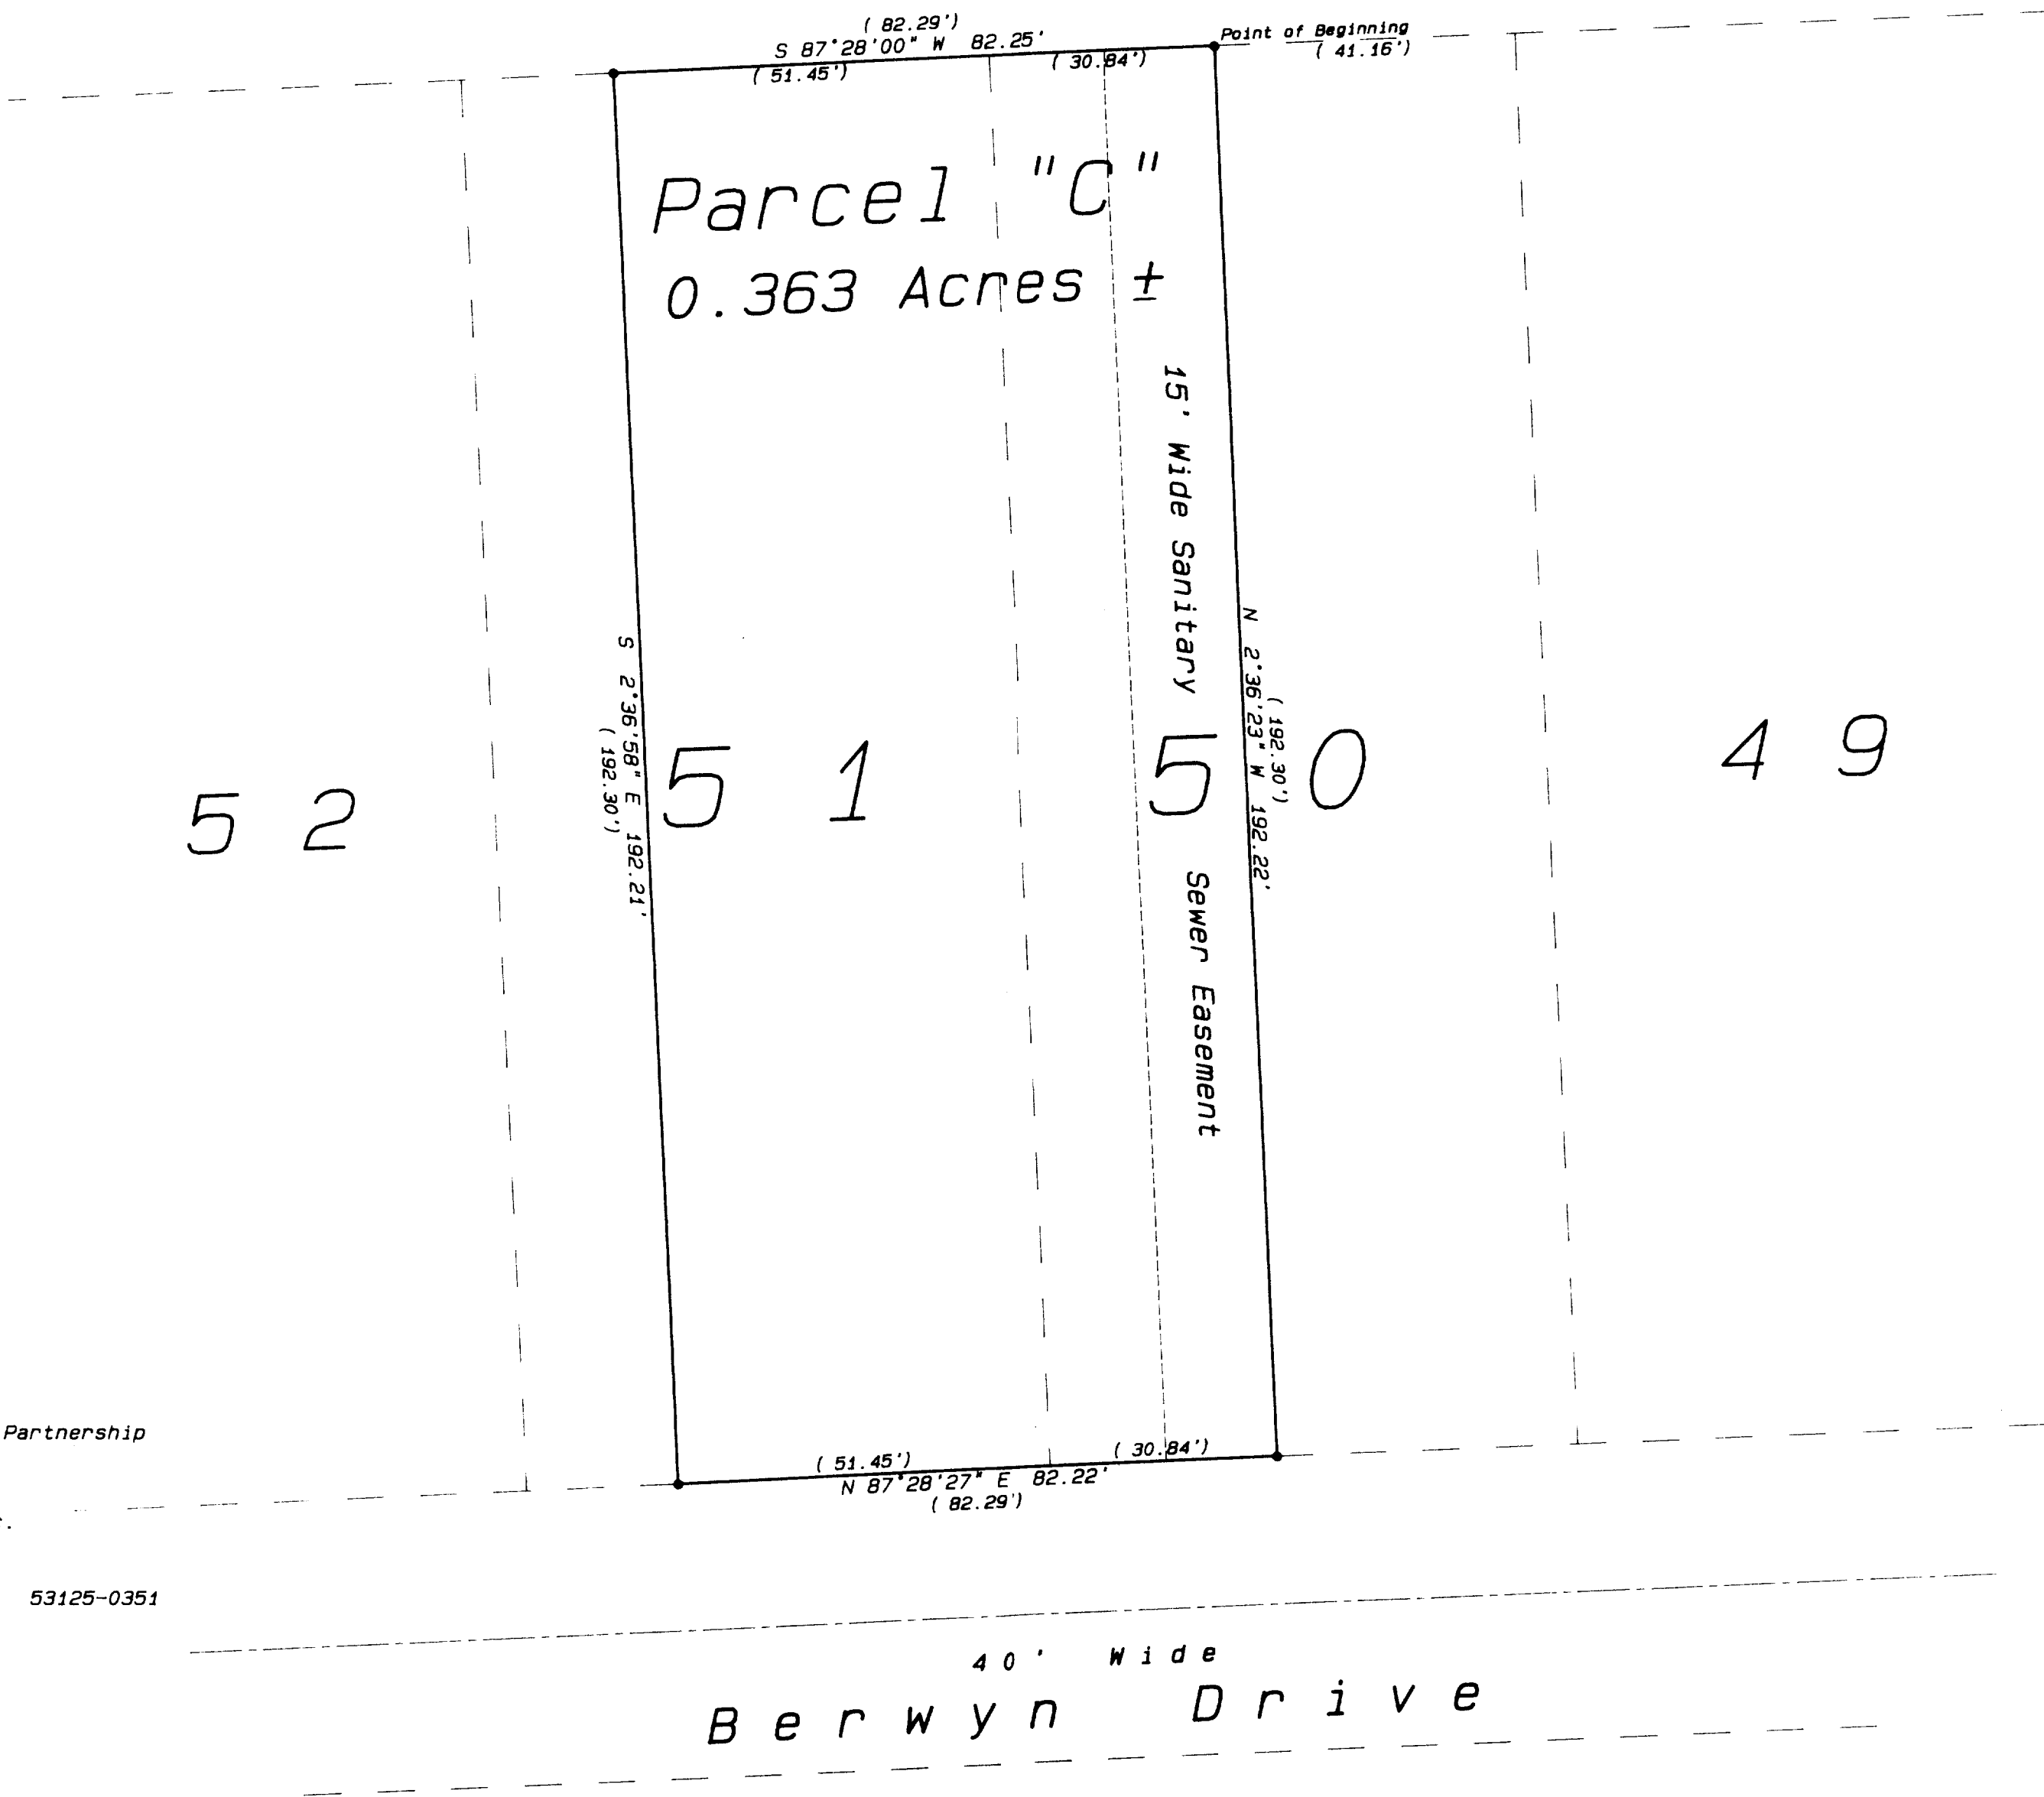

Parcel "C"

The Easterly 51.45 feet of Lot 51 and the Westerly 30.84 feet of Lot 50 of Glenwood Terrace Subdivision, as recorded in Volume 10, Page 11 of Plats, Dated July 2, 1928, being located in the North 1/2 of the Northeast 1/4 of the Northeast 1/4 of Section 23, Town 1 North, Range 16 East, Village of Fontana, County of Walworth, State of Wisconsin, more particularly described as follows:

Commencing at a Found Concrete Monument at the Northeast Corner of said Section 23, thence S 87°28'00" W along the North Line of said Section 33.00 feet to a Found Concrete Monument on the West Right-of-way Line of Indian Hills Road; thence continue S 87°28'00" E along said Section Line 1062.08 feet (recorded as 1063.16 feet) to an Iron Pipe at a point 41.16 feet (recorded as 41.16 feet) Westerly of the Northeast Corner of Lot 50 and the point of beginning; thence continue S 87°28'00" W along said Section Line 82.25 feet (recorded as 82.29 feet) to an Iron Pipe; thence S 2°36'58" E 192.21 feet (recorded as 192.30 feet) to an Iron Pipe on the North Right-of-way Line of Berwyn Drive; thence N 87°28'27" E along said North Right-of-way Line 82.22 feet (recorded as 82.29 feet) to an Iron Pipe; thence N 2°36'23" W 192.22 feet (recorded as 192.30 feet) to the point of beginning. Said parcel contains 0.363 Acres of land more or less.

Owners: Glenwood Terrace Limited Partnership


Ordered by: John O'Neill
O'Neill Builders, Inc.
Post Office Box 351
Fontana, Wisconsin

53125-0351

- Legend
- FOUND IRON PIPE
 - FOUND IRON ROD
 - FOUND BRASS CAPPED MONUMENT
 - FOUND CONCRETE MONUMENT
 - + CHISEL CUT IN CONCRETE
 - SET IRON PIPE, 24" LONG, WEIGHING 1.13 LBS./LINEAL FT., 1" DIA.
 - SET IRON ROD, 30" LONG, WEIGHING 4.5 LBS./LINEAL FT., 1-11/16" DIA.
 - (xx) RECORDED AS DIMENSION
 - - - EXISTING FENCE



SCALE: 1"= 20 FEET

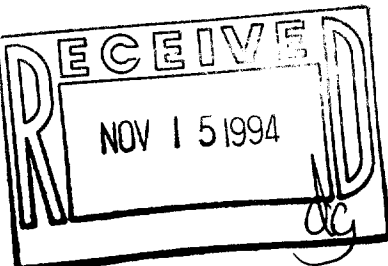

"I hereby certify that I have surveyed the above described property and that the above map is a true representation thereof and shows the size and location of the property, its exterior boundaries, the location of all visible structures and dimensions of all principal buildings thereon, boundary fences, apparent easements, roadways and visible encroachments, if any."

This survey is made for the use of the present owners of the property and also those who purchase, mortgage, or guarantee the title thereto within one year from date hereof.

Kenneth B. Abernathy, Jr.

KENNETH B. ABERNATHY, JR.
WISCONSIN REGISTERED LAND SURVEYOR,
S-1594

Date: June 15, 1994 Job No. 1994.618