



ABELL  
SURVEYING & MAPPING  
DELAVER, WISCONSIN 53115  
414-728-6737

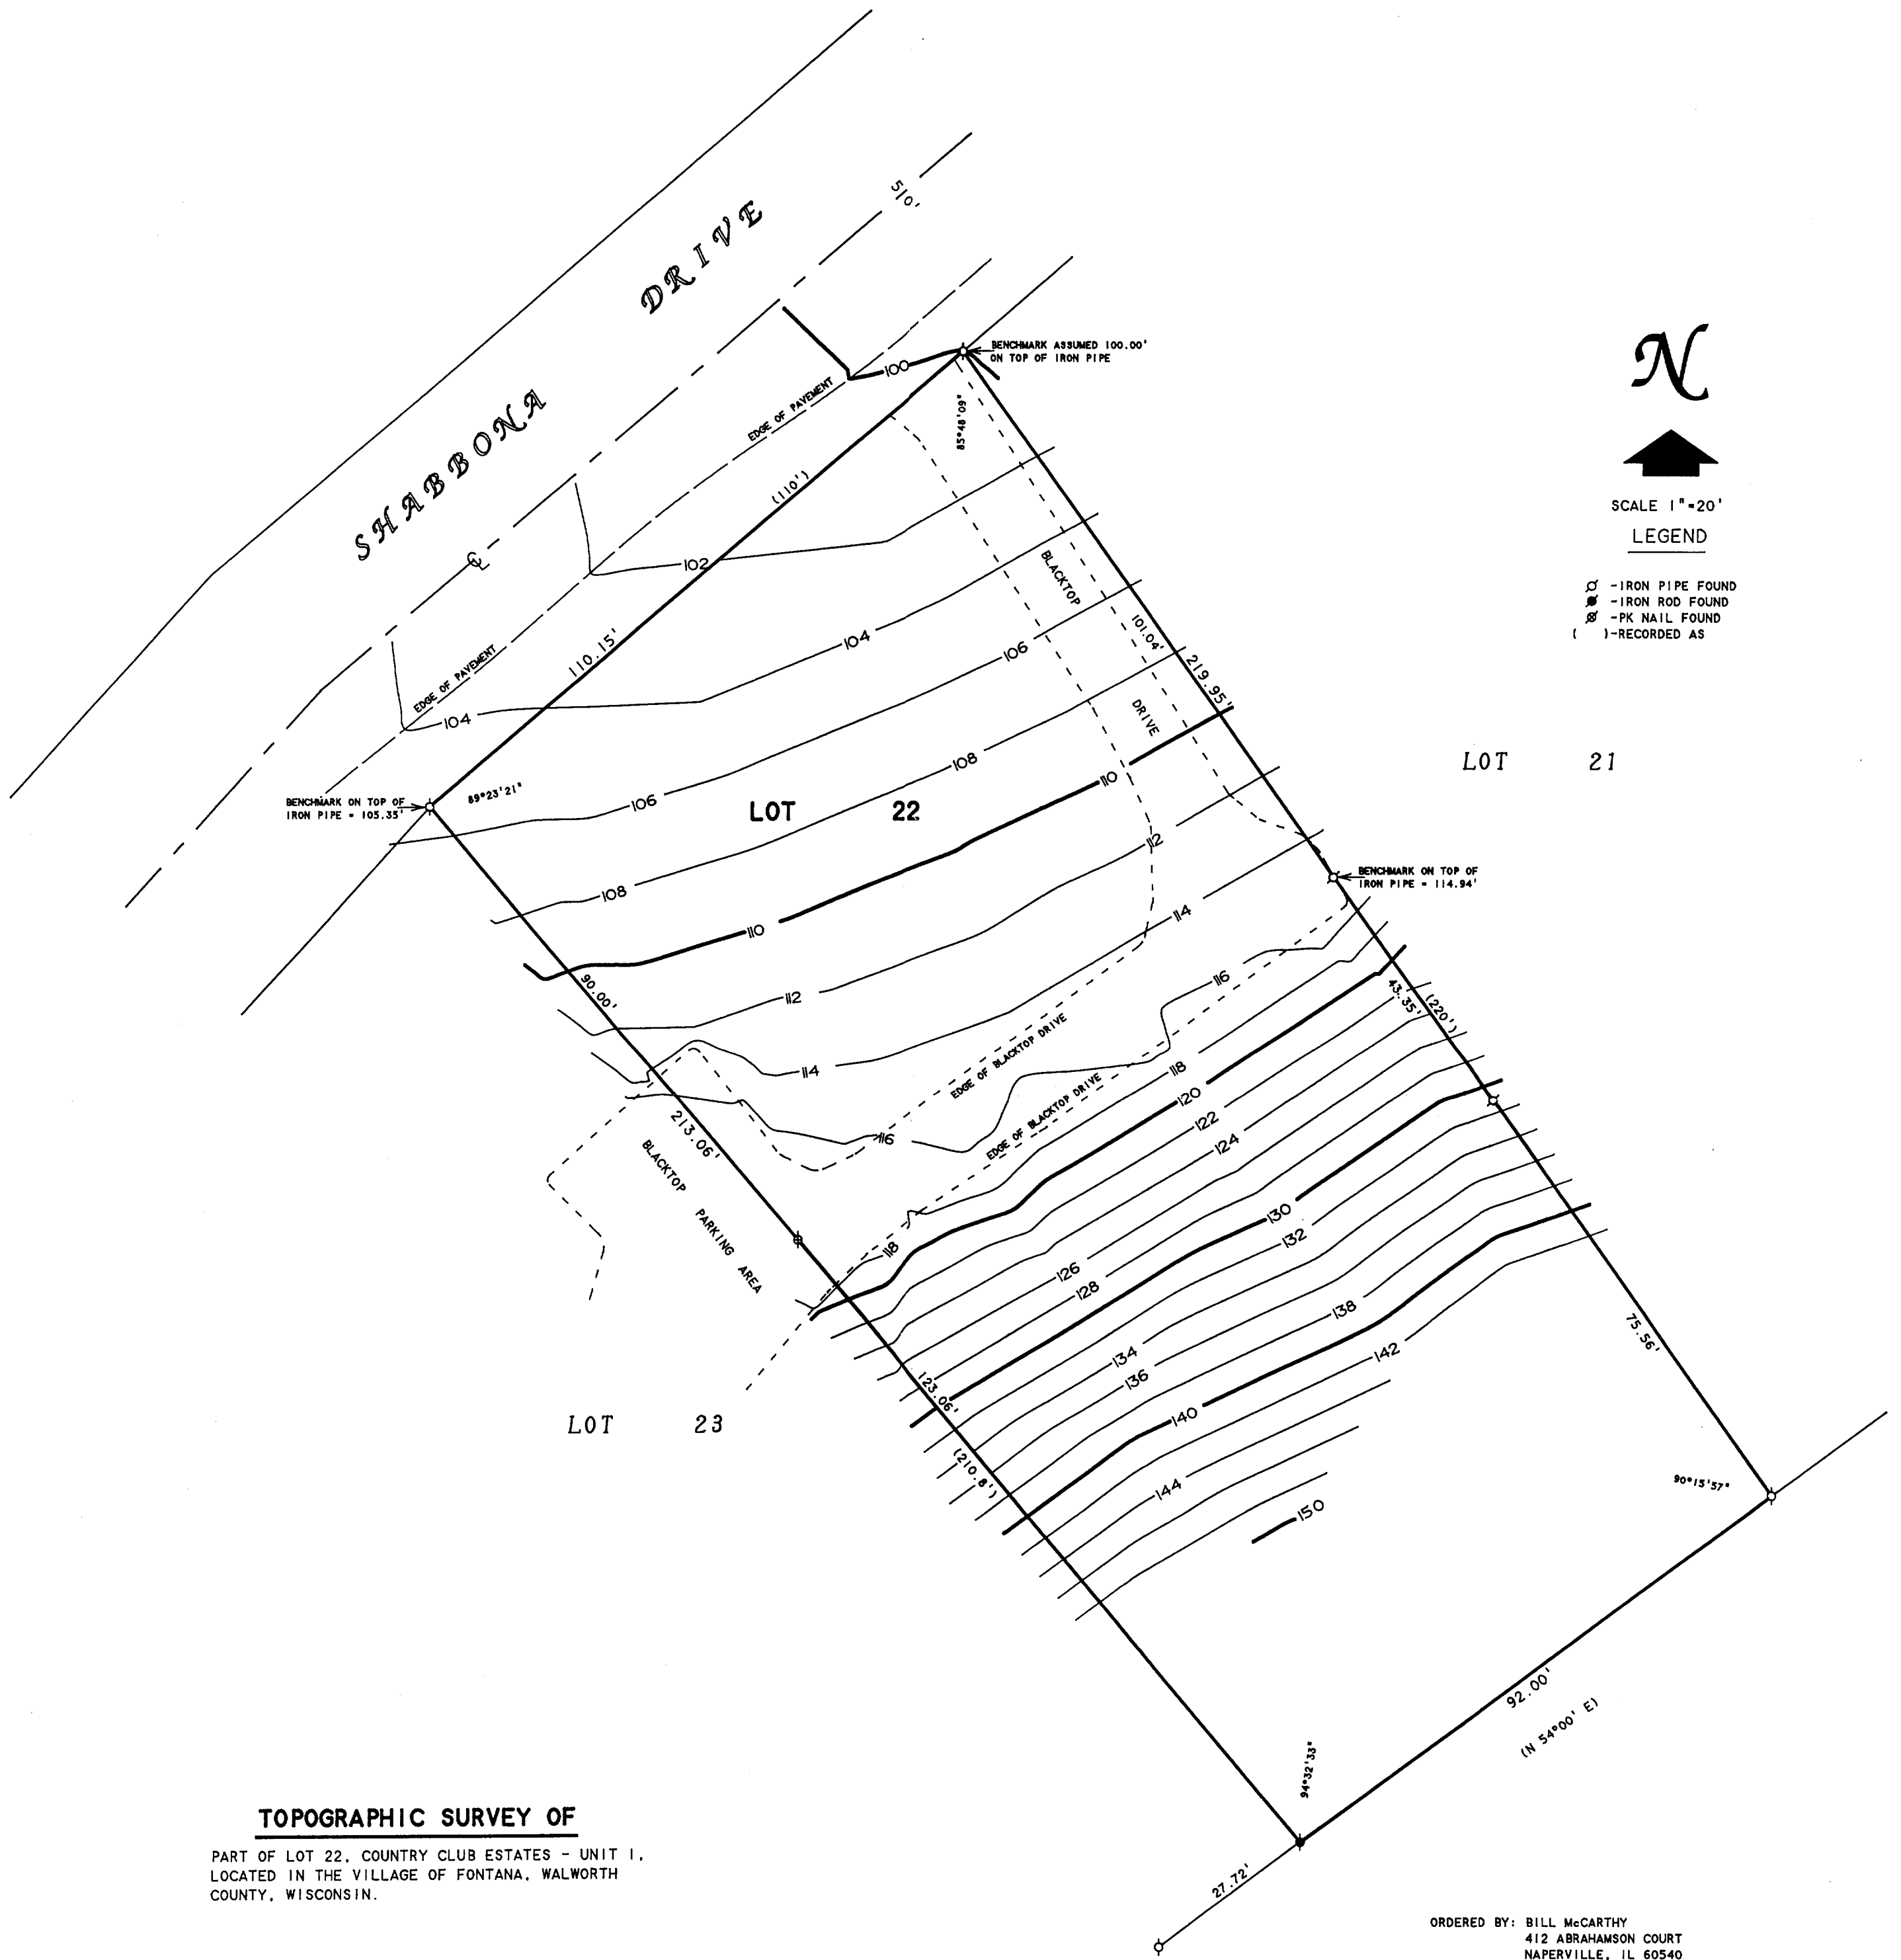

TOPOGRAPHIC SURVEY OF

PART OF LOT 22, COUNTRY CLUB ESTATES - UNIT 1,  
LOCATED IN THE VILLAGE OF FONTANA, WALWORTH  
COUNTY, WISCONSIN.

ORDERED BY: BILL MCCARTHY  
412 ABRAHAMSON COURT  
NAPERVILLE, IL 60540

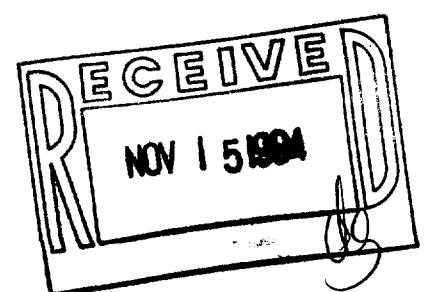

I, DAVID F. ABELL, DO HEREBY CERTIFY THAT I HAVE SURVEYED THE PROPERTY HEREON  
DESCRIBED ACCORDING TO THE OFFICIAL RECORDS AND THAT THE PLAT HEREON IS A  
CORRECT REPRESENTATION OF THE PROPERTY LINES TO THE BEST OF MY KNOWLEDGE AND  
BELIEF.

*David F. Abell*

DAVID F. ABELL  
WISCONSIN REGISTERED LAND SURVEYOR, S-1596

October 17, 1994

DATE: NOVEMBER 15, 1994 JOB NUMBER - 93162  
NOTE: THIS IS NOT A CERTIFIED COPY UNLESS SEALED.