


WALWORTH COUNTY
SURVEYING & MAPPING
727 HENRY STREET
LAKE GENEVA, WISCONSIN
414-248-0505

PLAT OF SURVEY OF
LOTS 4 AND 21 OF STEARNS AND GEROULDS
SUBDIVISION, LOCATED IN THE VILLAGE OF
FONTANA-ON-GENEVA LAKE, WALWORTH
COUNTY, WISCONSIN.

ORDERED BY: RASMUSSEN LAW OFFICES
113 KENOSHA STREET
WALWORTH, WISCONSIN
53184


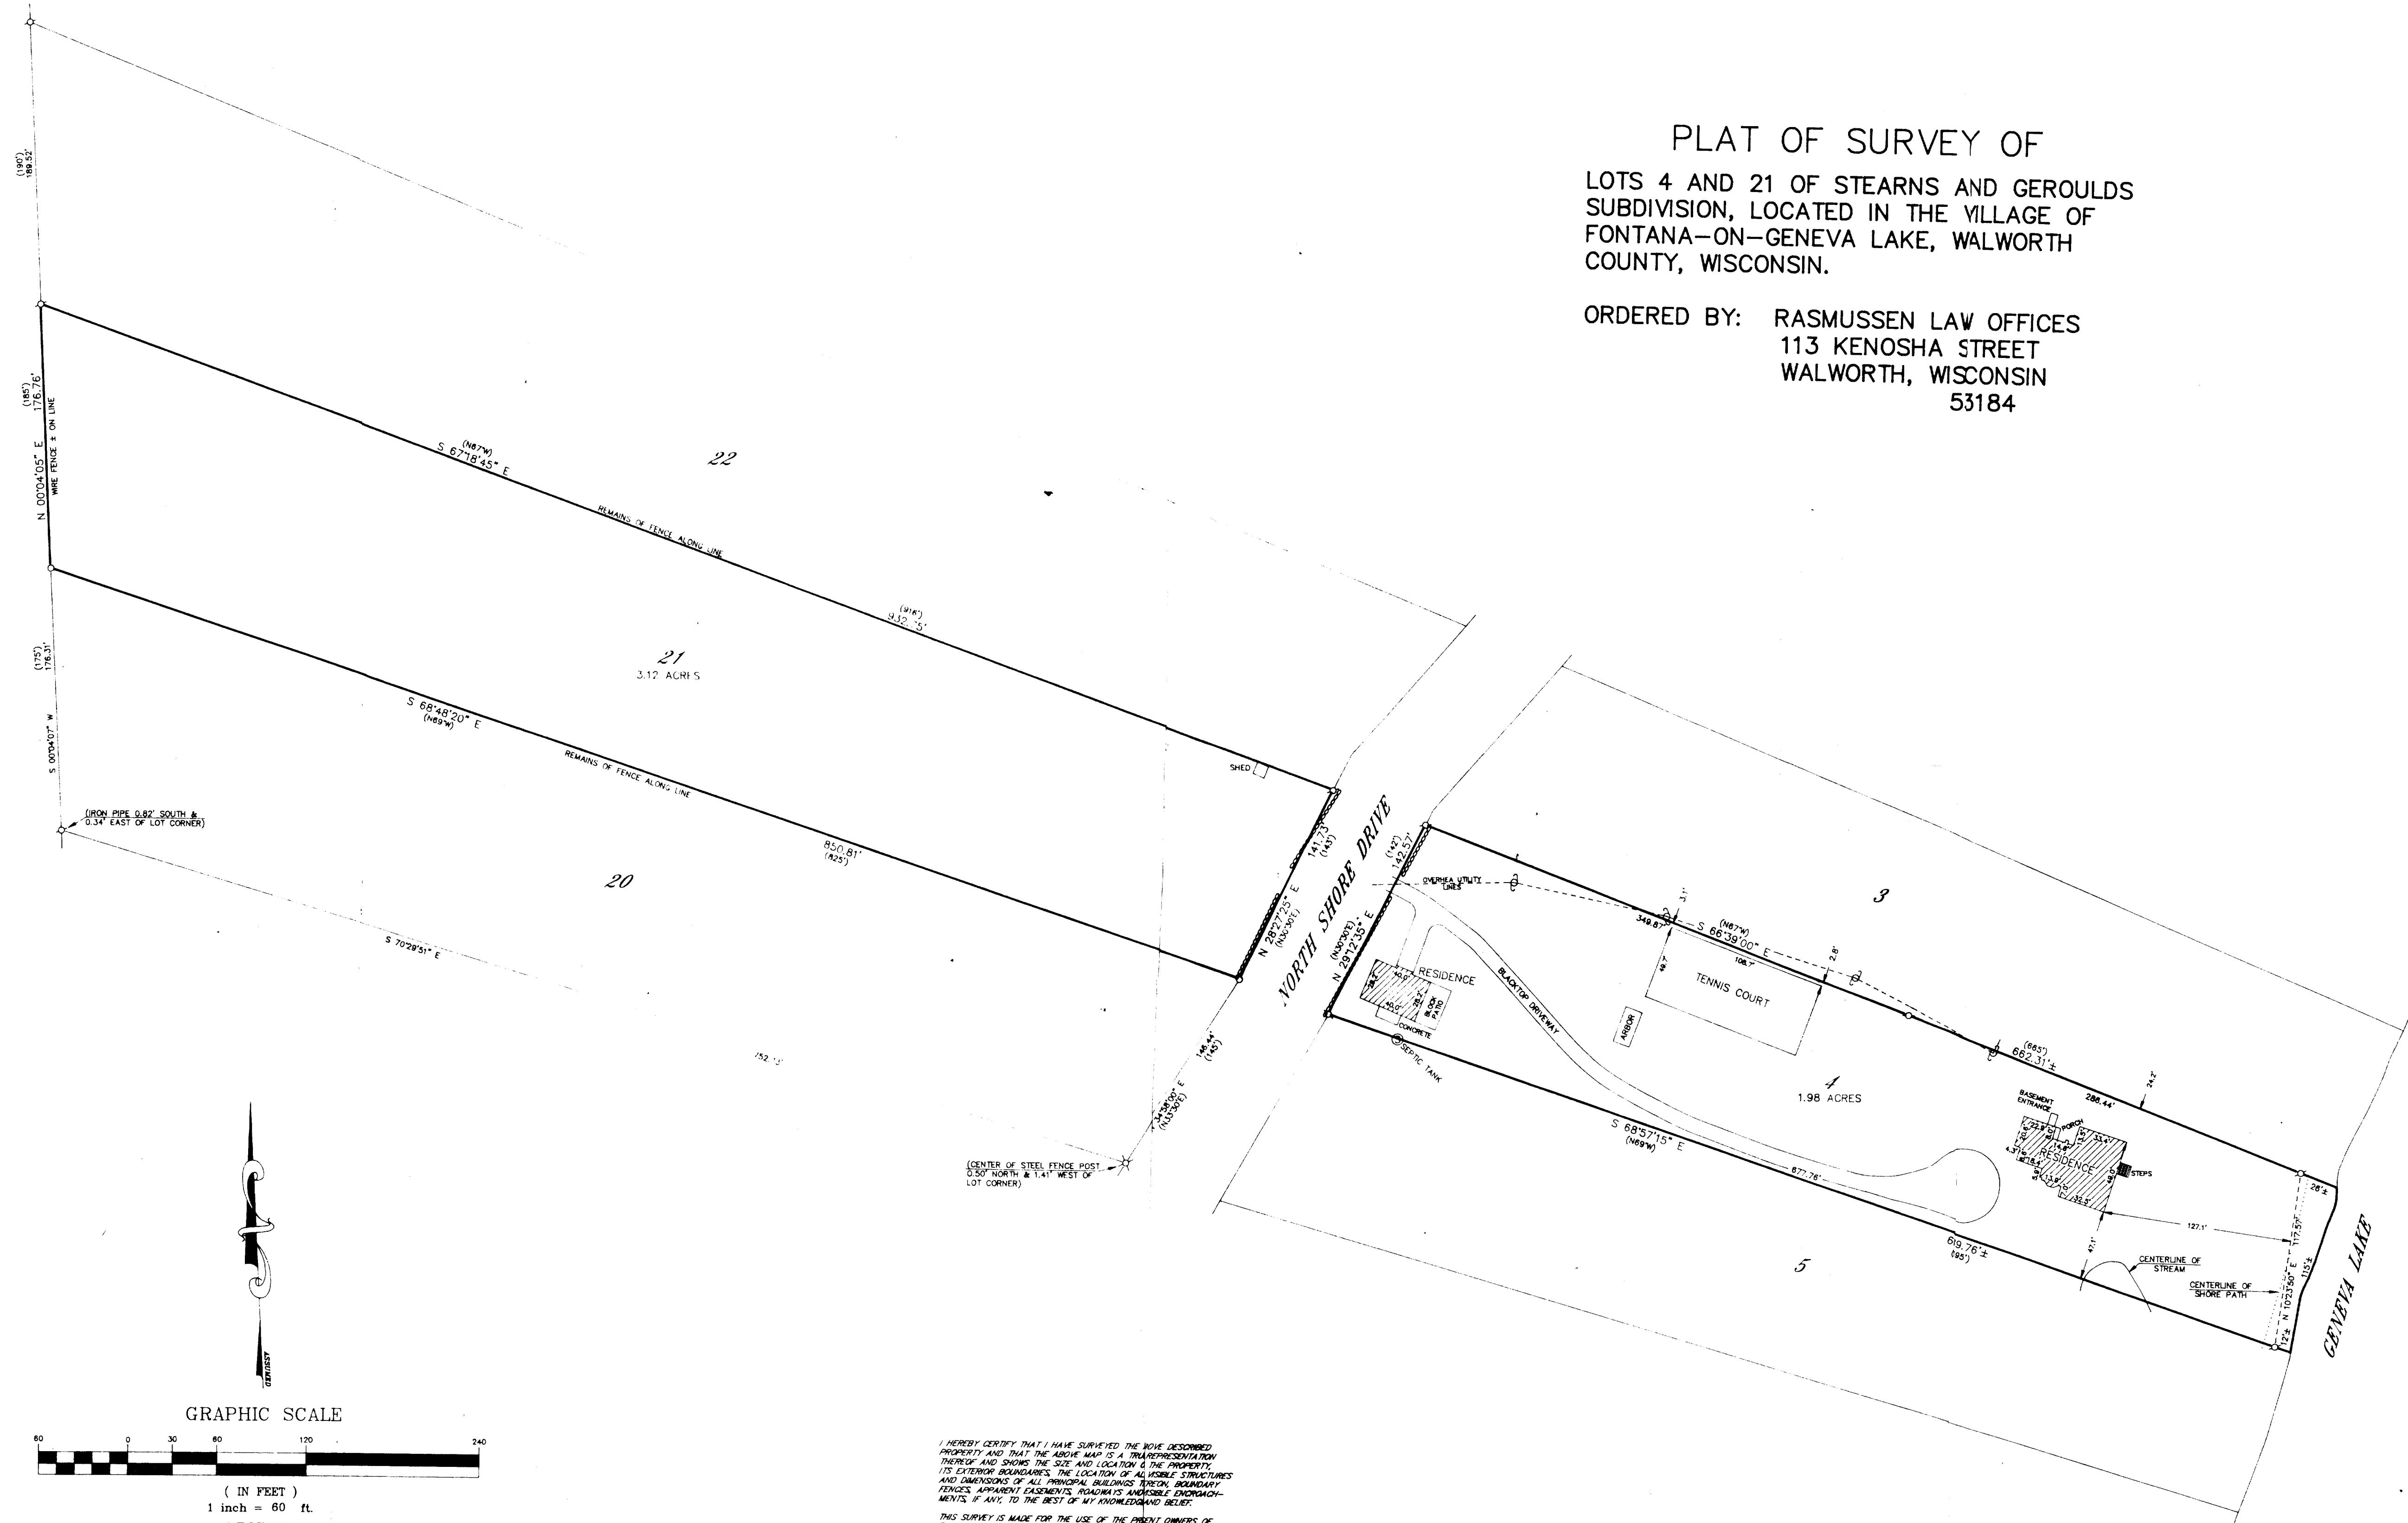


I HEREBY CERTIFY THAT I HAVE SURVEYED THE ABOVE DESCRIBED
PROPERTY AND THAT THE ABOVE MAP IS A TRUE REPRESENTATION
THEREOF AND SHOWS THE SIZE AND LOCATION OF THE PROPERTY,
ITS EXTERIOR BOUNDARIES, THE LOCATION OF ALL VISIBLE STRUCTURES
AND MONUMENTS OF ALL PRINCIPAL BUILDINGS, BOUNDARY
FENCES, APPARENT EASEMENTS, ROADWAYS AND ACCESSIBLE EASEMENTS,
AND ANY, TO THE BEST OF MY KNOWLEDGE AND BELIEF.

THIS SURVEY IS MADE FOR THE USE OF THE PRESENT OWNERS OF
THE PROPERTY AND ALSO THOSE WHO PURCHASE HEREON OF
GUARANTEE THE TITLE THEREON WITHIN ONE (1) YEAR FROM DATE
HEREOF.

Robert M. Rasmussen
ROBERT M. RASMUSSEN
WISCONSIN REGISTERED LAND SURVEYOR, S-1504
DATE: *March 10, 1995*
JOB NO. 4150

NOTE: THIS IS NOT A CERTIFIED COPY UNLESS STATED.

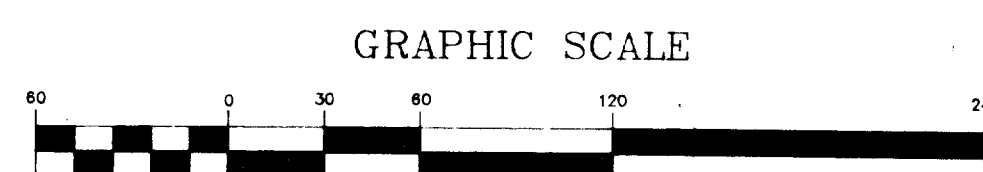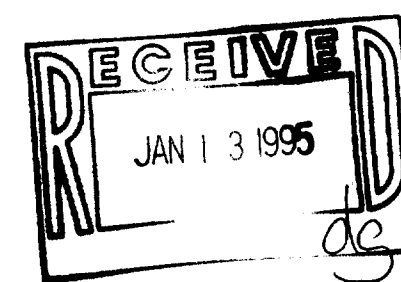

LEGEND
○-IRON PIPE FOUND
●-IRON ROD FOUND
■-CONCRETE MONUMENT FOUND
○-IRON PIPE PLACED
○-RECORDED AS
○-UTILITY POLE
---STONE WALL

SS+G-4
SS+G-14