

DUNHAM SURVEYING, S.C.
SURVEYING & SUBDIVIDING
DELAVER, WISCONSIN 53115

N

Scale - 1" = 20'

• = Concrete Monument Found
o = 1" Iron Pipe Found

Bearings referenced to the assumed bearing of
N5°30'W along the easterly line of Lot 14

Survey ordered by:

James D. Rich

839 Van Slyke Drive

Country Club Estates

Fontana, WI 53125

(0.00) = recorded distance


Updating and recertification on November 29, 1993

ordered by: Richard Rasmussen

Attorney at Law

113 Kenosha Street

Walworth, WI 53184

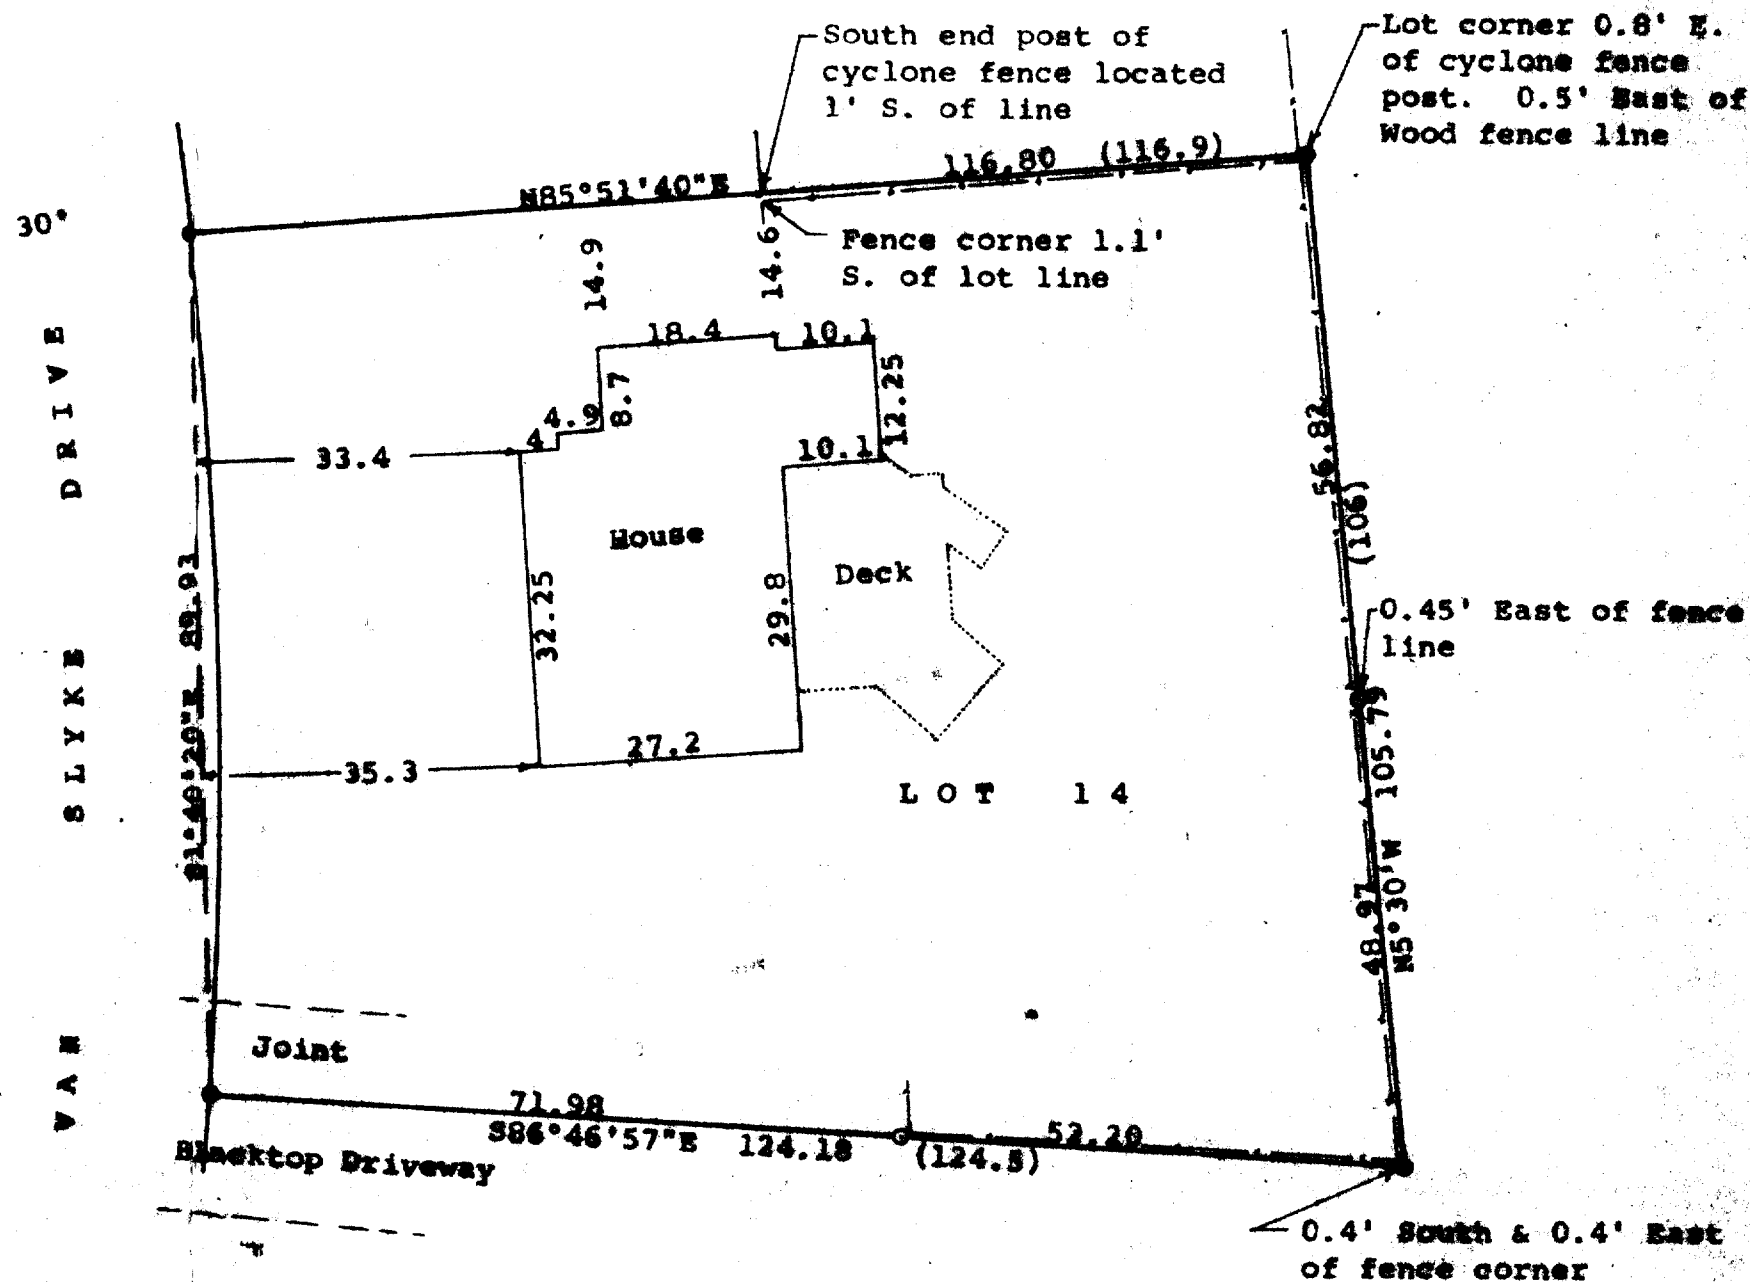

STATE OF WISCONSIN) ss
COUNTY OF WALNORTH)

I, George T. Dunham, Surveyor, certify that I have surveyed the property described as follows:

Lot 14 in Block "E", Country Club Estates Unit No. 3, located in the Village of Fontana-on-Geneva Lake, Walworth County, Wisconsin, and that the plat shown hereon is a correct representation thereof and shows the size and location of the property, its exterior boundaries, the location of all visible structures and dimensions of all principal buildings thereon, boundary fences, apparent easements, roadways and visible encroachments, if any, and that I have surveyed the property hereon described, according to the official records, to the best of my knowledge and belief.

September 9, 1991

Updated and recertified to
this 29th day of November,
1993

George T. Dunham
George T. Dunham, Surveyor

