


DUNHAM SURVEYING, S.C.
SURVEYING & SUBDIVIDING
DELAVER, WISCONSIN 53115

N

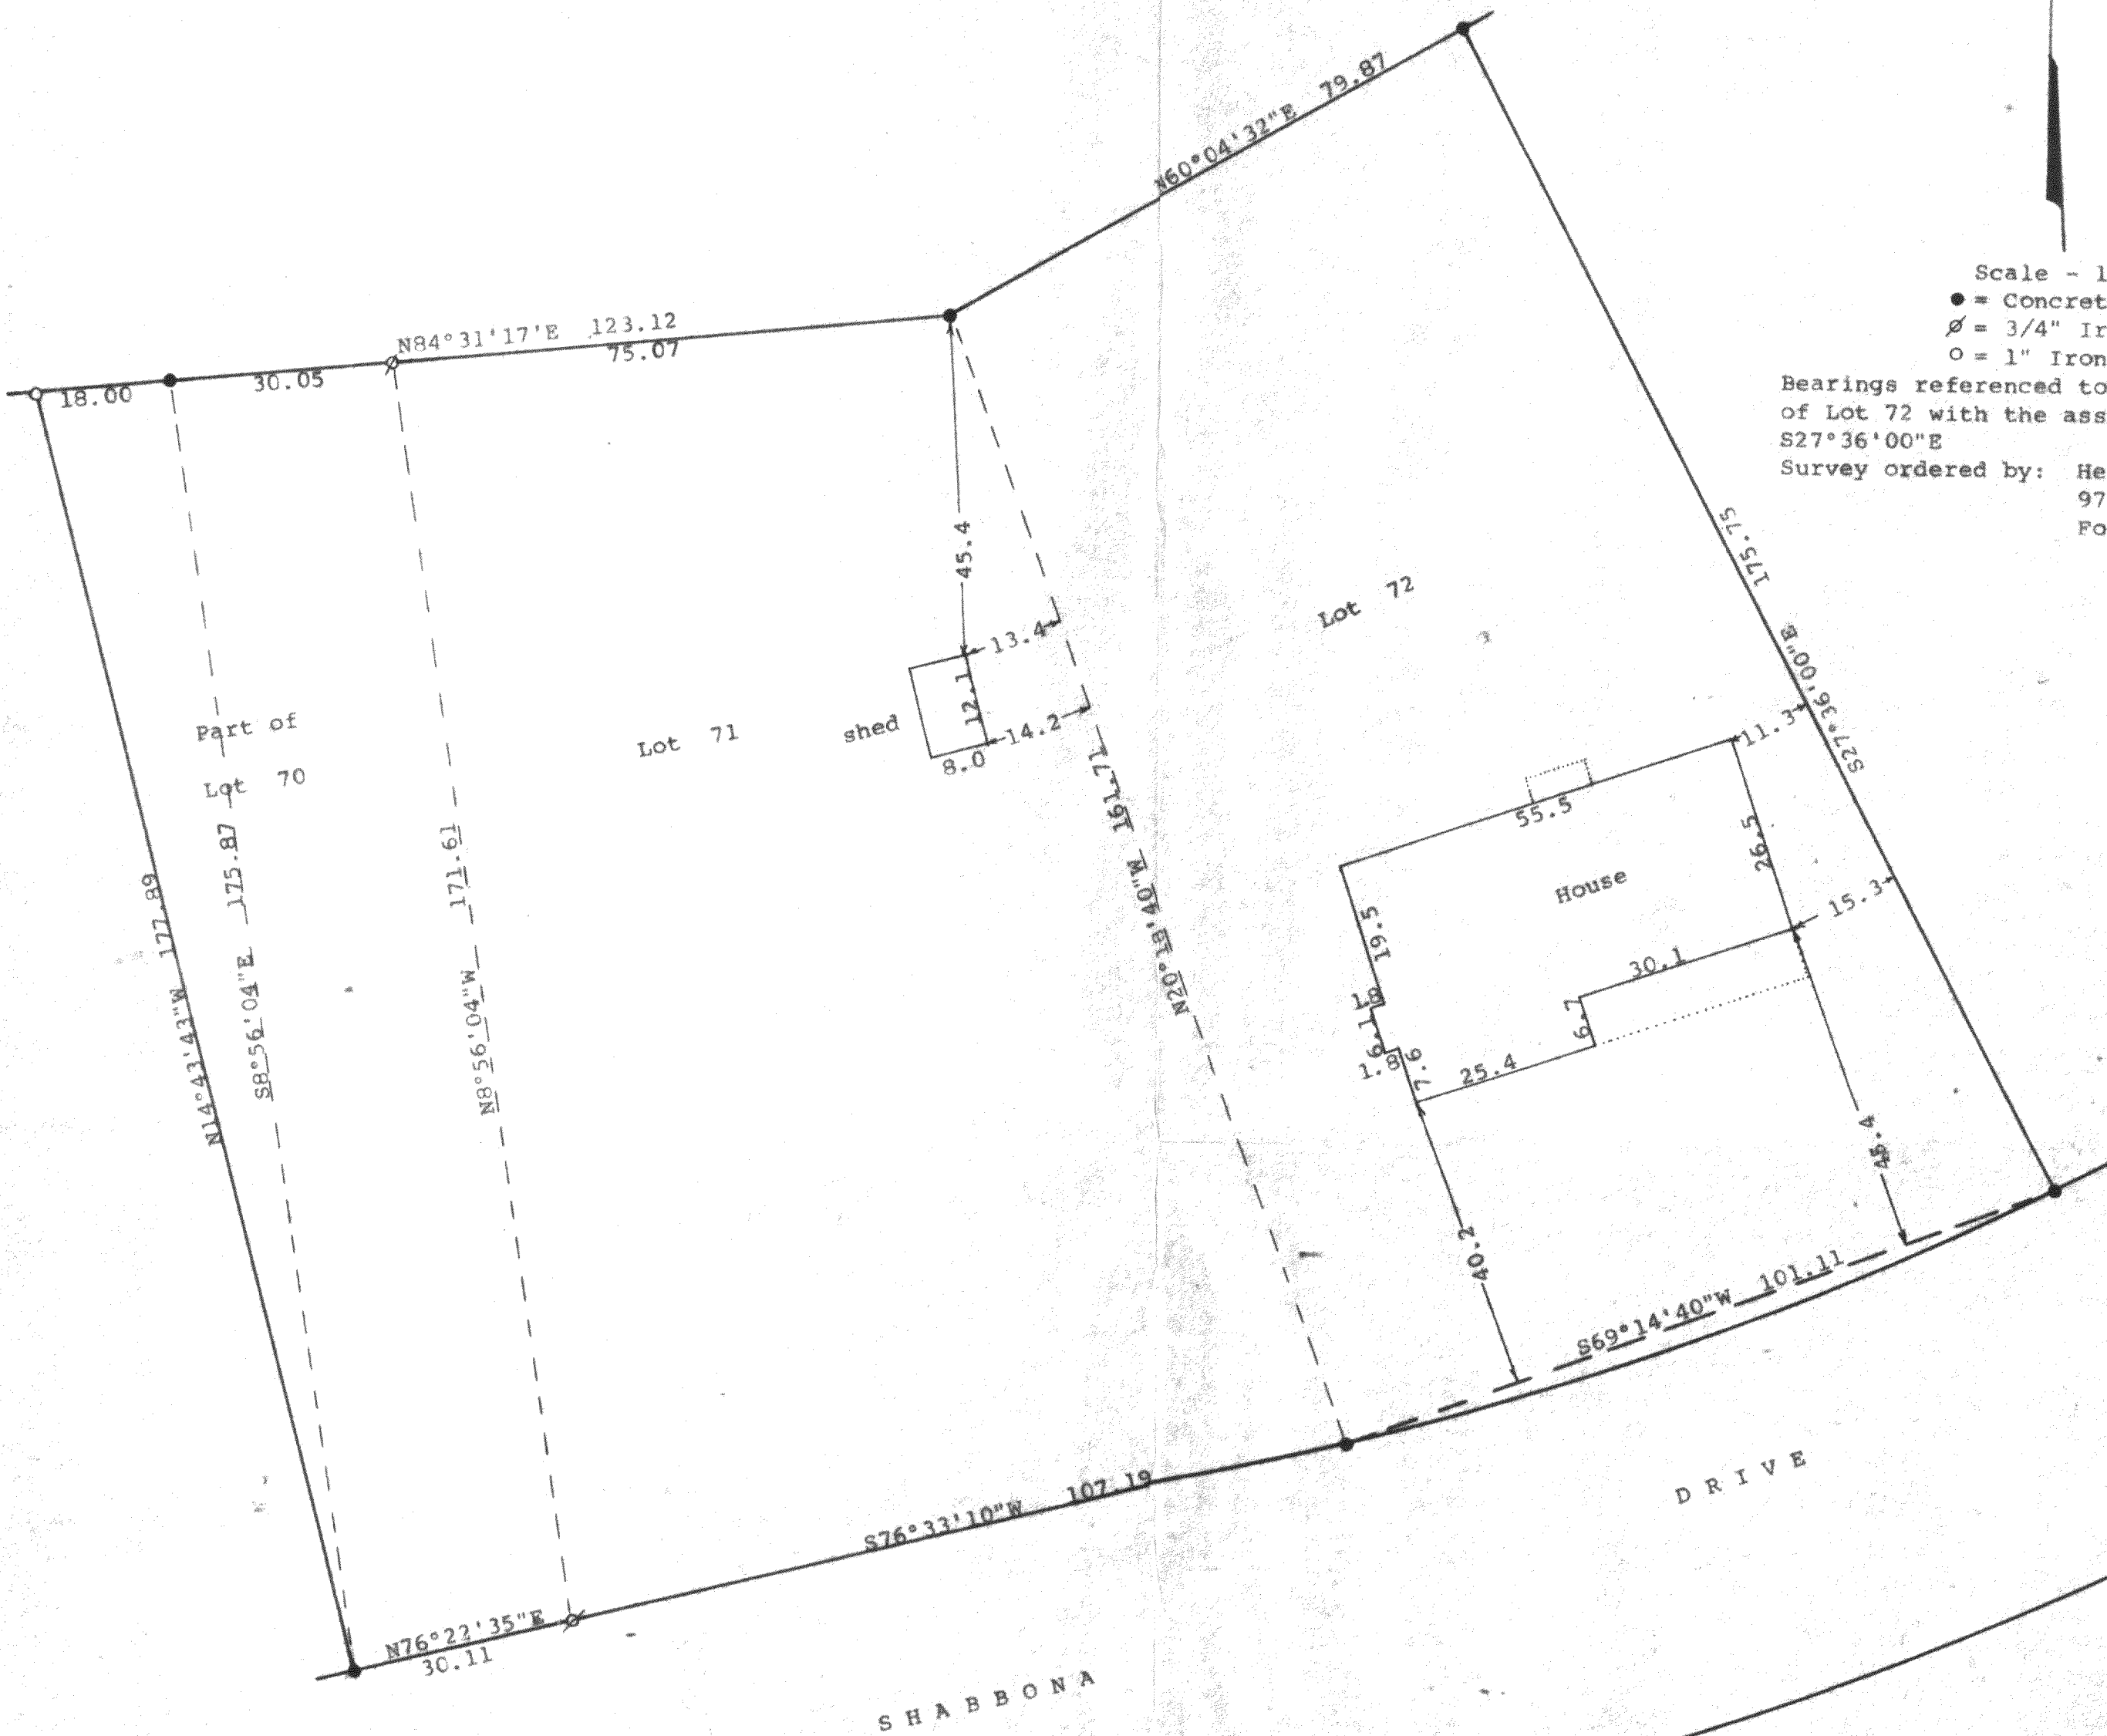

Scale - 1" = 20'

● = Concrete Monument Found
Ø = 3/4" Iron Pipe Found
○ = 1" Iron Pipe Found

Bearings referenced to the easterly line of Lot 72 with the assumed bearing of S27°36'00"E

Survey ordered by: Helen Slopa
970 Shabbona Drive
Fontana, WI 53125

STATE OF WISCONSIN) ss
COUNTY OF WALWORTH)



I, George T. Dunham, Surveyor, certify that I have surveyed the property described as follows:

Lots 71 and 72, Unit No. 2, Country Club Estates, Village of Fontana-on-Geneva Lake, Walworth County, Wisconsin, ALSO the East 30 feet of Lot 70, Unit No. 2, Country Club Estates, Village of Fontana-on-Geneva Lake, Walworth County, Wisconsin, which 0 foot wide strip shall be bounded on the West by a line parallel with the east line of said Lot, ALSO Part of Lot 70, Unit No. 2, Country Club Estates described as: Commencing at the southwest corner of the East 30 feet of Lot 70; thence Northerly along the west line of said East 30 feet of Lot 70 to the north line of said Lot 70; thence westerly along the northerly line of said Lot 70, 18.00 feet; thence southeasterly on a straight line to the place of beginning.

and that the plat shown hereon is a correct representation thereof and shows the size and location of the property, its exterior boundaries, the location of all visible structures and dimensions of all principal buildings thereon, boundary fences, apparent easements, roadways and visible encroachments, if any, and that I have surveyed the property hereon described, according to the official records, to the best of my knowledge and belief.

August 17 and February 5, 1993
Plat drawn January 26, 1994

George T. Dunham
George T. Dunham, Surveyor

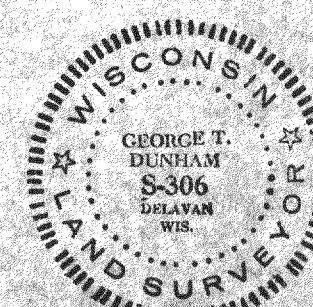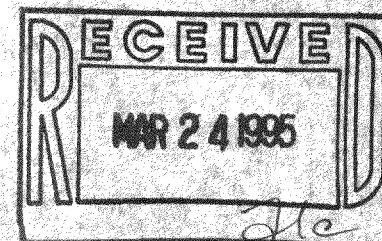

5002-68
5002-67

005-1449