



PLAT OF SURVEY

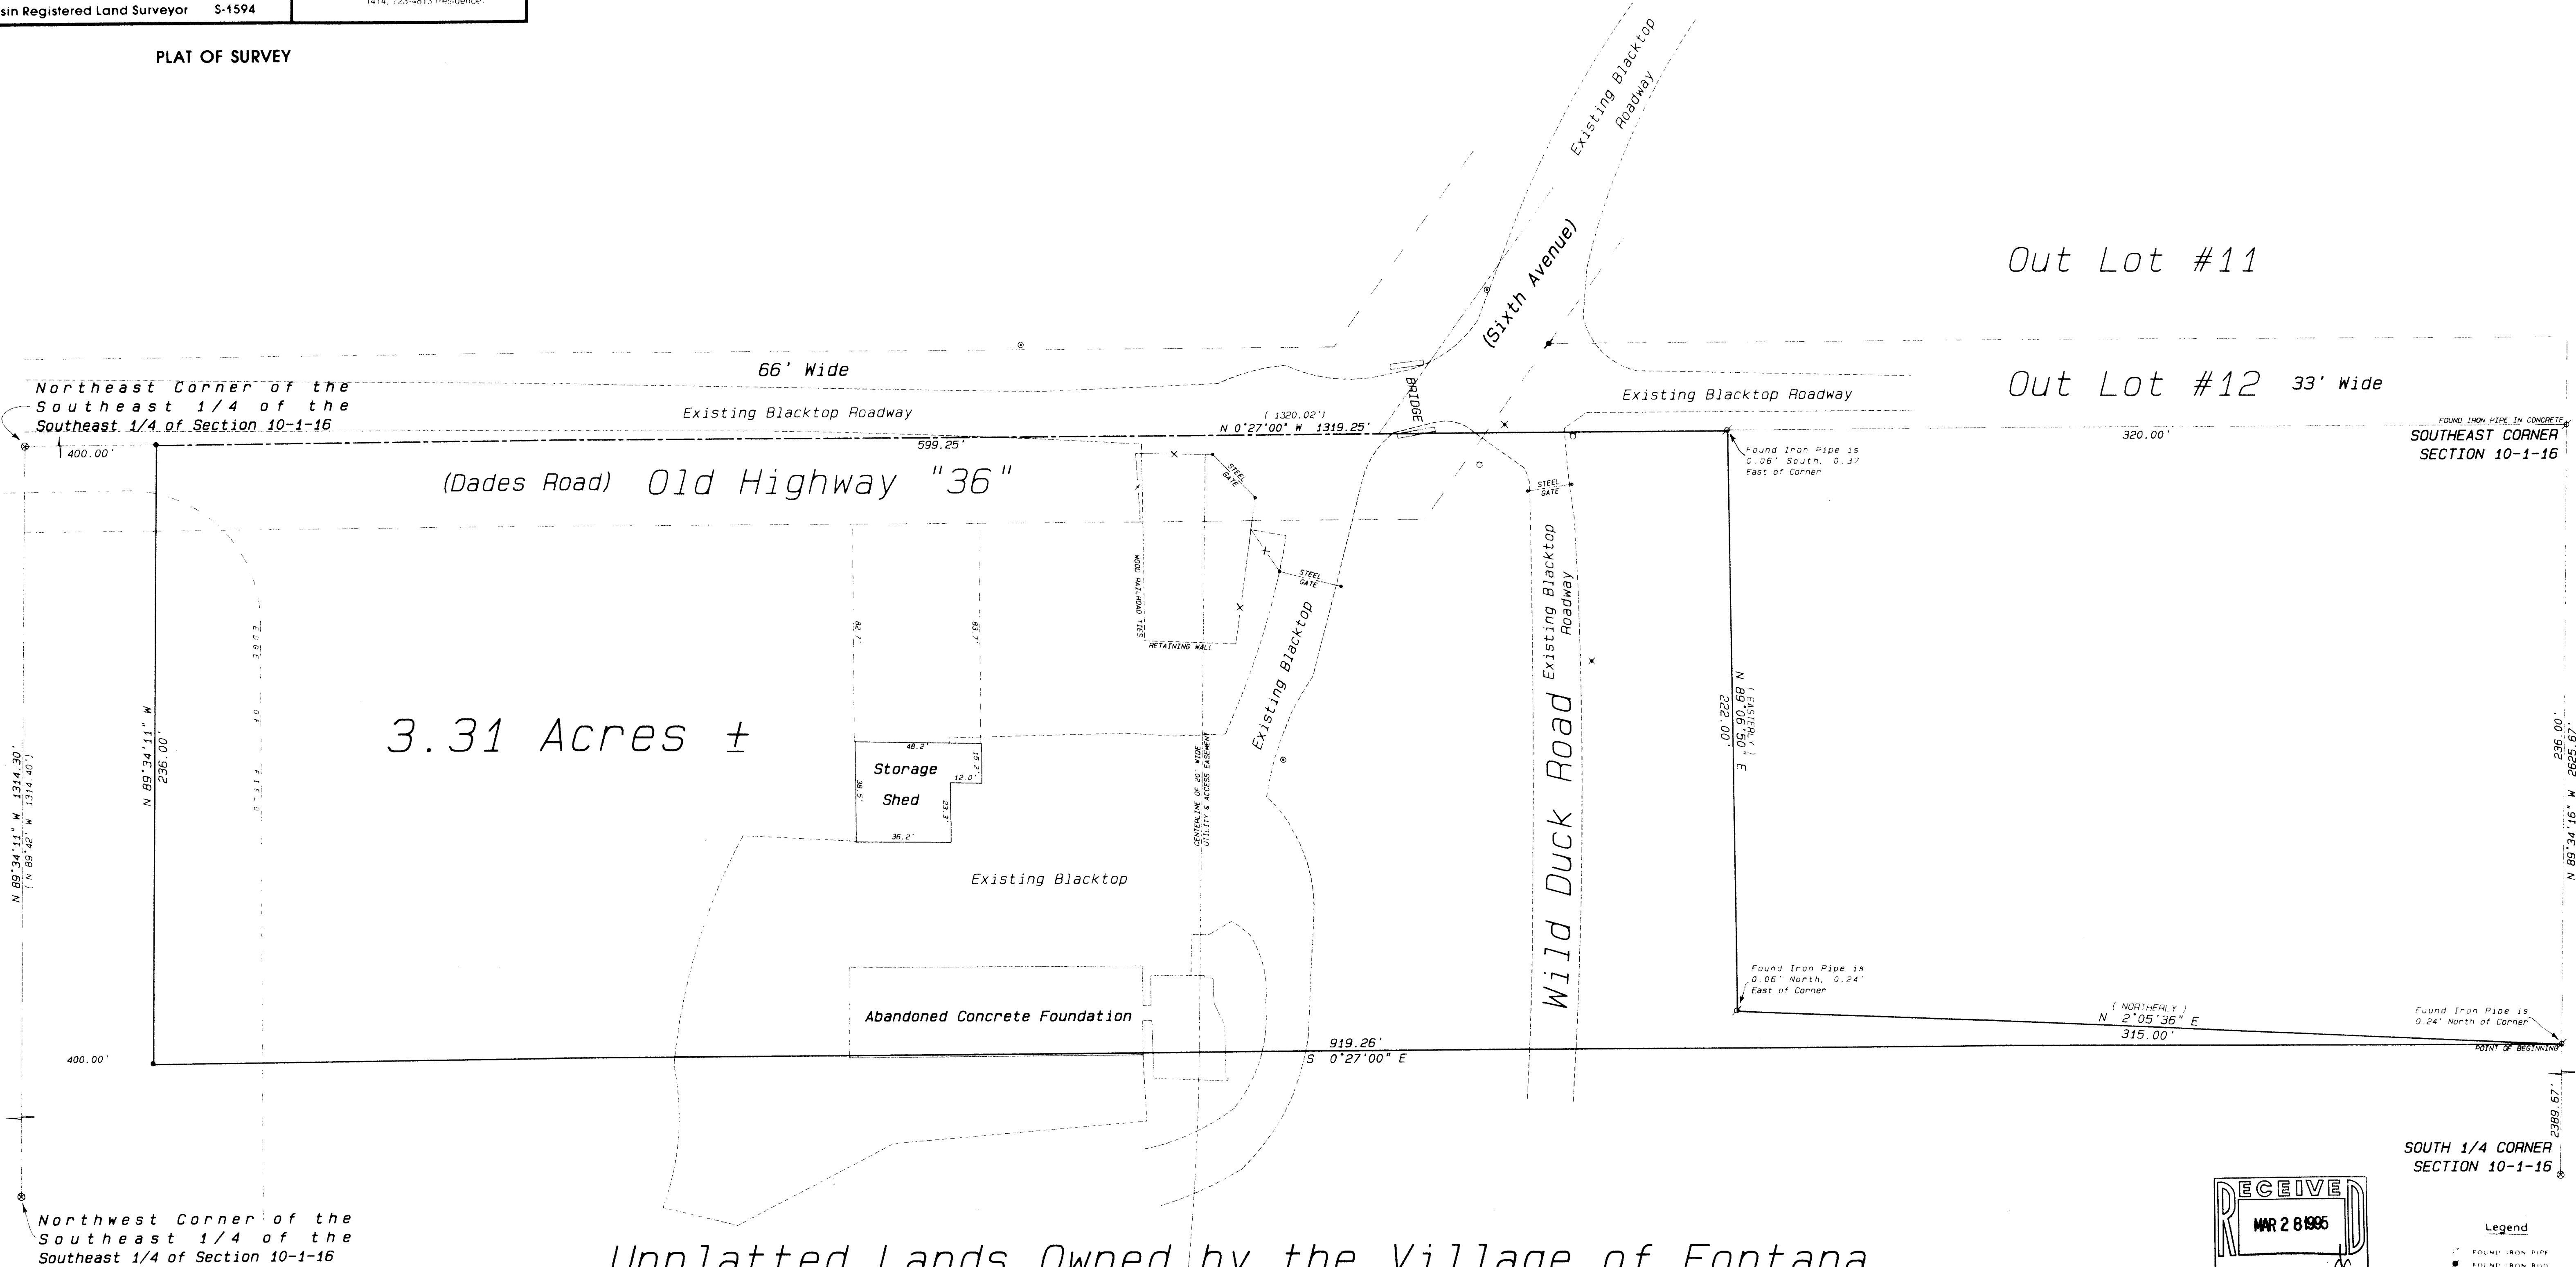

Legal Description
A parcel of land located in part of the East 1/2 of the Southeast 1/4 of the Southeast 1/4 of Section 10, Town 1 North, Range 16 East, Town of Walworth, County of Walworth, State of Wisconsin, described as follows, to-wit:
Commence at the Southeast Corner of said Section 10, thence N 89°34'16" W (recorded as N 89°40' W) along the South Line of said Section 10 236.00 feet to the point of beginning; thence N 2°05'36" E (recorded as Northerly) 315.00 feet; thence N 89°06'50" E (recorded as Easterly) 222.00 feet to a point on the East Line of said Section 10; thence N 0°27'00" W along the East Line of said Section 10 599.25 feet; thence N 89°34'11" W (recorded as N 89°42' W) parallel to the North Line of the Southeast 1/4 of the Southeast 1/4 of said Section 10 (as monumented) 236.00 feet; thence S 0°27'00" E parallel to the East Line of said Section 10 919.26 feet to the point of beginning. Said parcel contains 3.31 Acres of land more or less.

Ordered by: Attorney Dale L. Thorpe
Godfrey, Neshek, Worth, & Leibsle SC
11 North Wisconsin Street
Post Office Box 260
Elkhorn, Wisconsin 53121


Owner: Village of Fontana

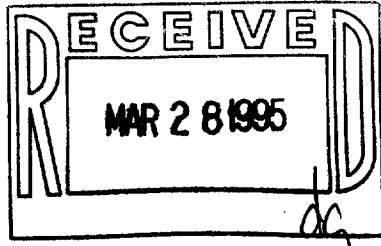

- Legend**
- FOUND IRON PIPE
 - FOUND IRON ROD
 - FOUND BRASS-CAPPED MONUMENT
 - FOUND CONCRETE MONUMENT
 - CHISEL CUT IN CONCRETE
 - SET IRON ROD 24" LONG WEIGHING 15 LBS. LINEAL FT. 1 1/4" DIA.
 - SET IRON ROD 10" LONG WEIGHING 4.5 LBS. LINEAL FT. 1 1/4" DIA.
 - RECORDED AS DIMENSION
 - - - EXISTING FENCE
 - UTILITY POLE
 - FIRE HYDRANT
 - WATER STOP BOX



SCALE: 1"= 30 FEET

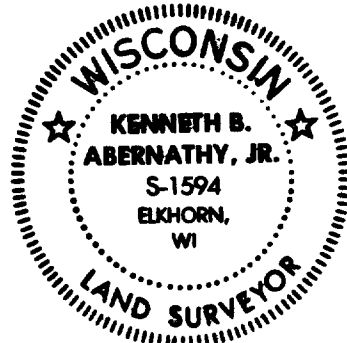

I hereby certify that the above described property has been surveyed by me in accordance with the laws of the State of Wisconsin, and that the above map is a true and correct representation of the survey and the boundaries of the property described hereon. The nature of the survey and the boundaries of the property described hereon are as shown on the map and the boundaries of the property described hereon are as shown on the map.

KENNETH B. ABERNATHY, JR.
WISCONSIN REGISTERED LAND SURVEYOR,
S-1594

Date: March 16, 1995 Job No. 1995-208