

CONSULTING ENGINEERS & LAND SURVEYORS


PHONE (414) 763-2652

116 E. CHESTNUT ST.

BURLINGTON, WIS. 53105

PLAT OF SURVEY

LOTS 5 & 6, BLOCK 7, FIRST ADDITION TO INDIAN HILLS SUBDIVISION,
FONTANA-ON-GENEVA, WALWORTH COUNTY, WISCONSIN

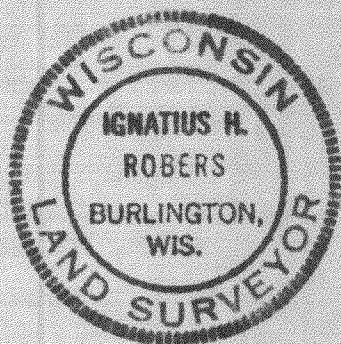

SCALE 1"=30'


- SIP SET IRON PIPE
- FIP FOUND IRON PIPE

CURVE DATA

Δ 16° 32'
R = 721.58
C C 207.32'

CURVE DATA FOR
C OF ROAD

ADSLA WAY 20' ROW

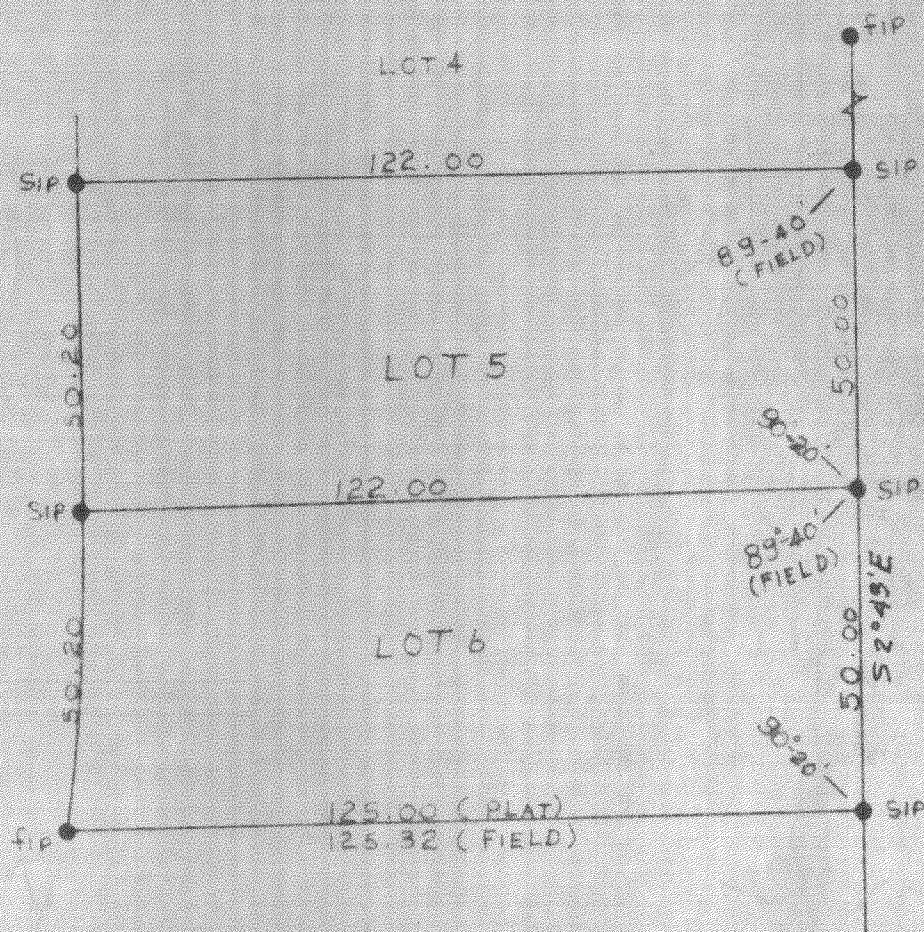

I HEREBY CERTIFY THAT WE HAVE SURVEYED THE LANDS DESCRIBED
ABOVE ACCORDING TO OFFICIAL RECORDS AND THAT THE PLAT
DRAWN HEREON IS A CORRECT REPRESENTATION OF SAID SURVEY.

WIS. REG. LAND SURVEYOR

DATE 9-3-70

JOB NO. 70123

500787

5-146