

ROBERS & FISCHER, INC.

CONSULTING ENGINEERS & LAND SURVEYORS


PHONE (414) 763-2652

116 E. CHESTNUT ST.

BURLINGTON, WIS. 53105

The N 20' of Lot 1, Block 1, DA. Reid's Add.

Fontana-on-Geneva, Wisconsin County, Wisconsin

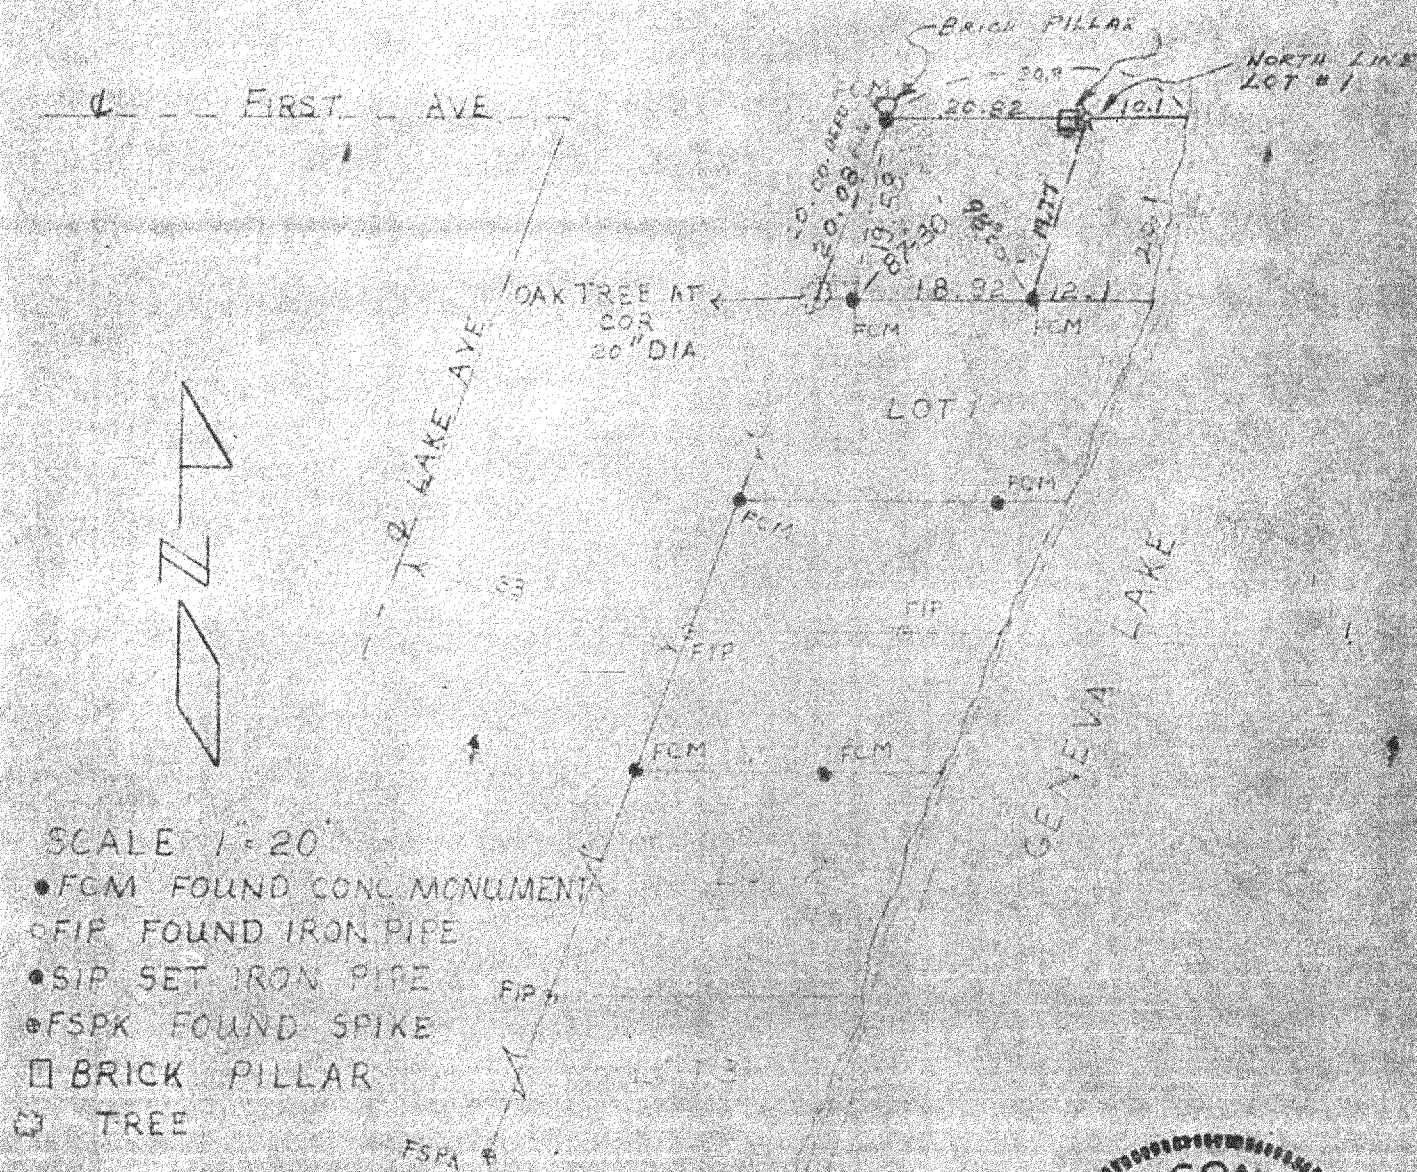

I HEREBY CERTIFY THAT WE HAVE SURVEYED THE LANDS DESCRIBED ABOVE ACCORDING TO OFFICIAL RECORDS AND THAT THE PLAT DRAWN HEREON IS A CORRECT REPRESENTATION OF SAID SURVEY.

Charles R. Fischer
WIS. REG. LAND SURVEYOR

DATE *July 30, 1970*

5-148

JOB NO. *70109*

SRA-4