



LOT 7, CLUB UNIQUE, being a Subdivision in the Southeast 1/4 of Fractional Section 14, Town North, Range 16 East, Village of Fontana, Walworth County, Wisconsin.

Survey address: 681 Cherry Drive

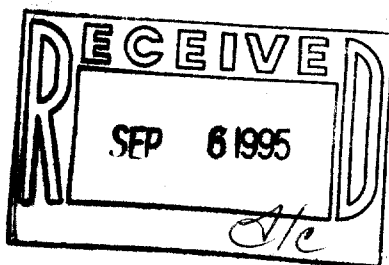

- FOUND 3/4" IRON PIPE
- FOUND 3/4" IRON ROD
- SET P.K. NAIL
- () PLATTED AS

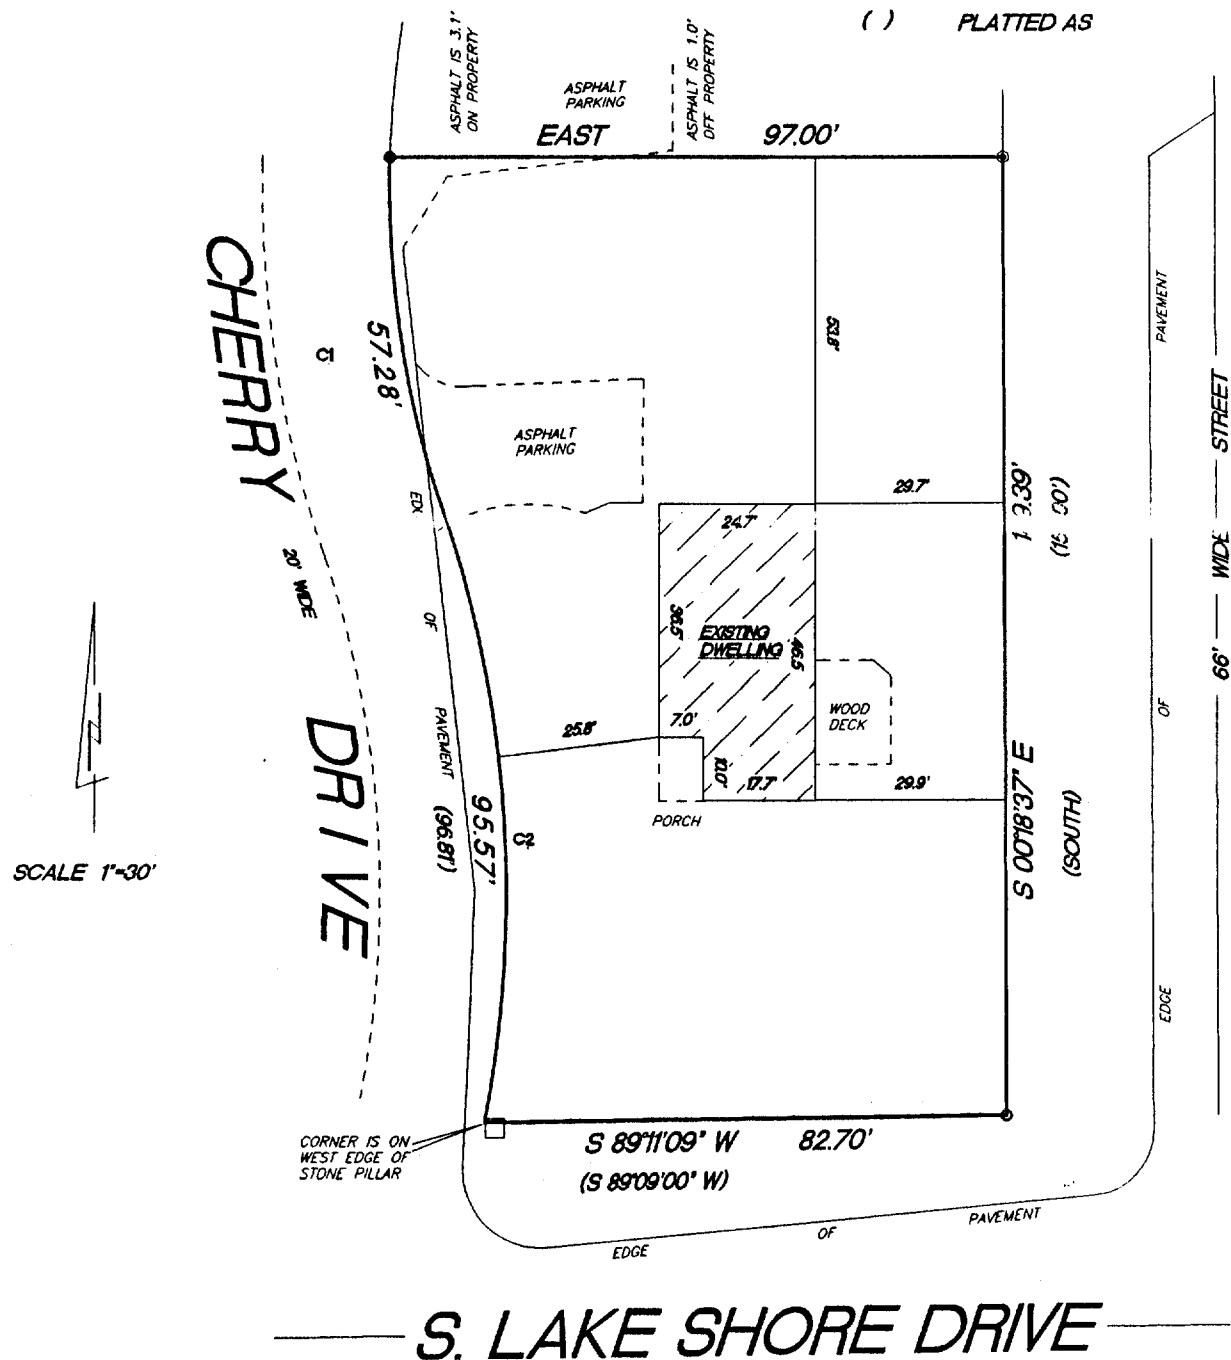

CURVE	RADIUS	LENGTH	CHORD	BEARING	DELTA
C1	153.20'	57.28'	58.96'	S 09°00'32" E	27°00'34"
C2	184.90'	93.57'	94.51'	N 03°45'38" W	29°36'57"

"This survey is made for the use of the present owners of the property, and also those who purchase, mortgage or guarantee the title thereto within one year from date hereof."

THIS IS NOT AN ORIGINAL SURVEY UNLESS THE SEAL IS RED.

DATE _____

FIELD WORK BY

DRAWN BY

JOB NUMBER

SCB-7

005-1490